MANCANA REEFS Coy

NEW SOVEREIGN C. M.

Scale 25 ft. to 1 in.

Certified correct copy of work done to date & 11th Feb 1898 also Jan 30th 1899

E. Benifly Watkins
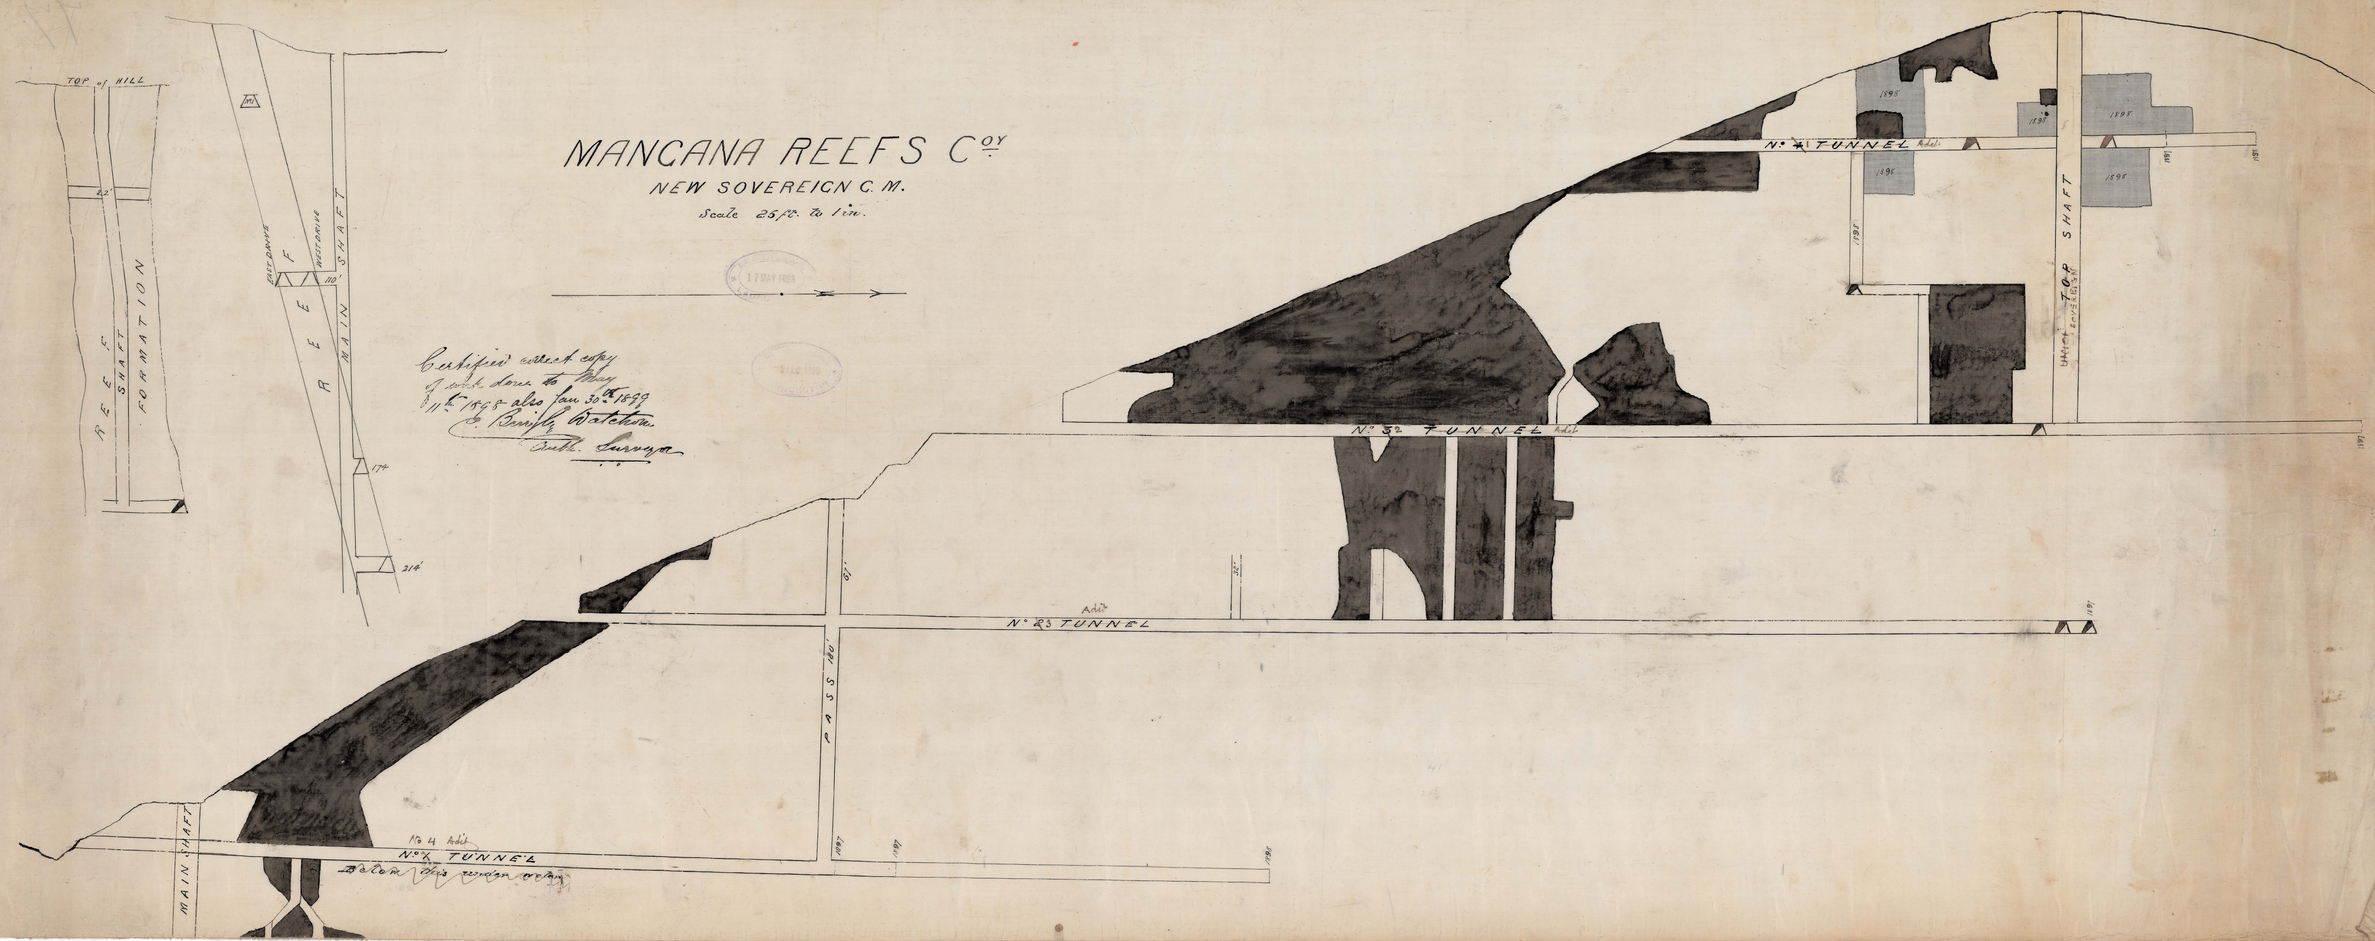
Chief Surveyor