


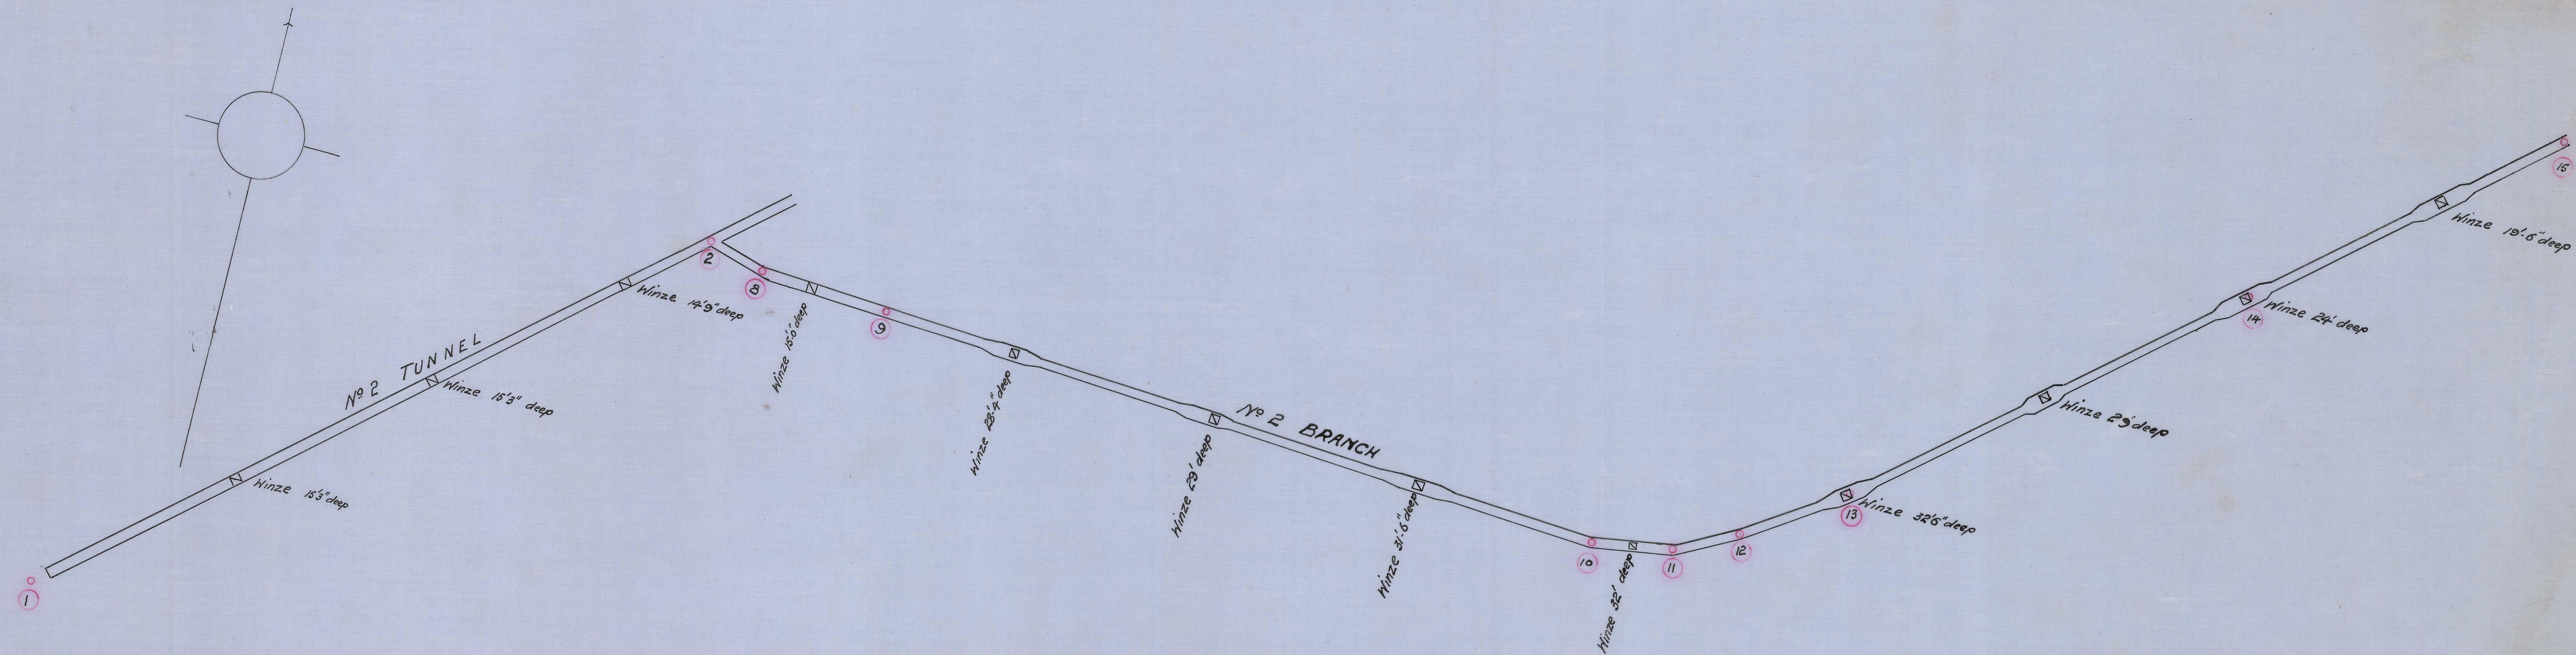

— THE BRISEIS TIN AND GENERAL M. CO. LTD —

— UNDERGROUND WORKINGS —

MARCH 09

— SCALE 40 FT = 1 IN —

See plan sent March 08
J. J. J.