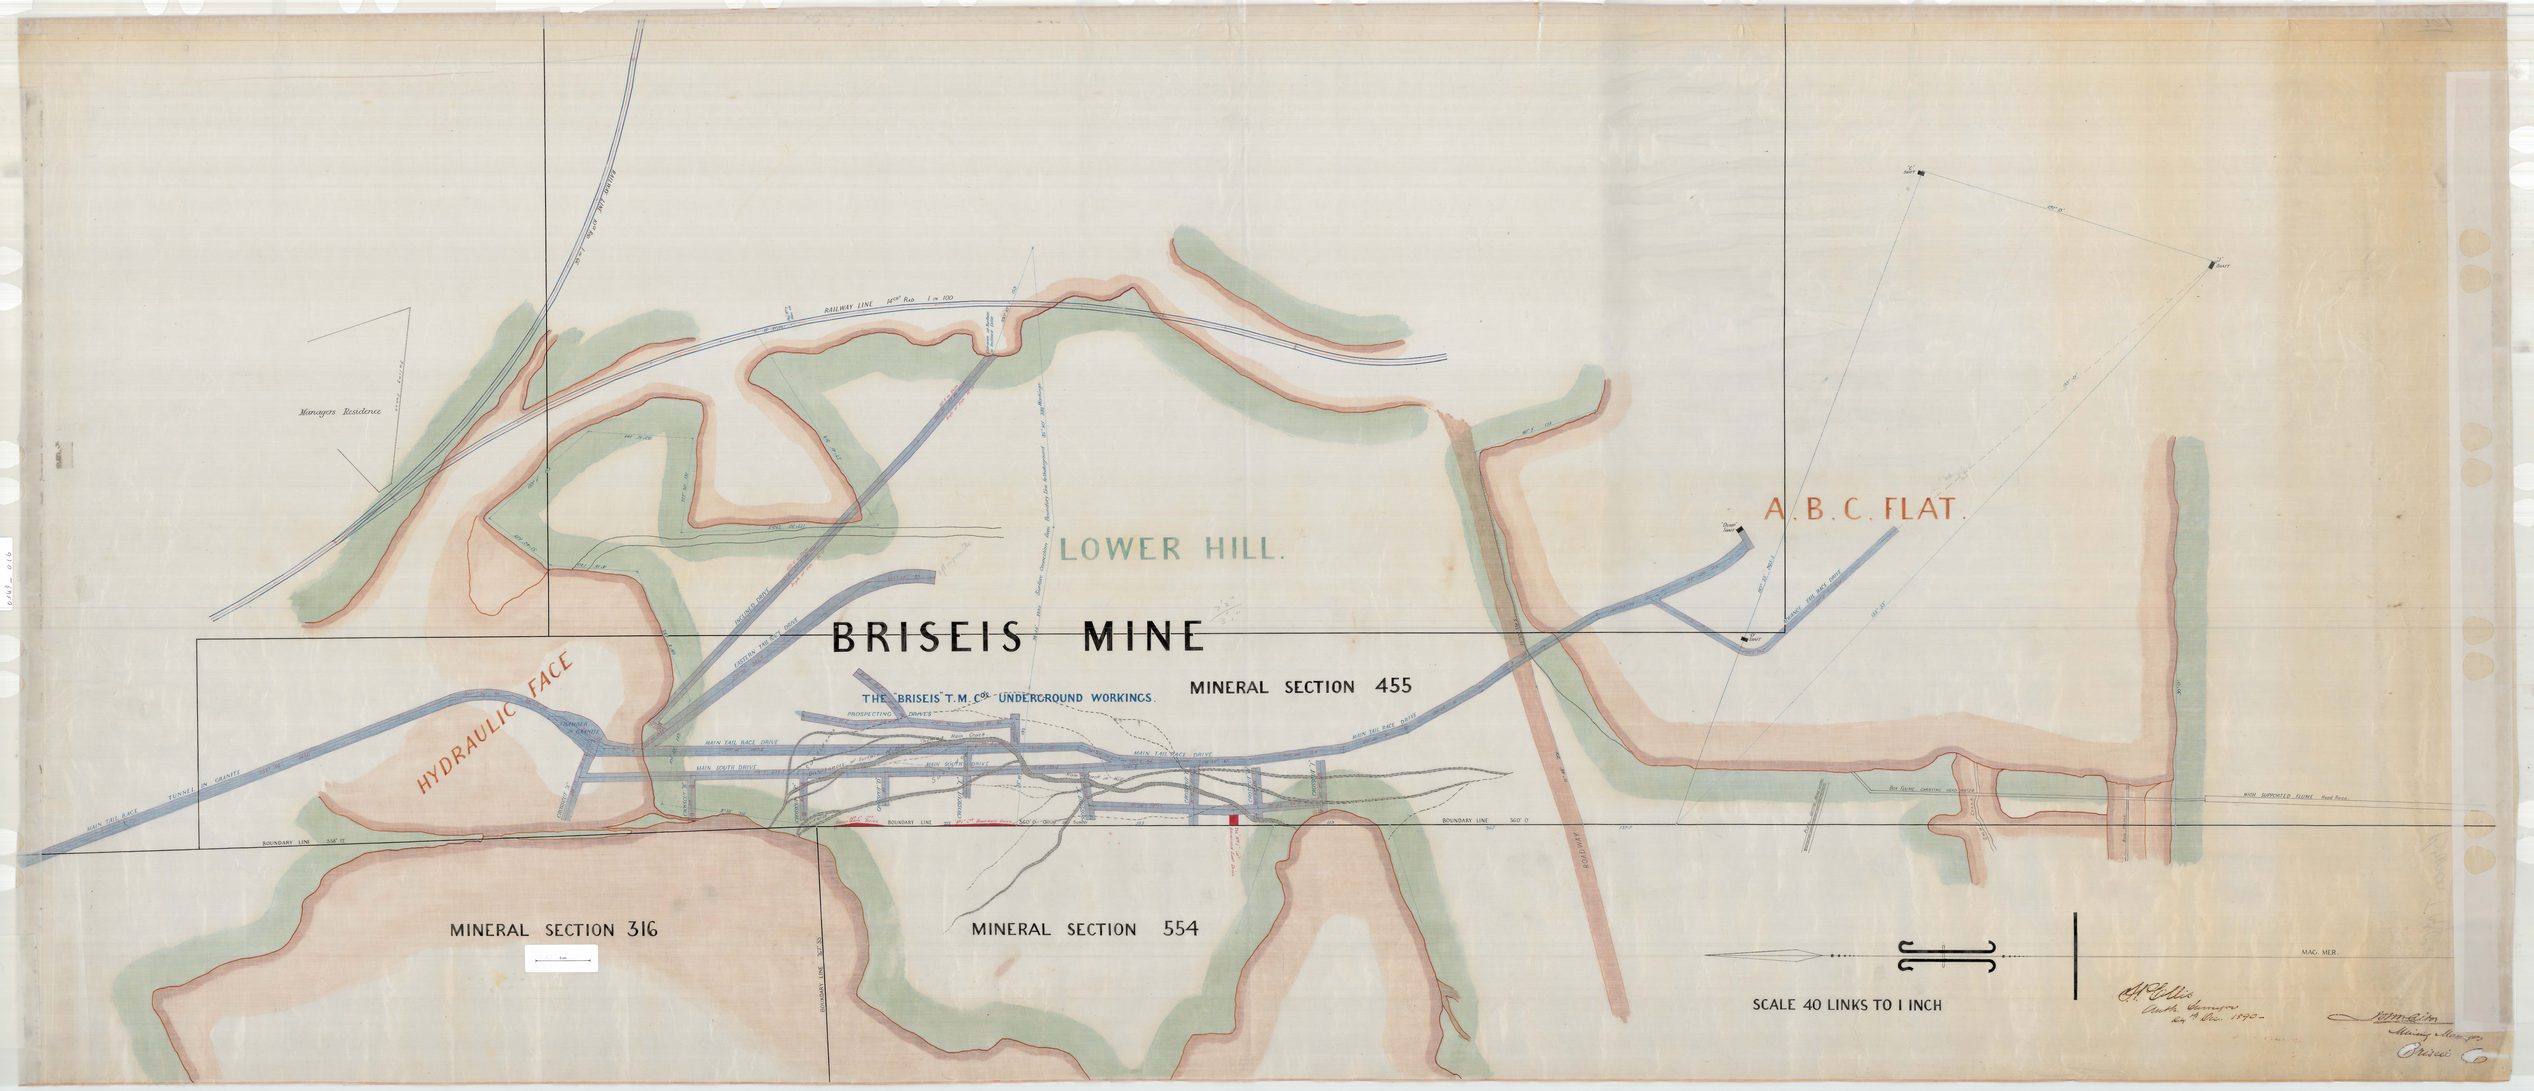
BRISEIS MINE
THE BRISEIS T.M. Co. UNDERGROUND WORKINGS.
MINERAL SECTION 455
LOWER HILL.
A.B.C. FLAT.
HYDRAULIC FACE
Managers Residence
RAILWAY LINE
MAIN TAIL RACE
TUNNEL IN GRANITE
MAIN TAIL RACE DRIVE
MAIN SOUTH DRIVE
PROSPECTING DRIVES
BOUNDARY LINE
ROADWAY
MINERAL SECTION 316
MINERAL SECTION 554
SCALE 40 LINKS TO 1 INCH
MAG. MER.