


0349-024

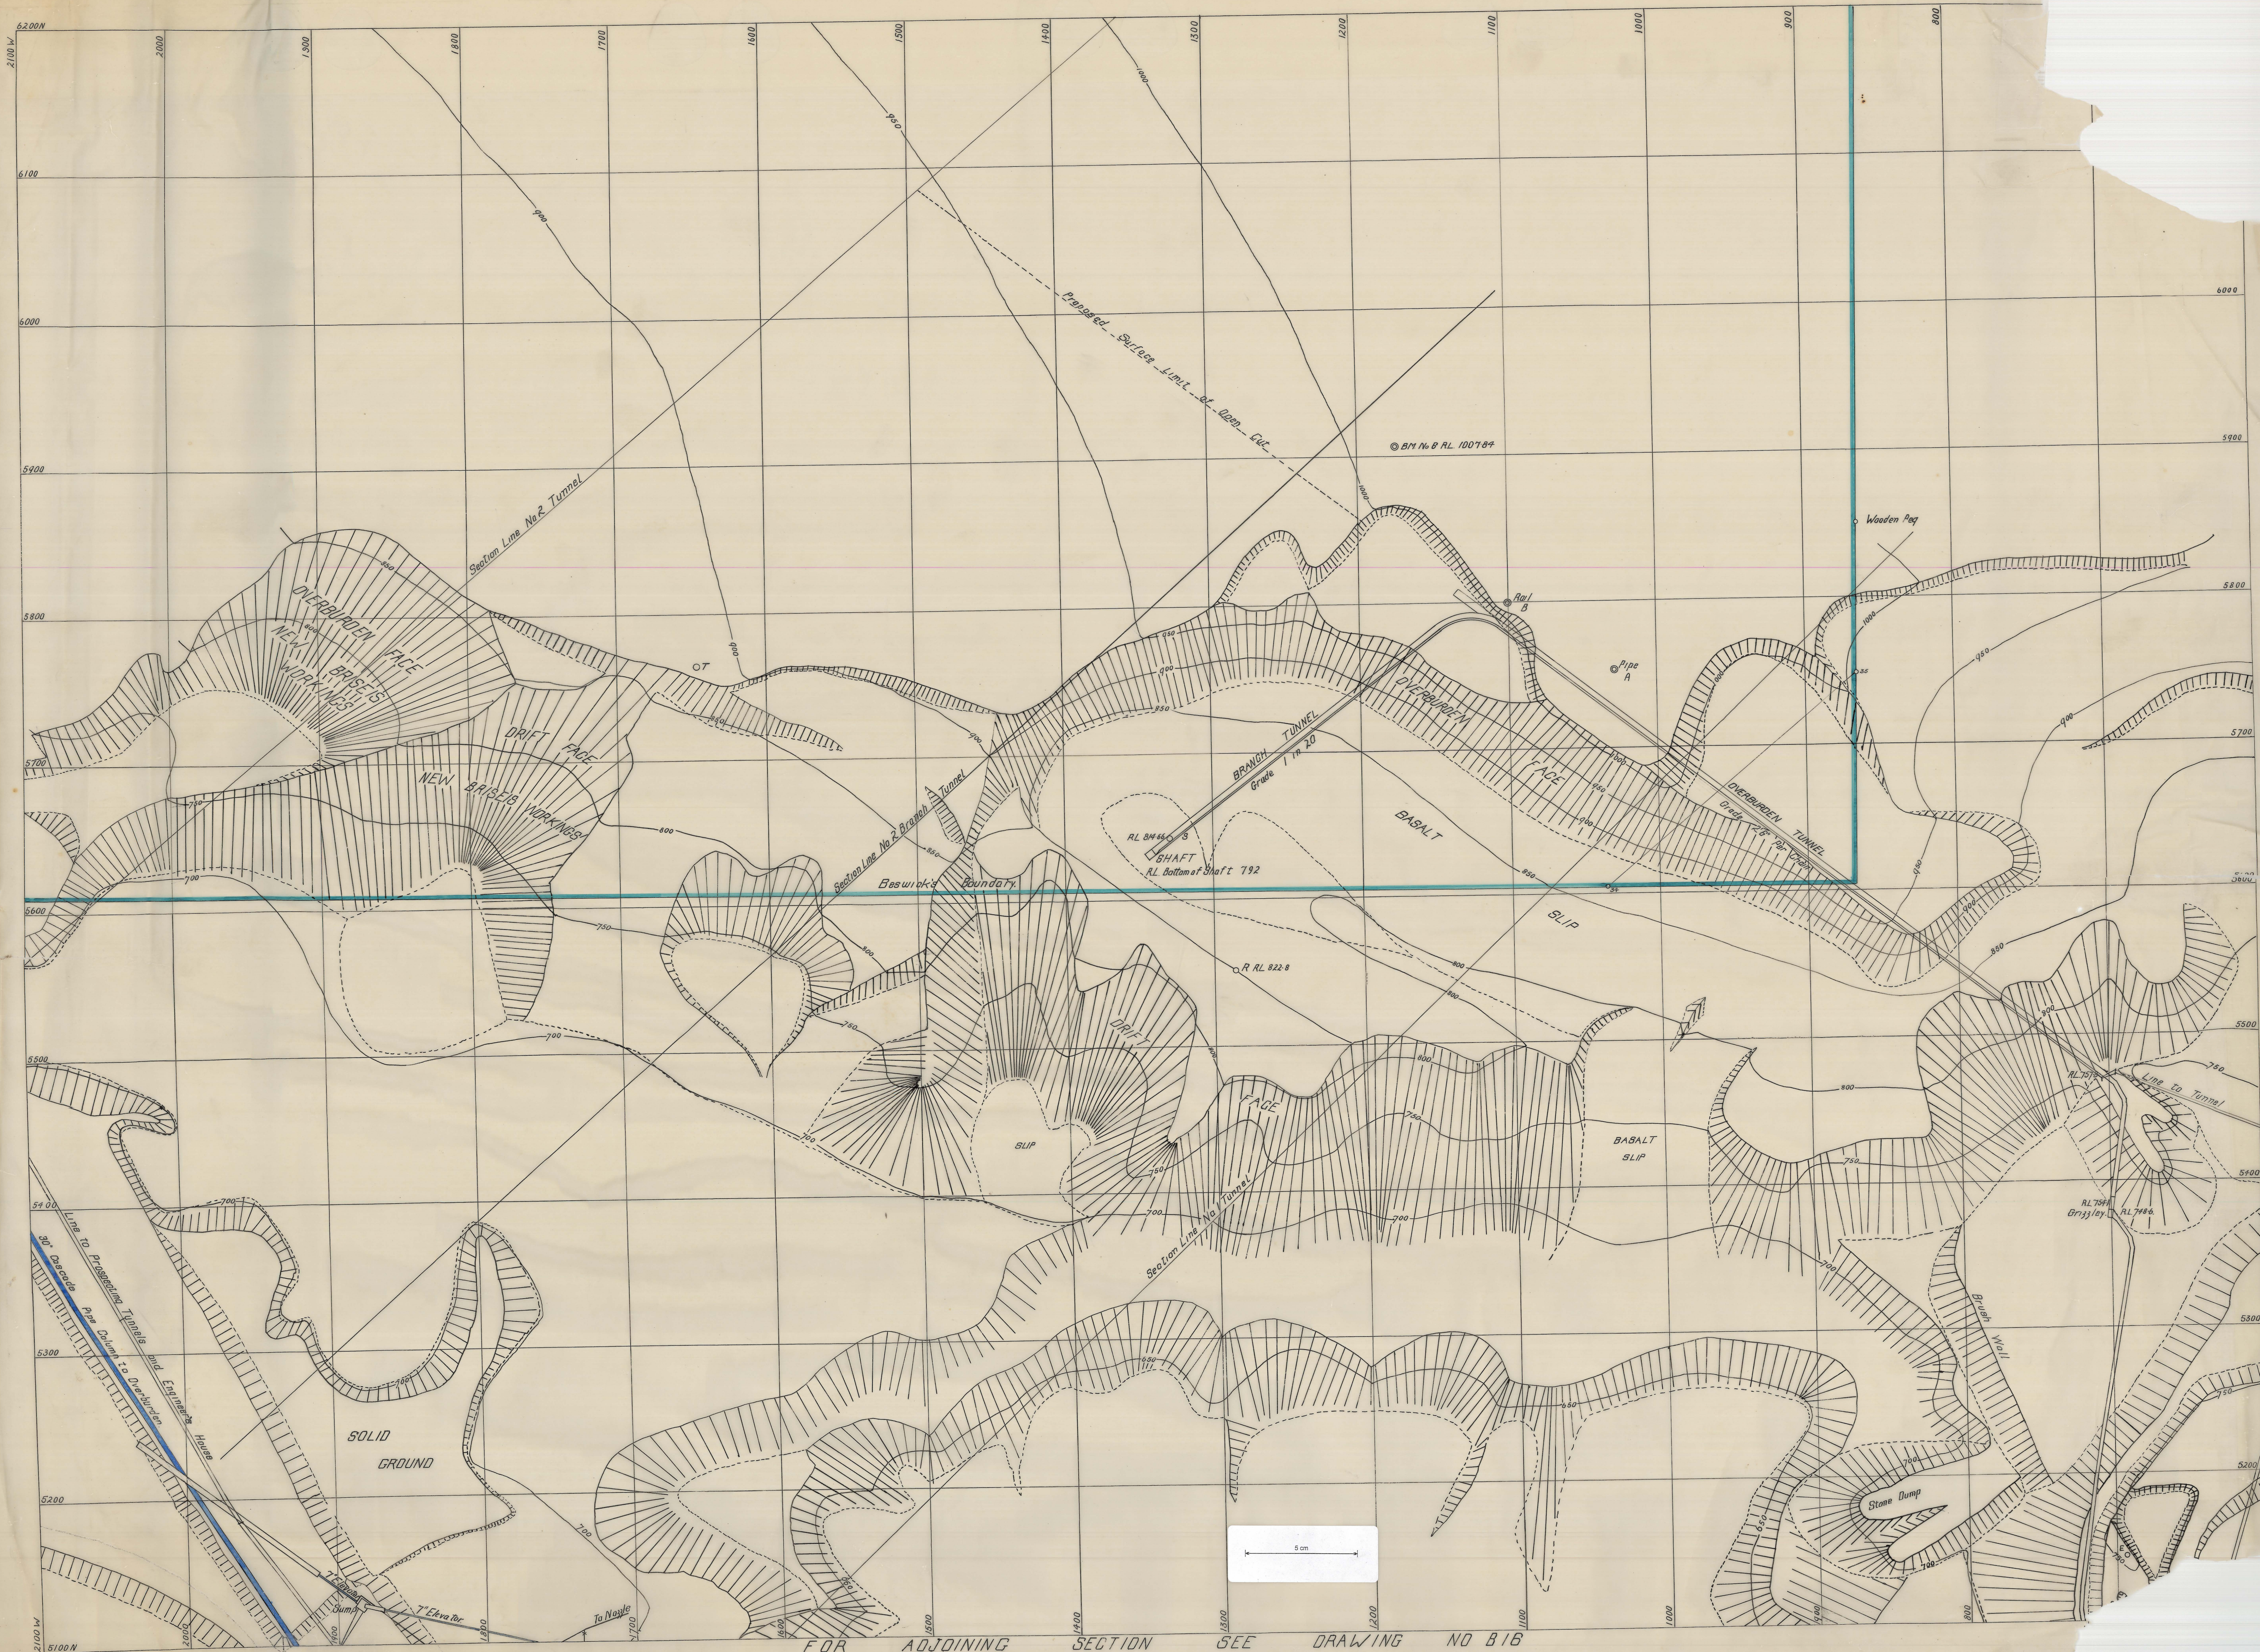

FOR ADJOINING SECTION SEE DRAWING NO B16