


5 cm

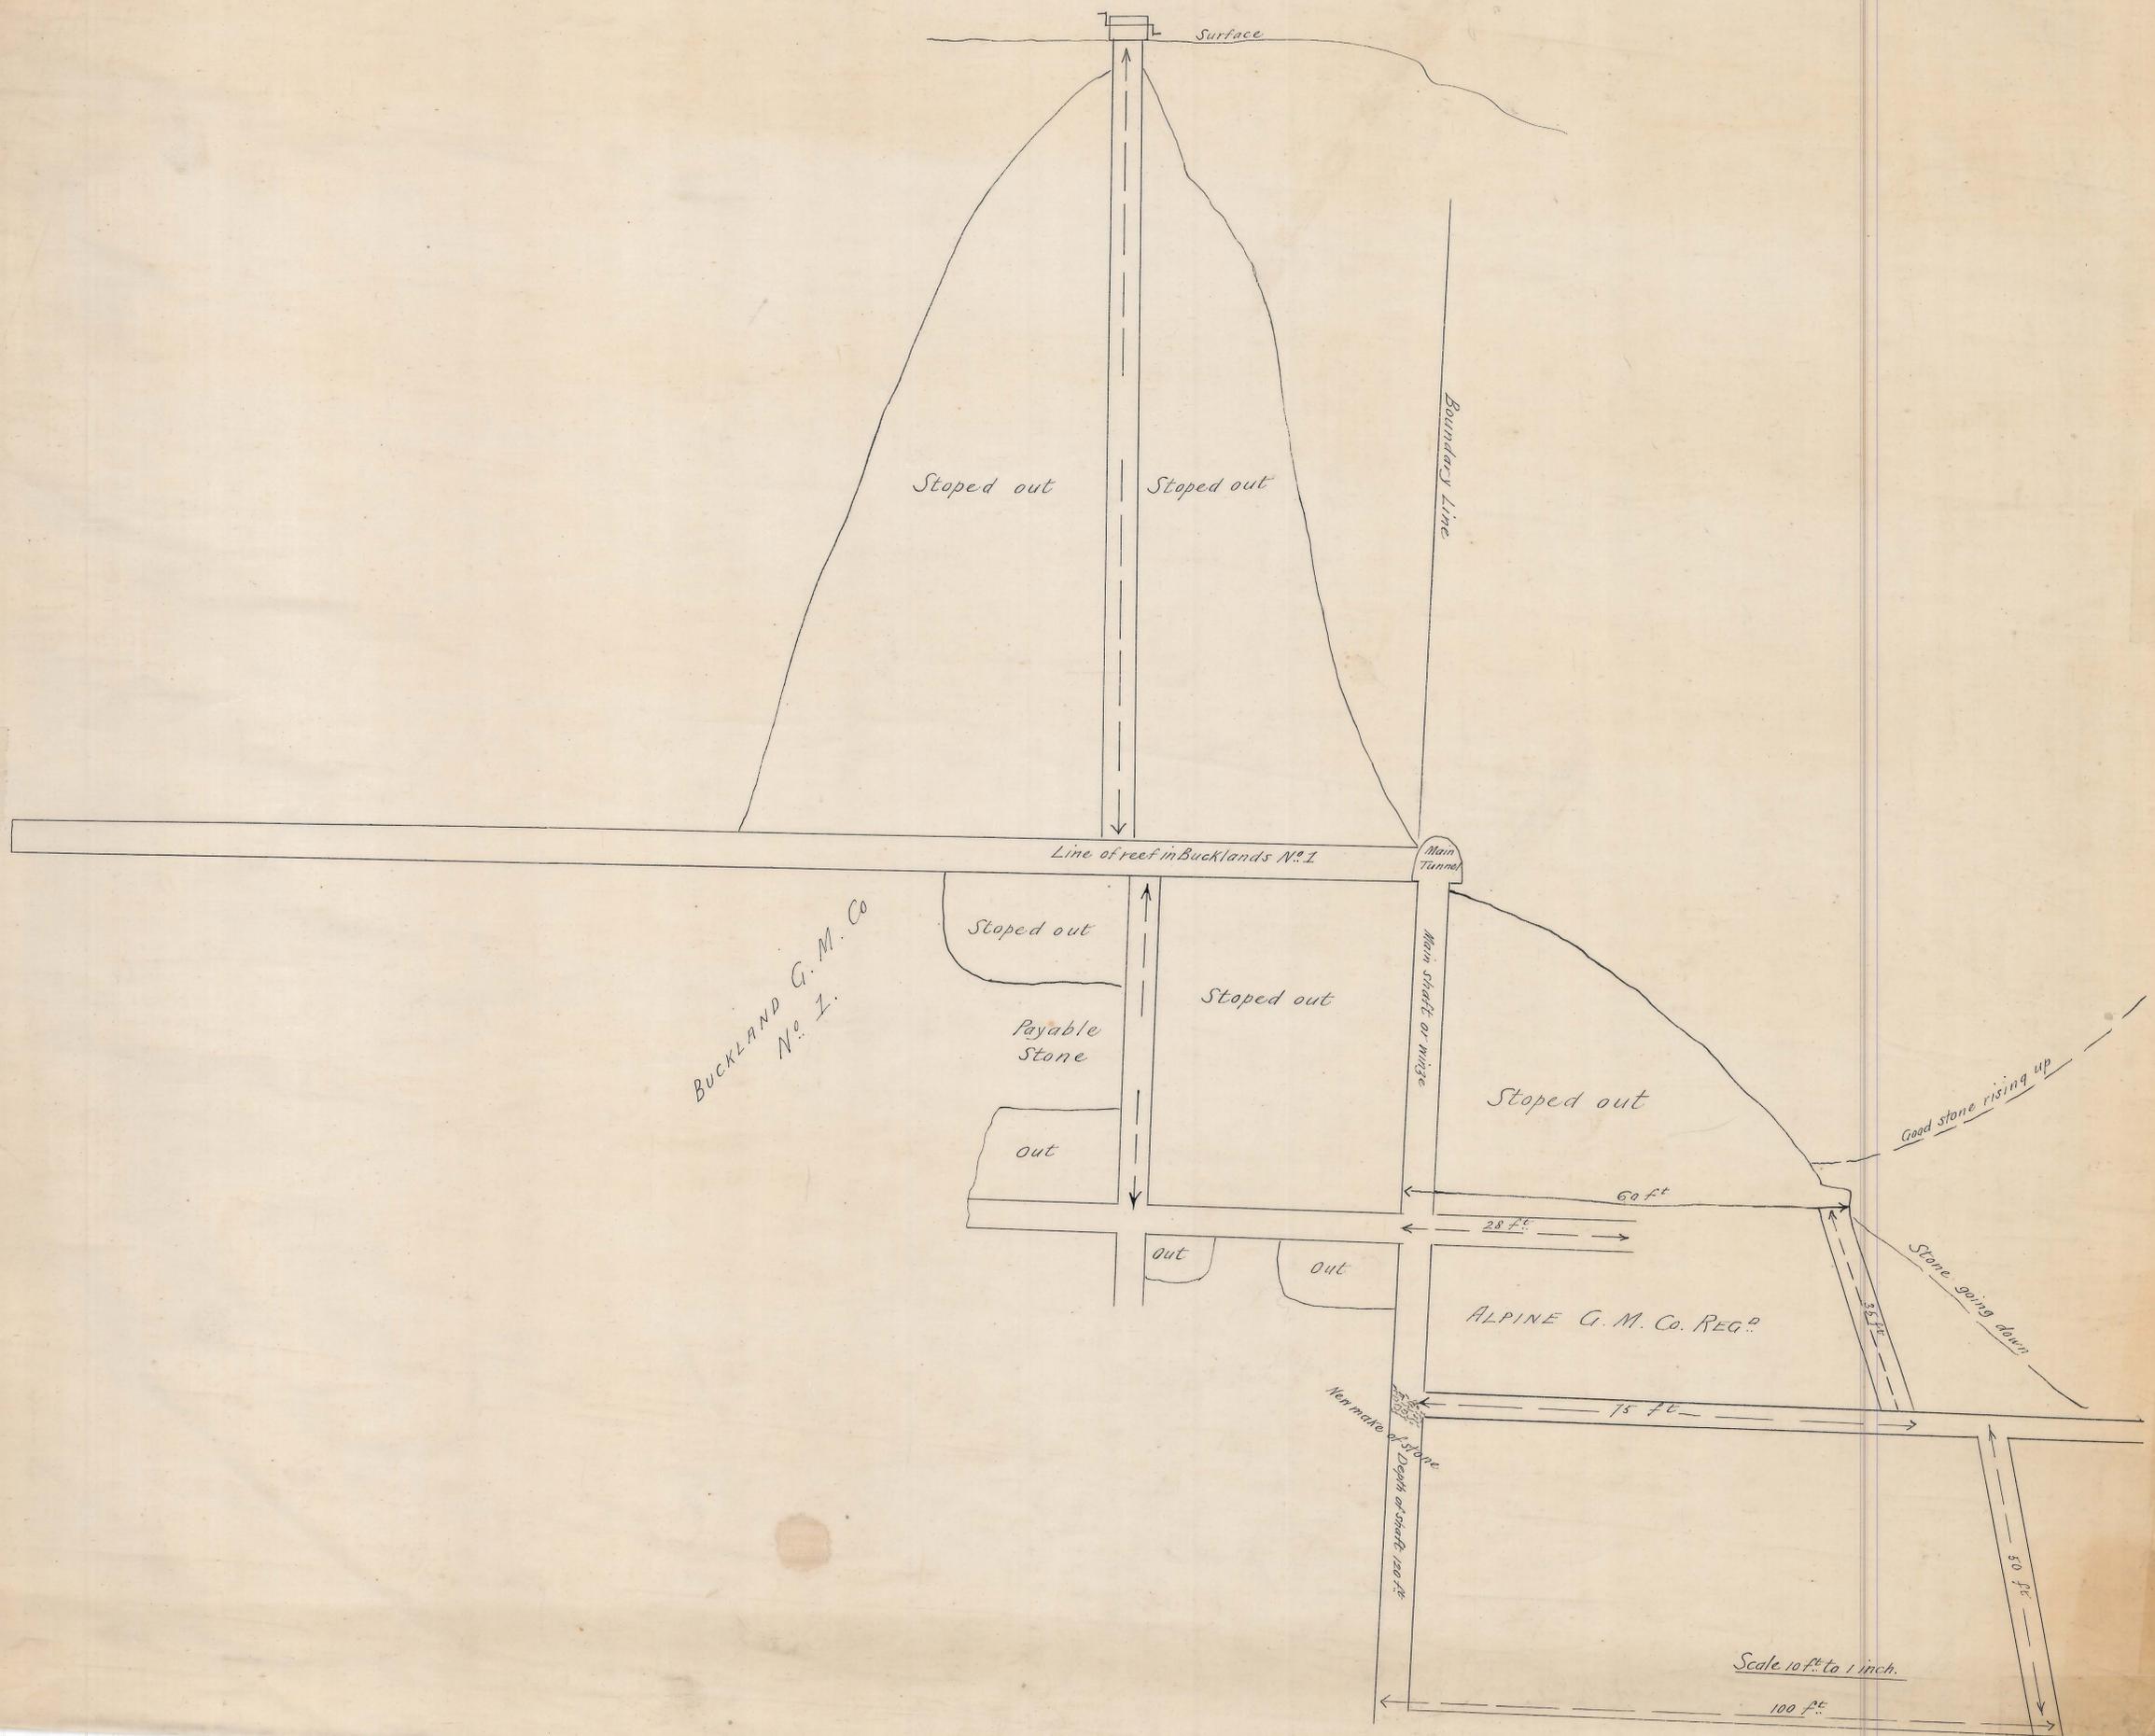

BUCKLAND G.M. Co
No. 1.

ALPINE G.M. Co. REG. #

Scale 10 ft. to 1 inch.

100 ft.