
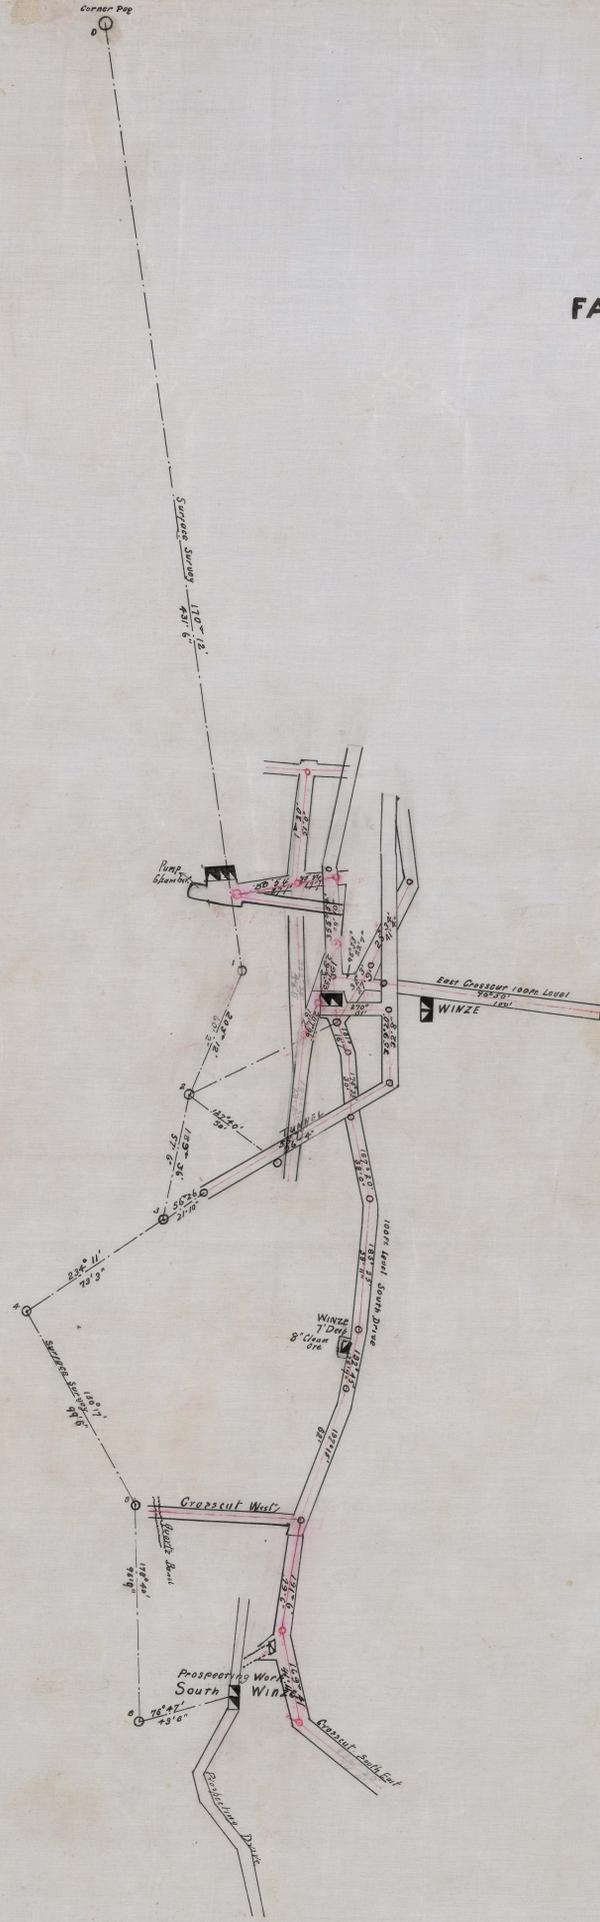


352
04

FARRELL MINING COY. LTD. PLAN NORTHERN SECTION SCALE 1 INCH = 30 FEET

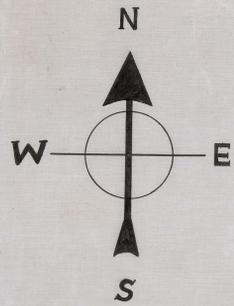

LONGITUDINAL SECTION

Looking North

