NORTH MOUNT FARRELL MINE

FIELD NOTES OF RE-SURVEY OF Nos 8, 9, & 10 LEVELS TO 31-12-31

NOTE:- LEVELS ARE NOW NUMBERED FROM ADIT LEVEL
No 8 LEVEL PREVIOUSLY SHOWN AS No 12 LEVEL
No 9 " " " " No-13 "
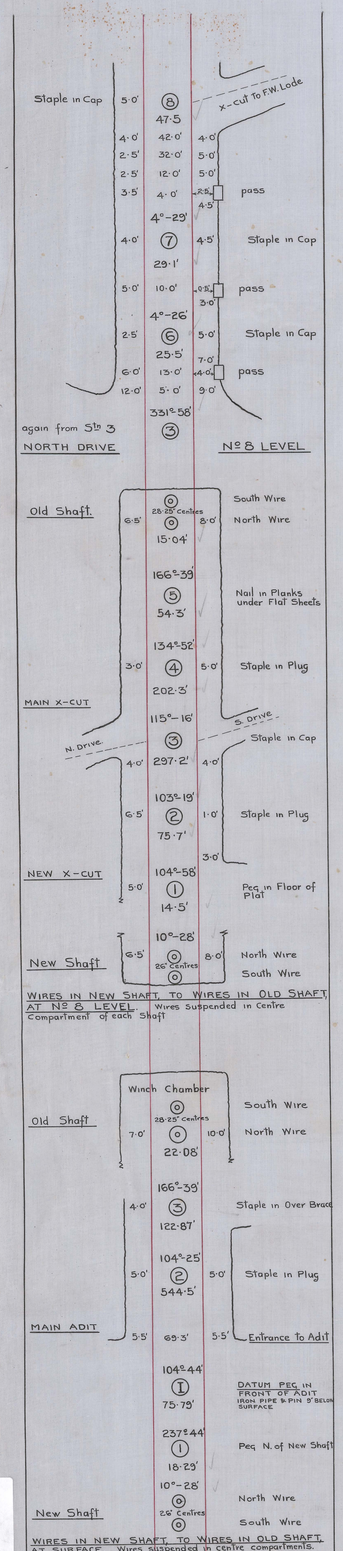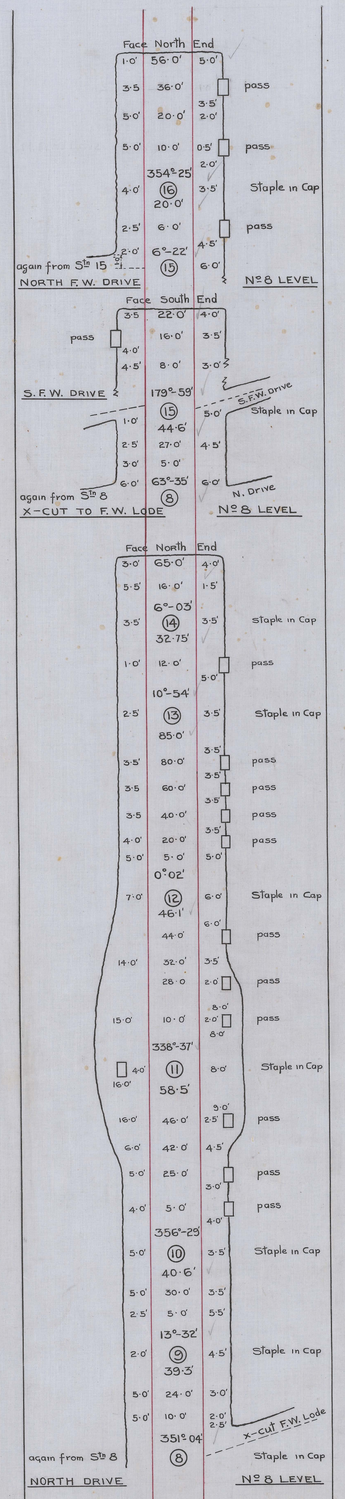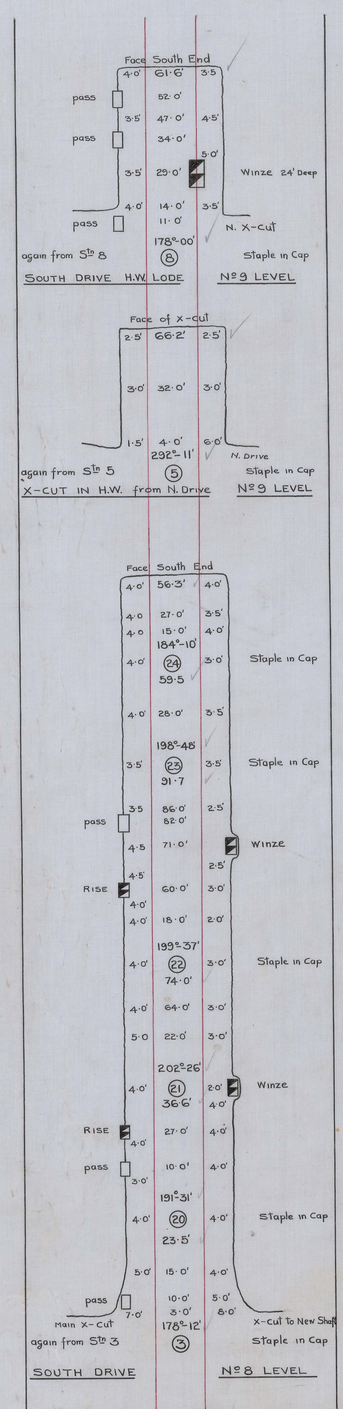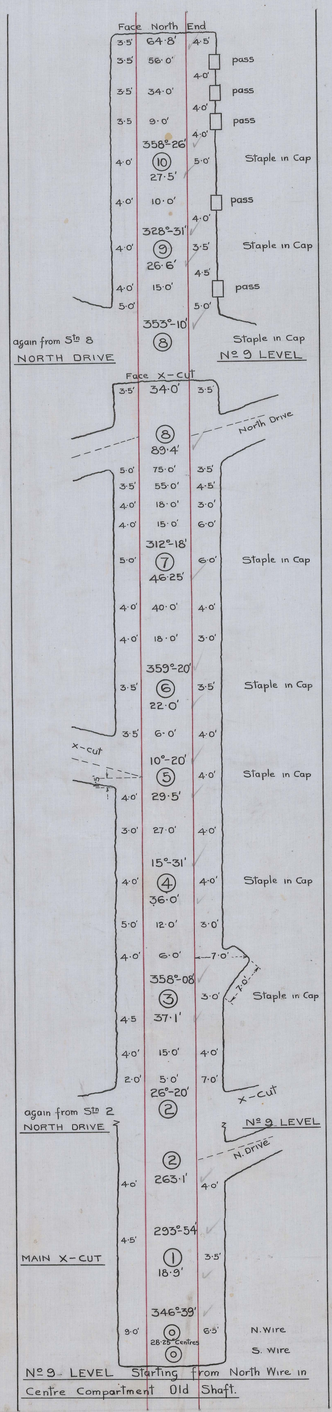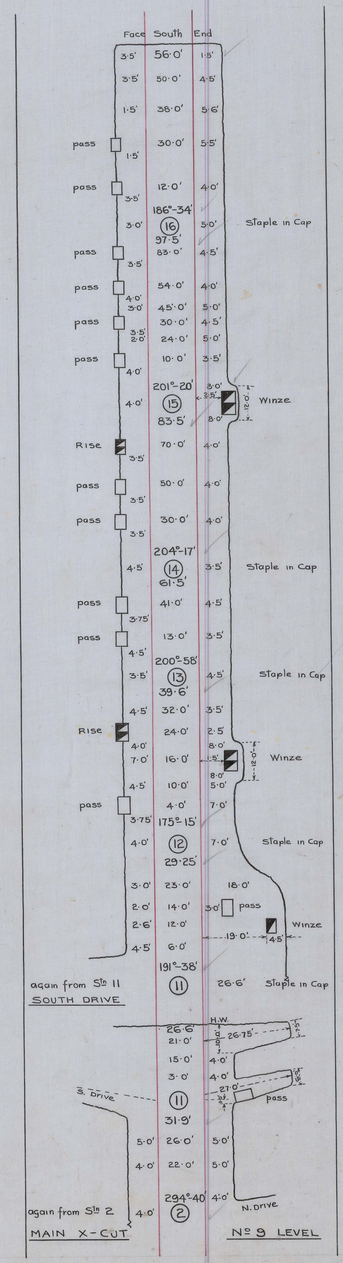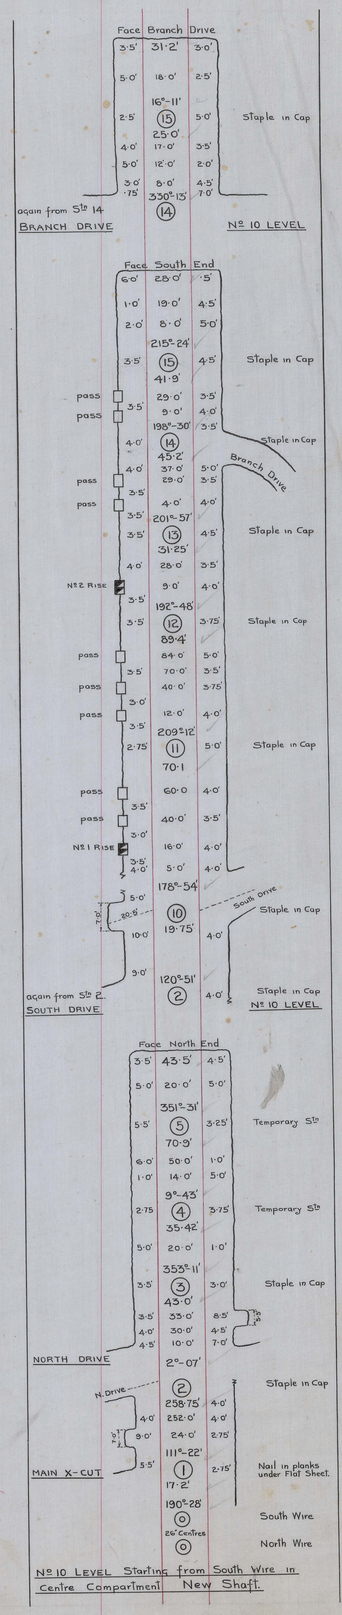
J.P. Andrew 19-2-32
GENERAL MANAGER