
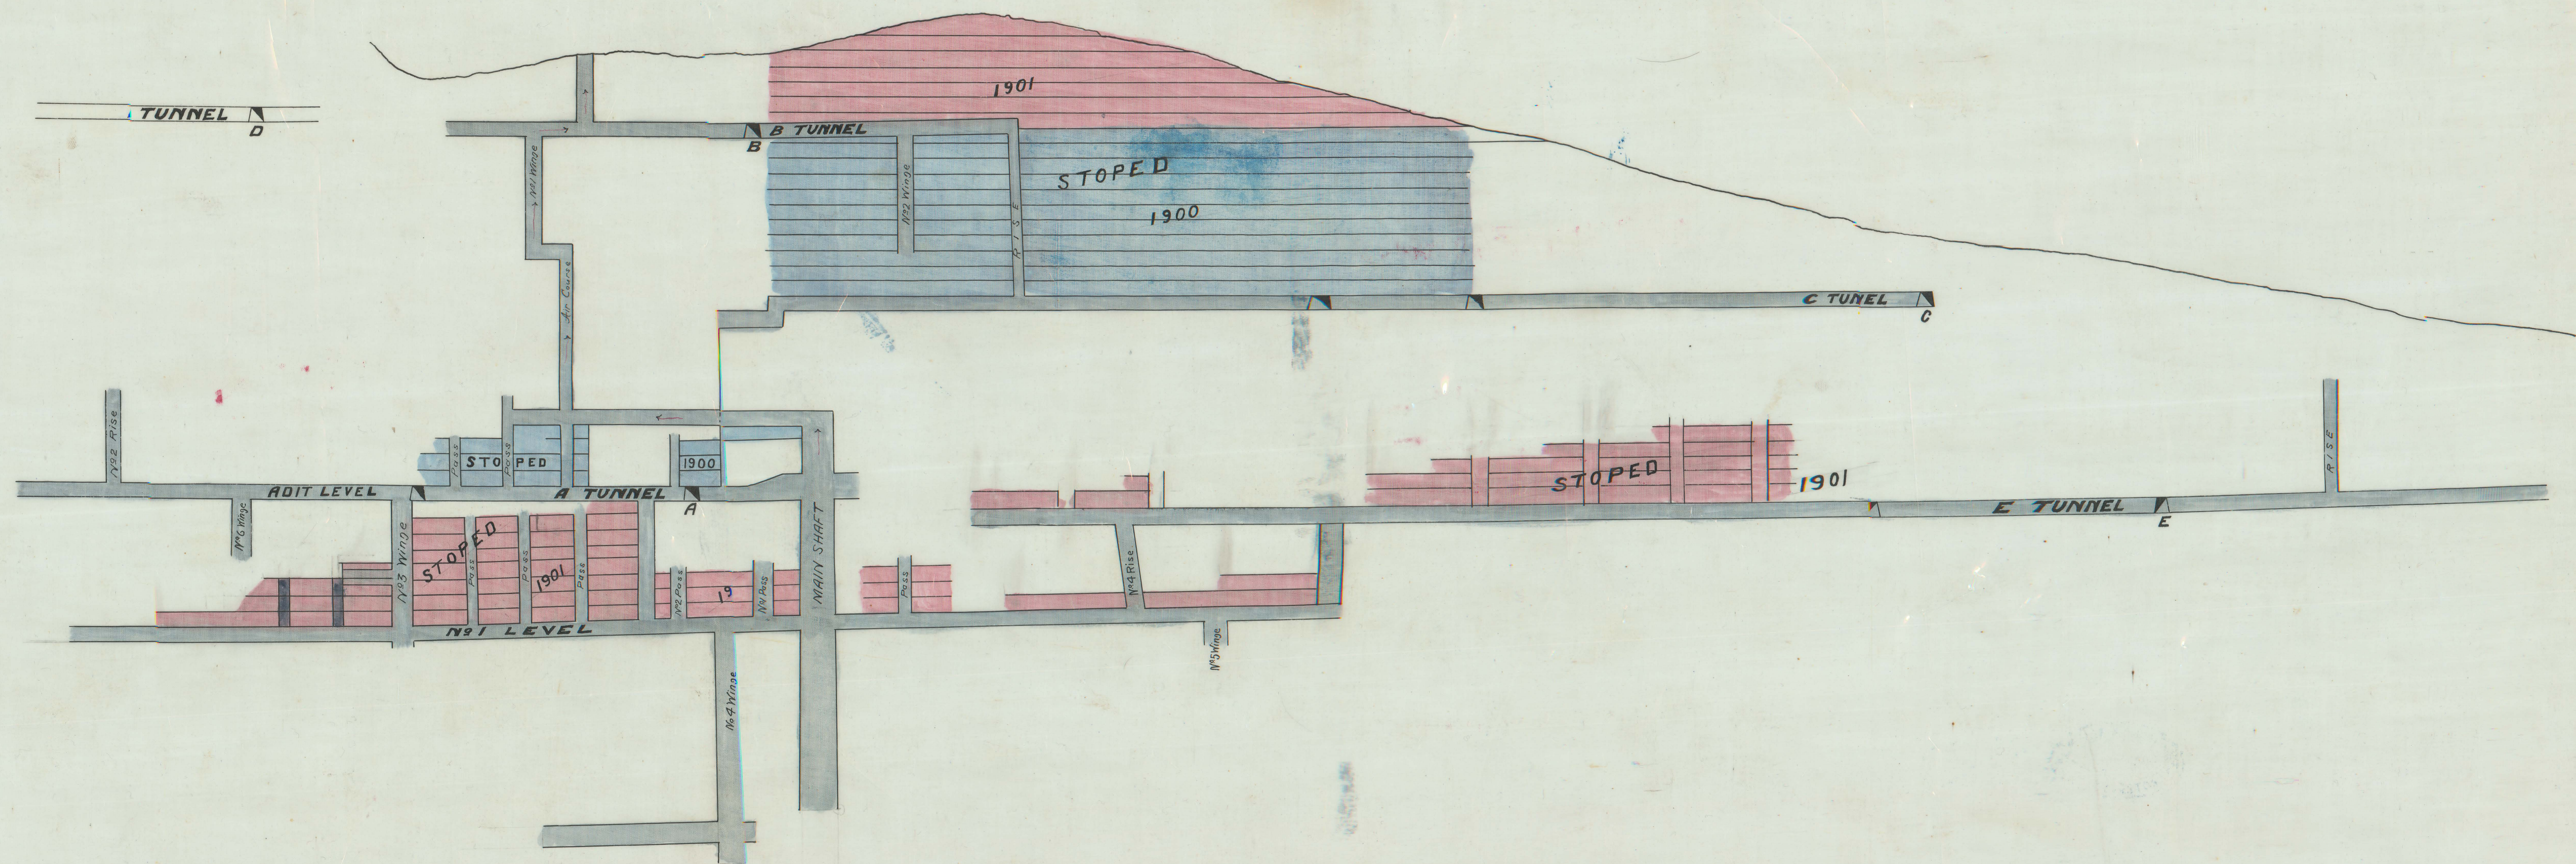


THE MT ZEEHANTAS S.L. MINES LTD

SILVER SPRAY — SECTION ON LODE

SCALE — 3 FEET TO 1 INCH

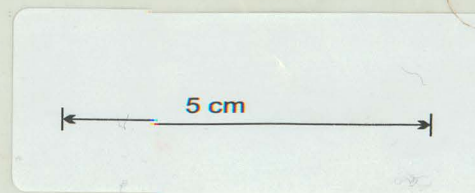

MANAGER

21.12.01

