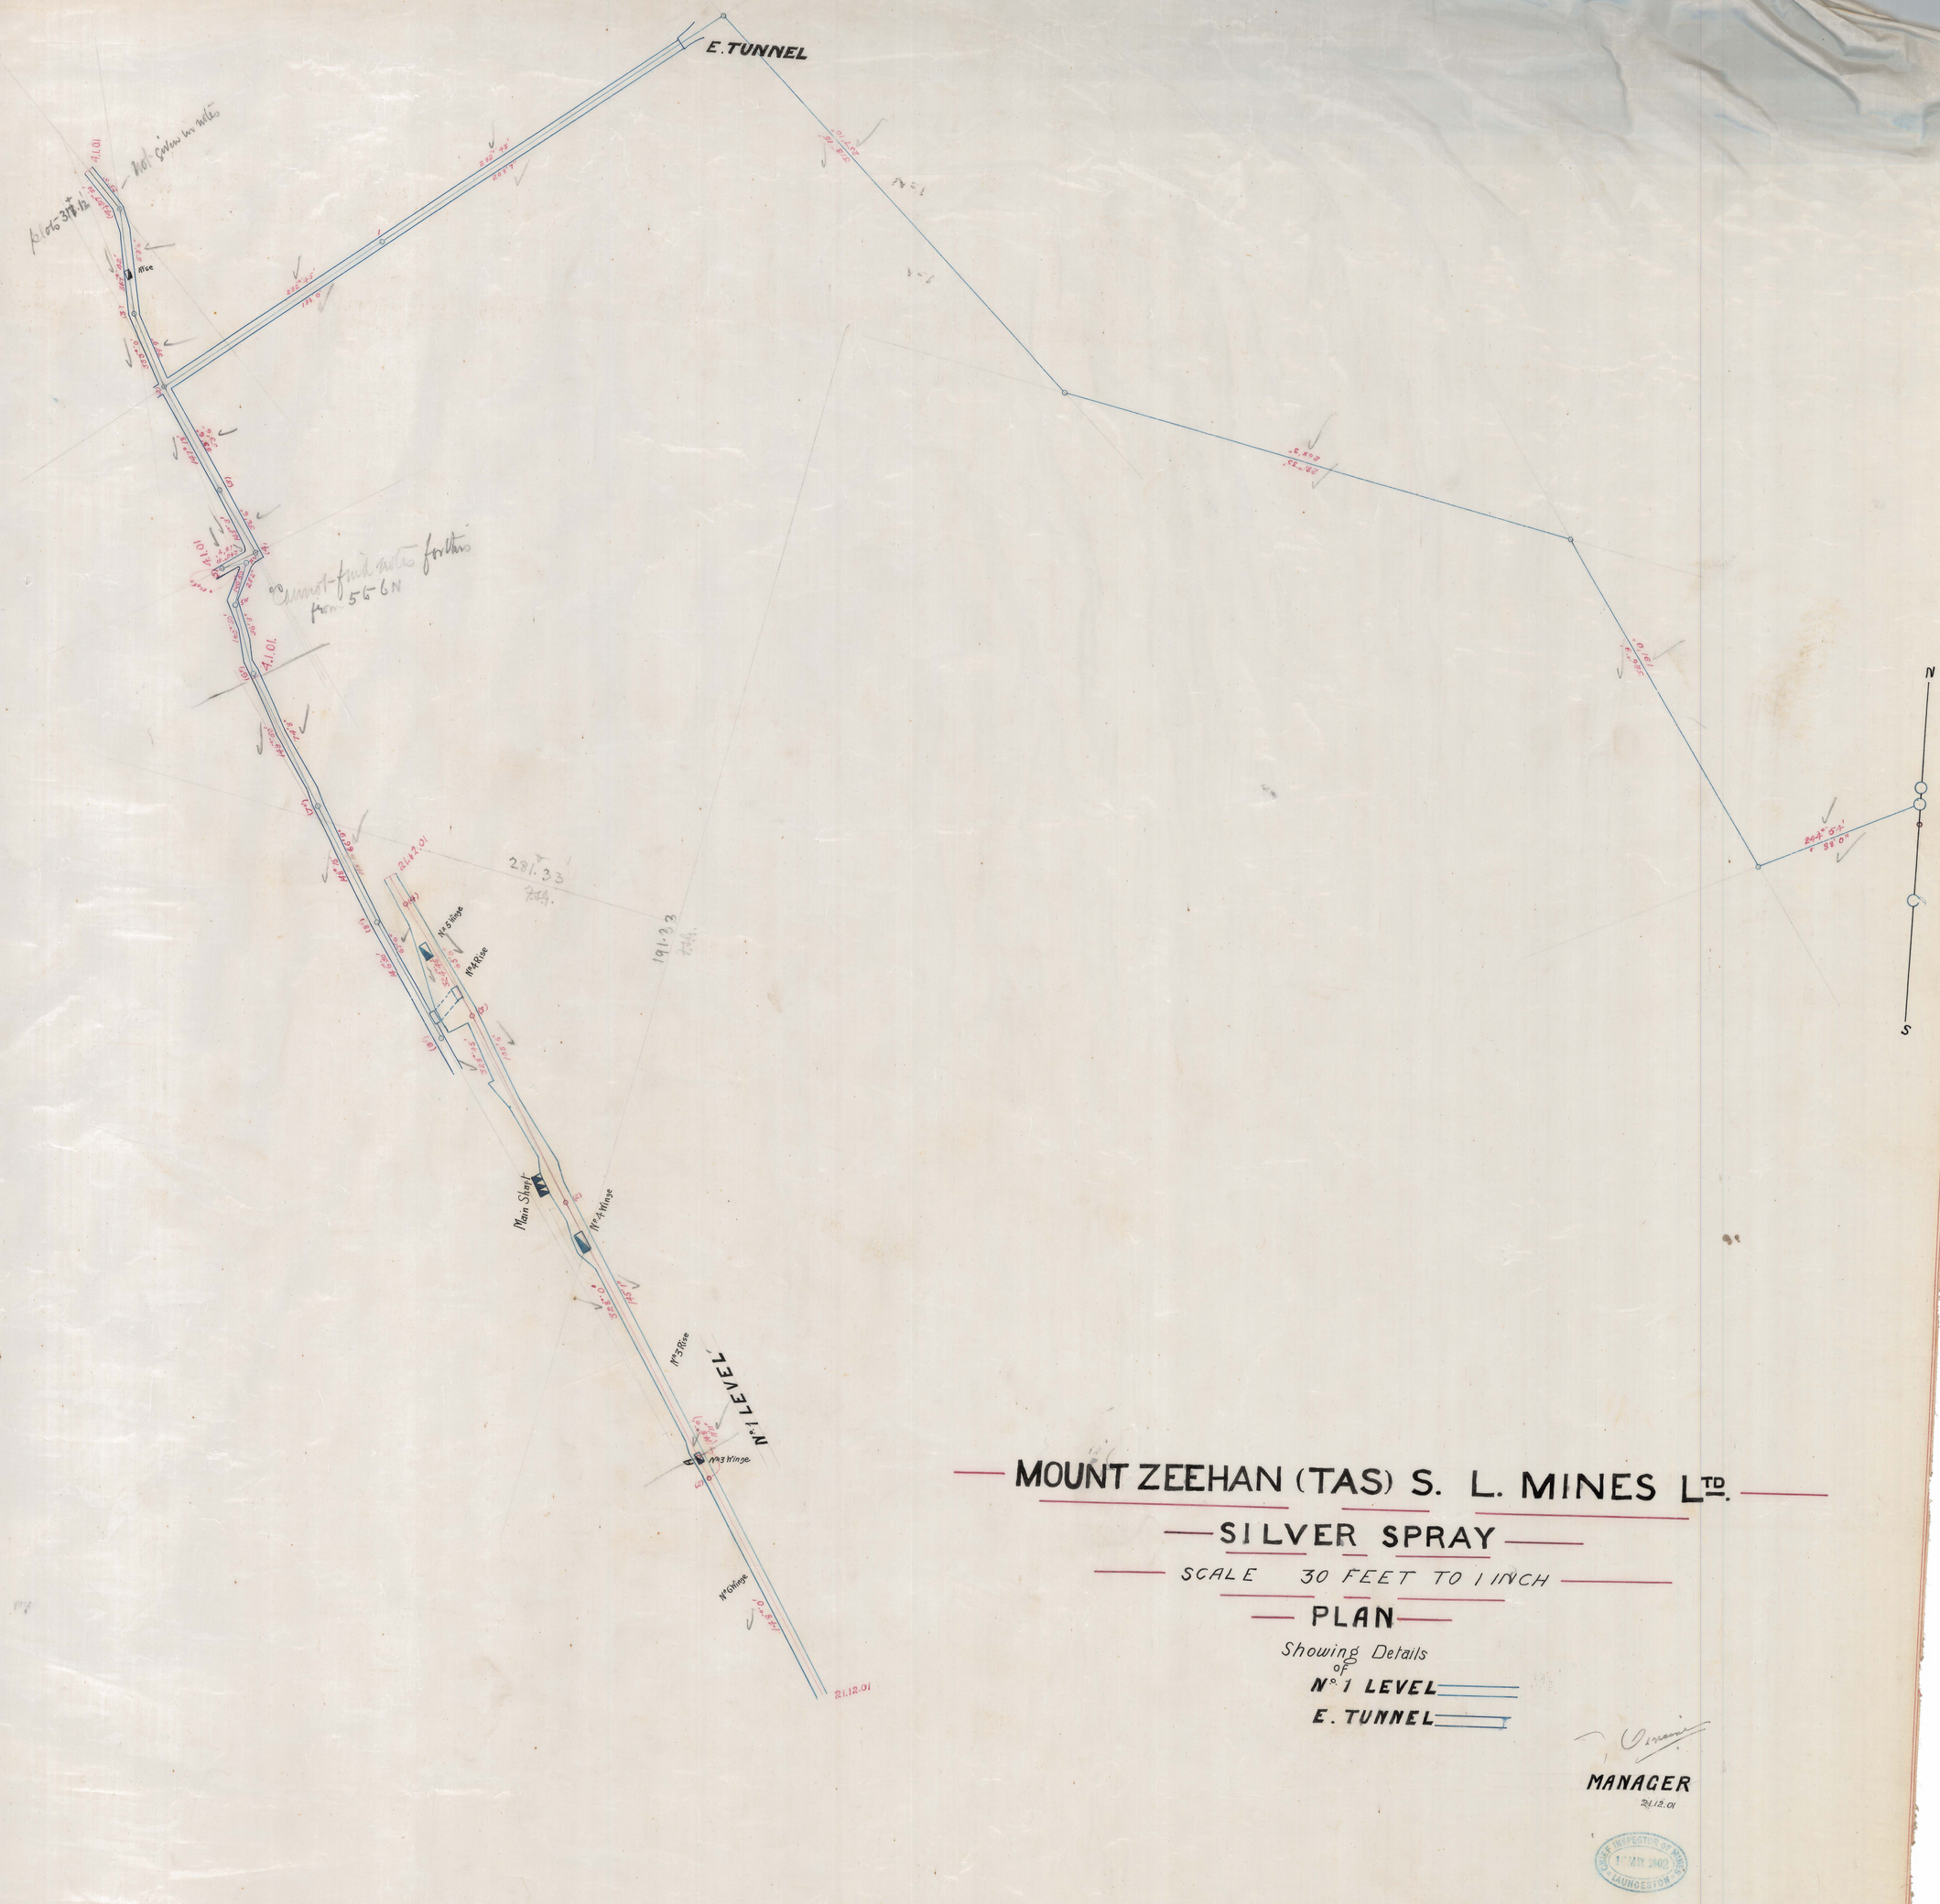

MOUNT ZEEHAN (TAS) S. L. MINES LTD.

SILVER SPRAY

SCALE 30 FEET TO 1 INCH

PLAN

Showing Details of

No 1 LEVEL

E. TUNNEL

MANAGER

21.12.01

MINE INSPECTOR OF MINES
15 JAN 1902
LAUNCESTON