PLAN
COMET S.M.Co^Y

MAY 1899.

25 feet to an inch.

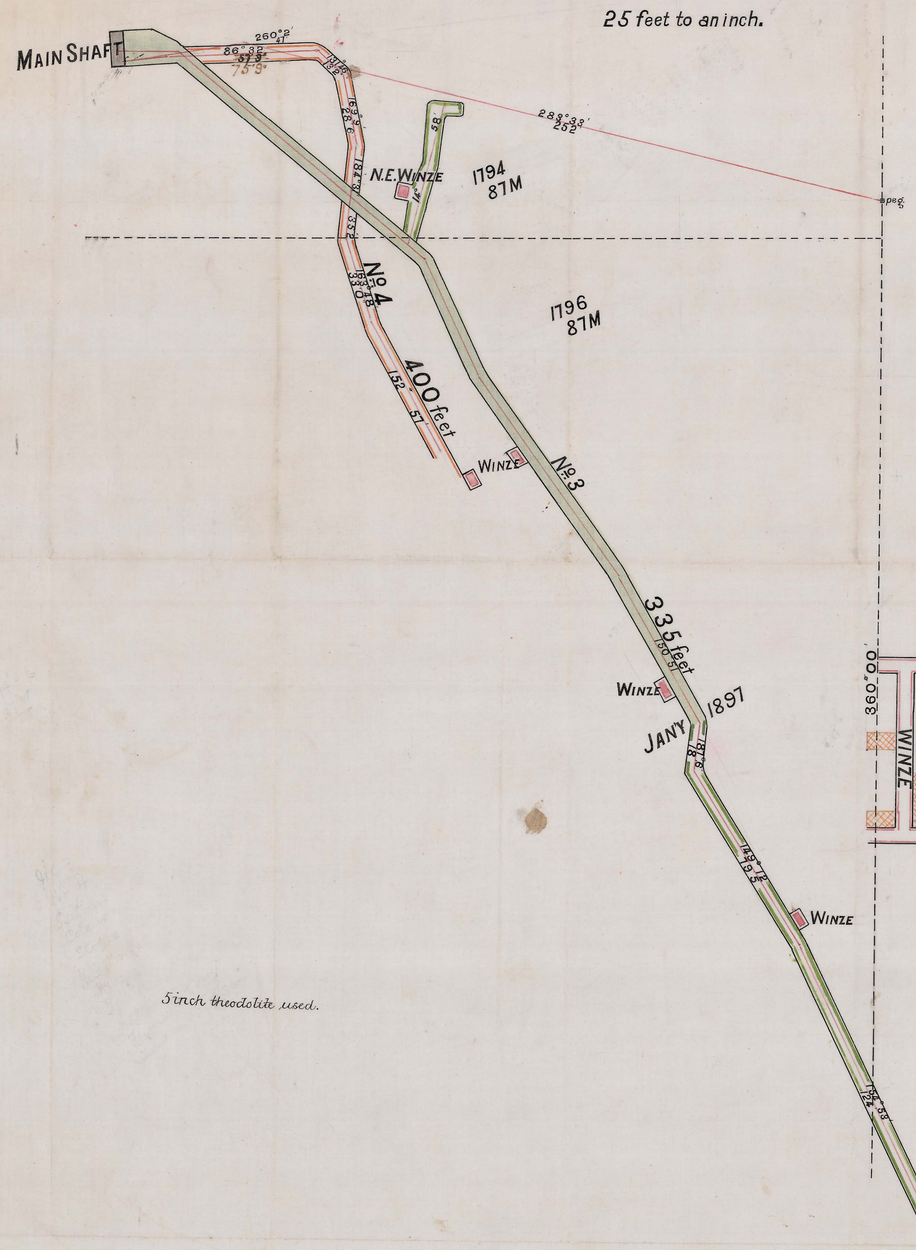

5 inch theodolite used.

VERTICAL PLAN OF STOPES &c.

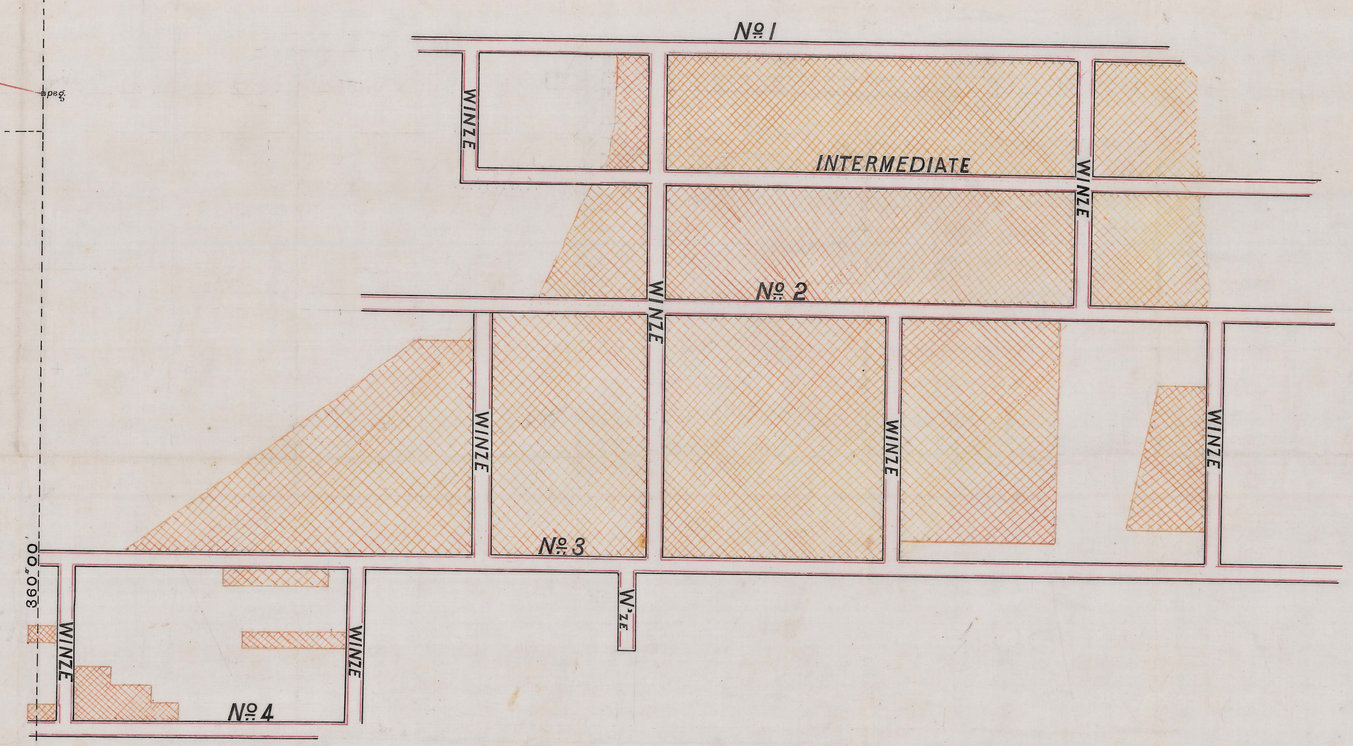

Malcolm Moore
Techn.
June 3rd 1899.