


COMET SILVER MINING CO.

—LONGITUDINAL SECTION—

—Scale 25 Feet = 1 Inch—

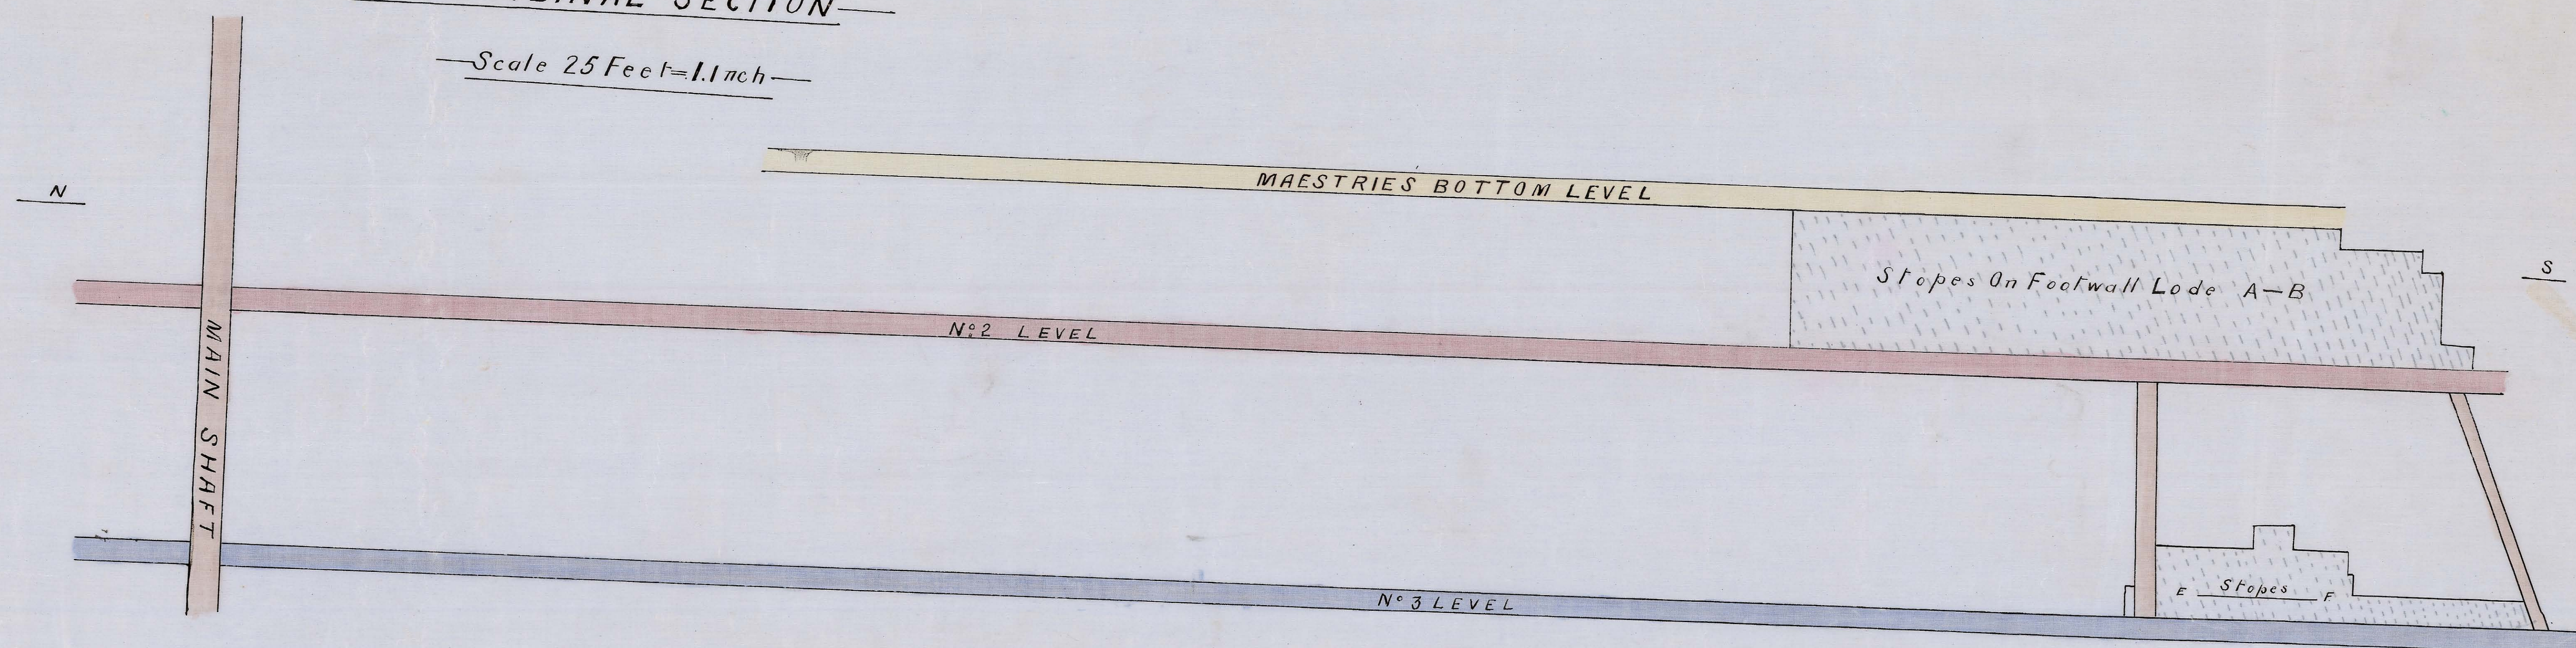

RECEIVED  
MAR 5 1893

5 MAR 1893

W. H. Dwyer