




355
18

355
-18

355
18

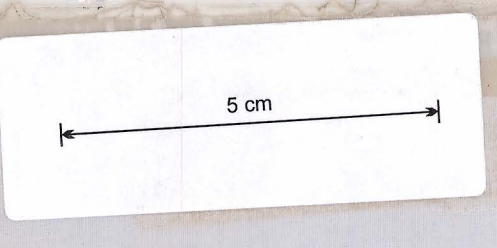

THE COMET SILVER MINING CO

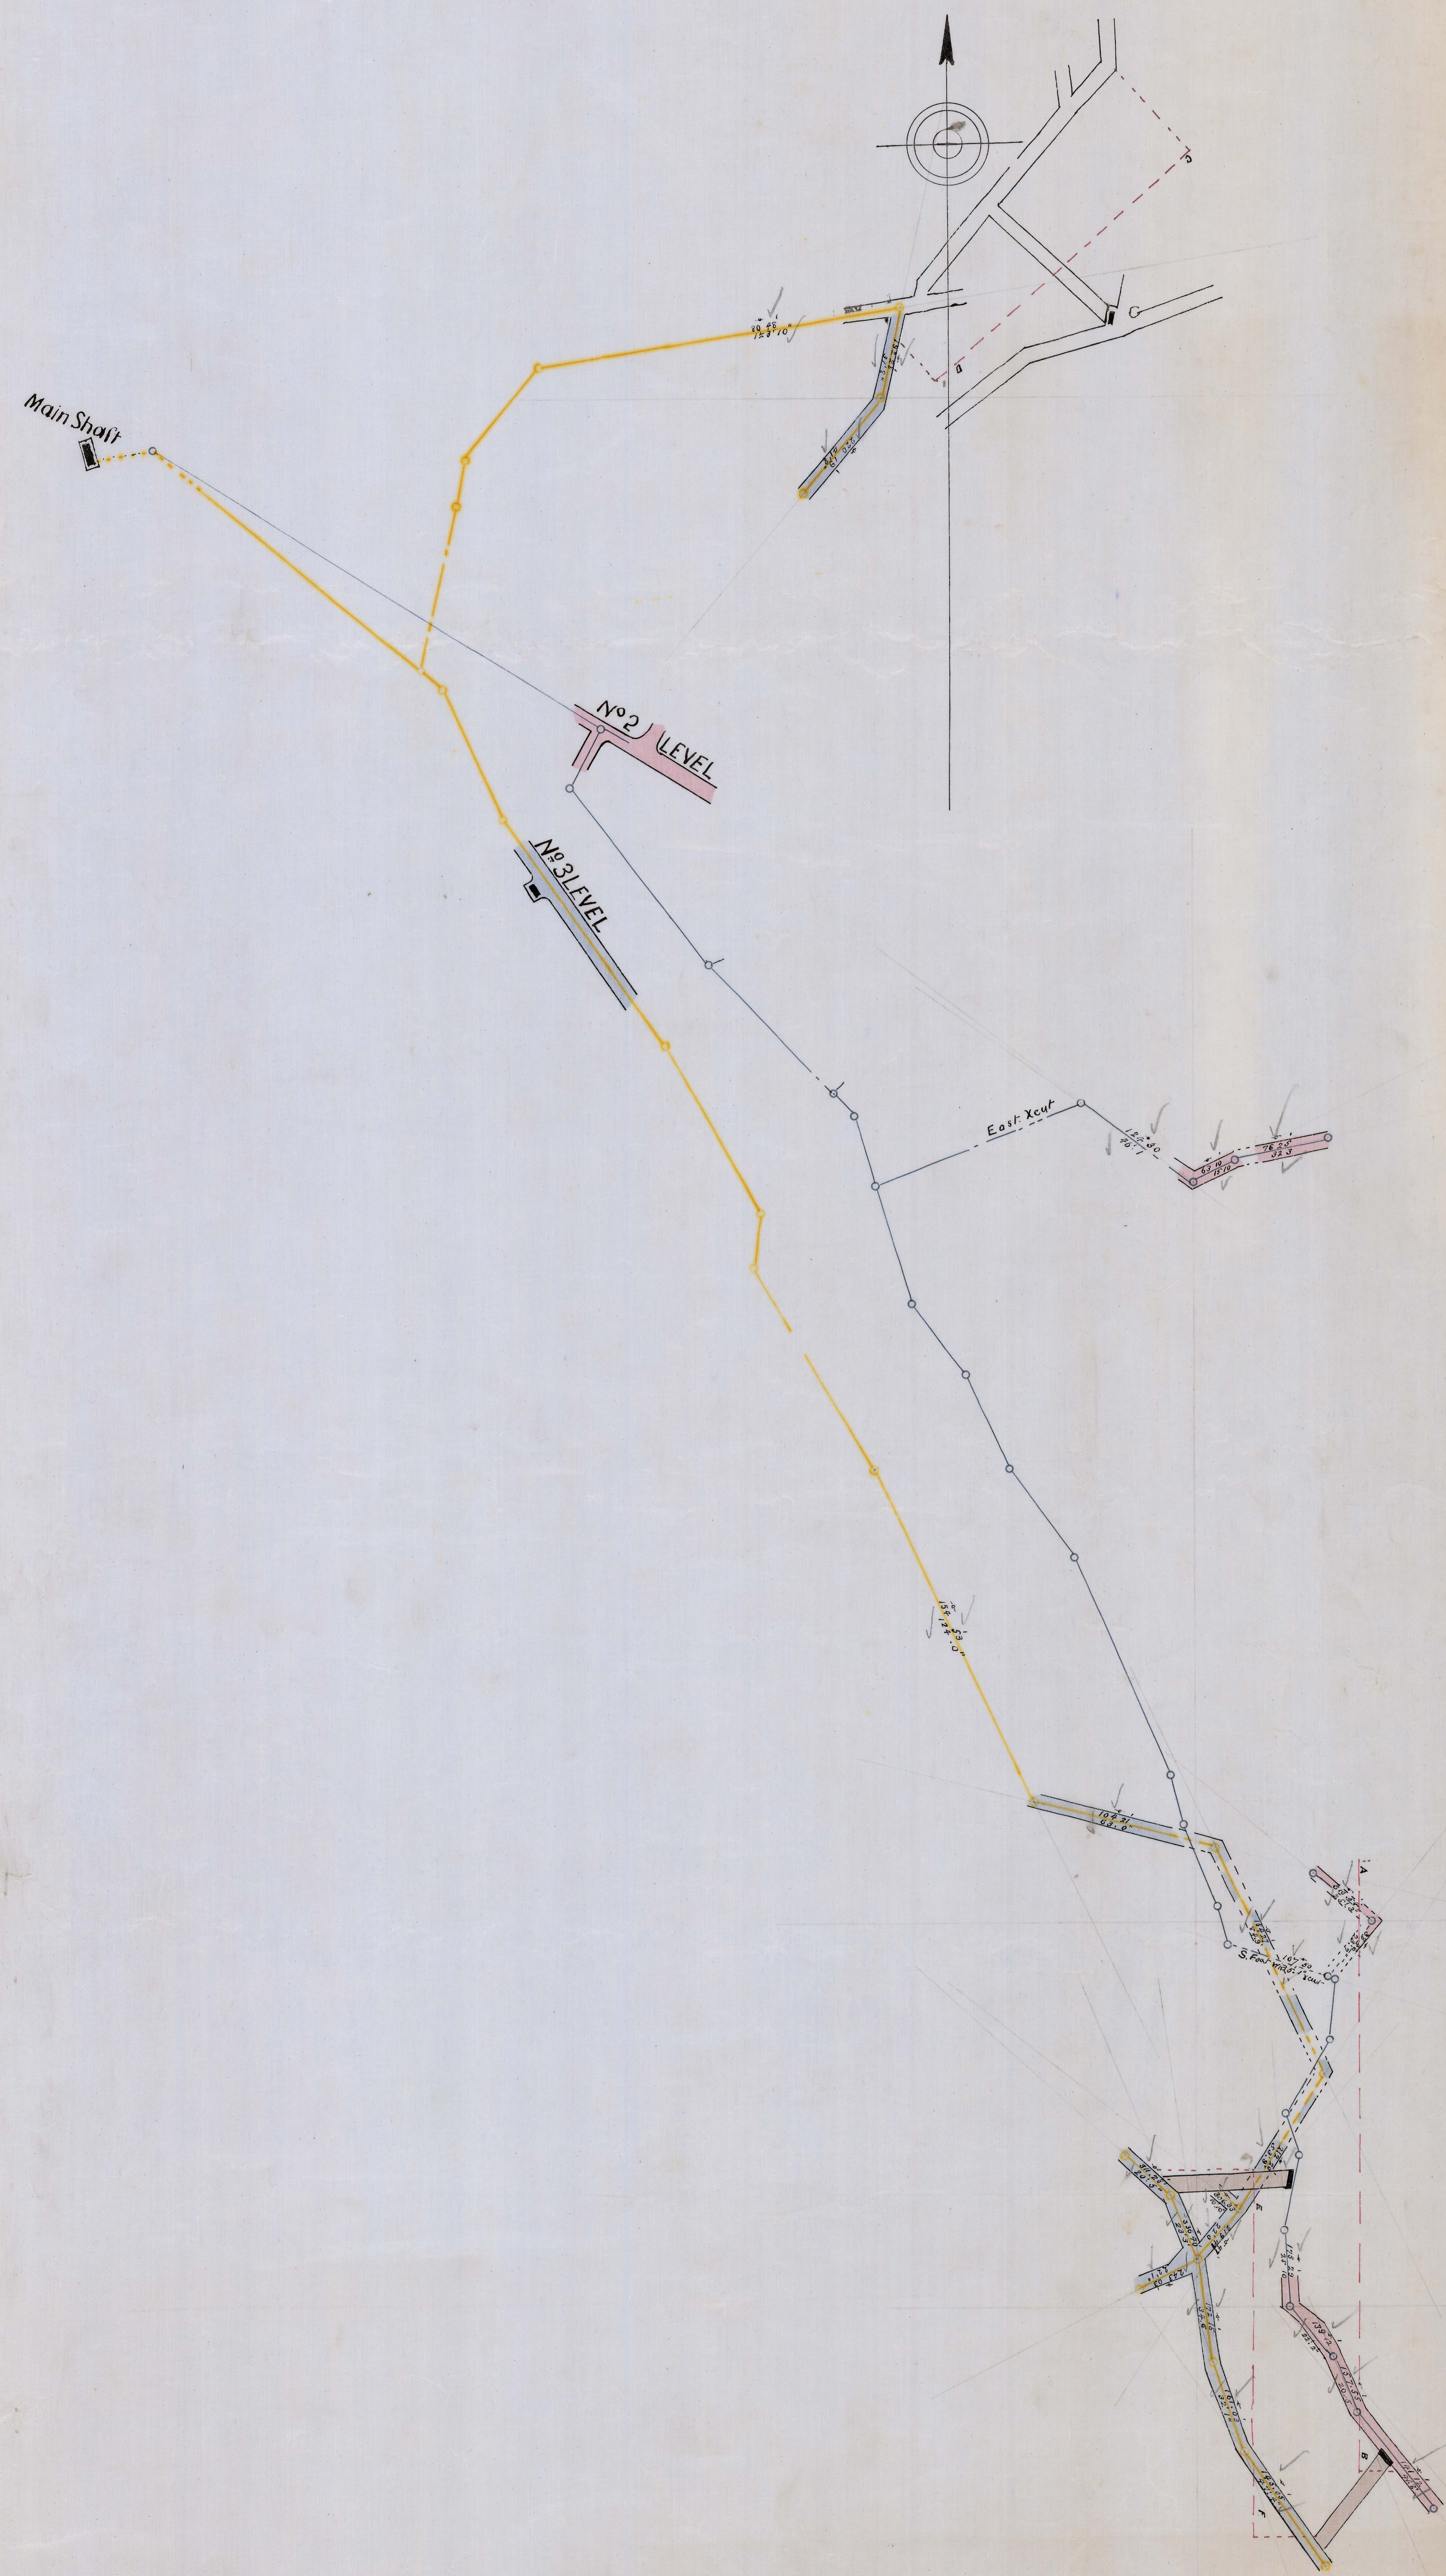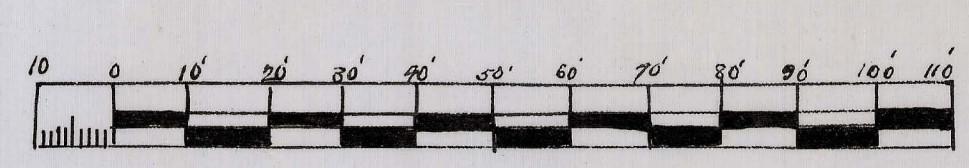

W. A. Briggs



355
-18

355
-18