


0355T-024

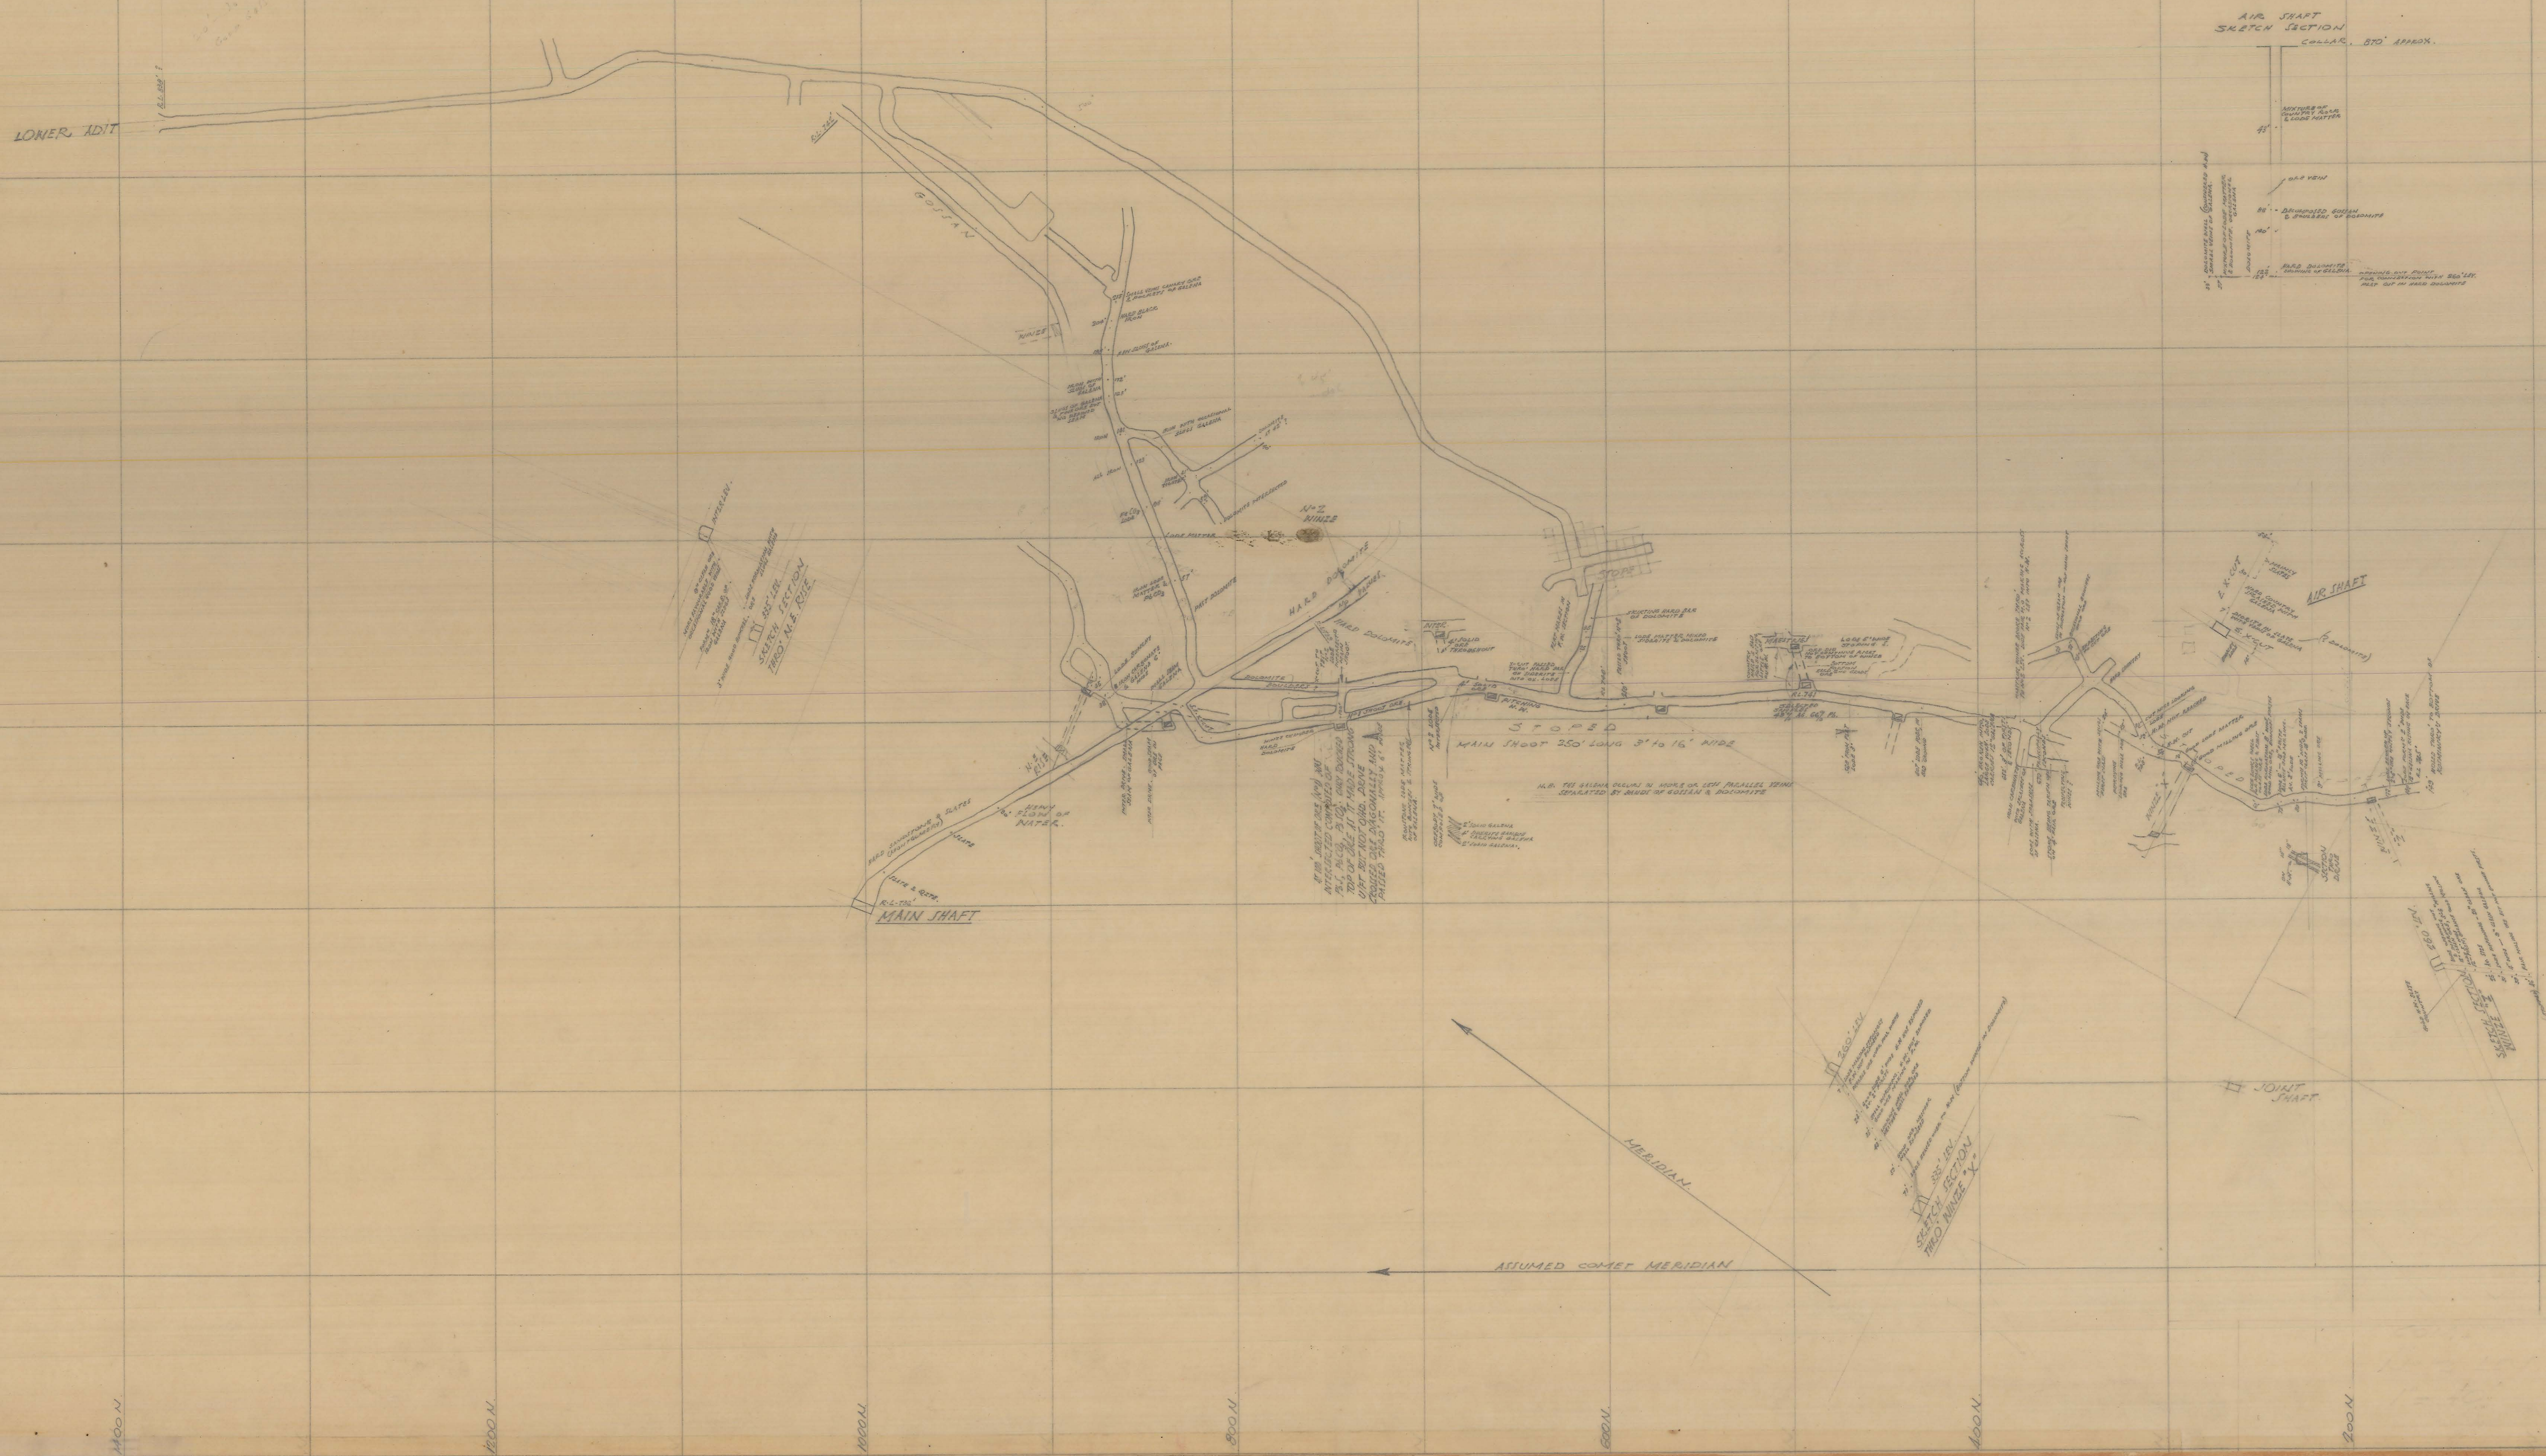

SCALE: 1" = 40'

COMET MINE
No 2 LEVEL HORIZON

No 1-C/4
DATE: APR. '43

7.3.13

667

TRIM PRINT TO THIS BORDER