




5 cm

0355-032

REFERENCES
Main Tunnel
Intermediate Level
Stops

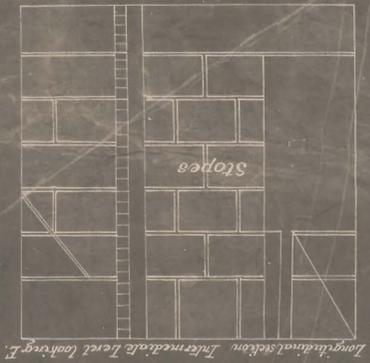

Longitudinal section Intermediate Level looking E.



Cross section of mine looking North

Longitudinal section from lower level looking East

PHOTO THIS SIDE OF RED LINE ONLY

PHOTO THIS SIDE OF RED LINE ONLY

PHOTO THIS SIDE OF RED LINE ONLY

SCALE REDUCTION

EXISTING SCALE
REDUCE TO THIS SCALE

Plan of Miestries Broken Hill S.M.C.
Scale 25 feet to 1 inch



7-3-13

COMET

