


0355_035

— No 1 — No 3
— No 2 — No 4

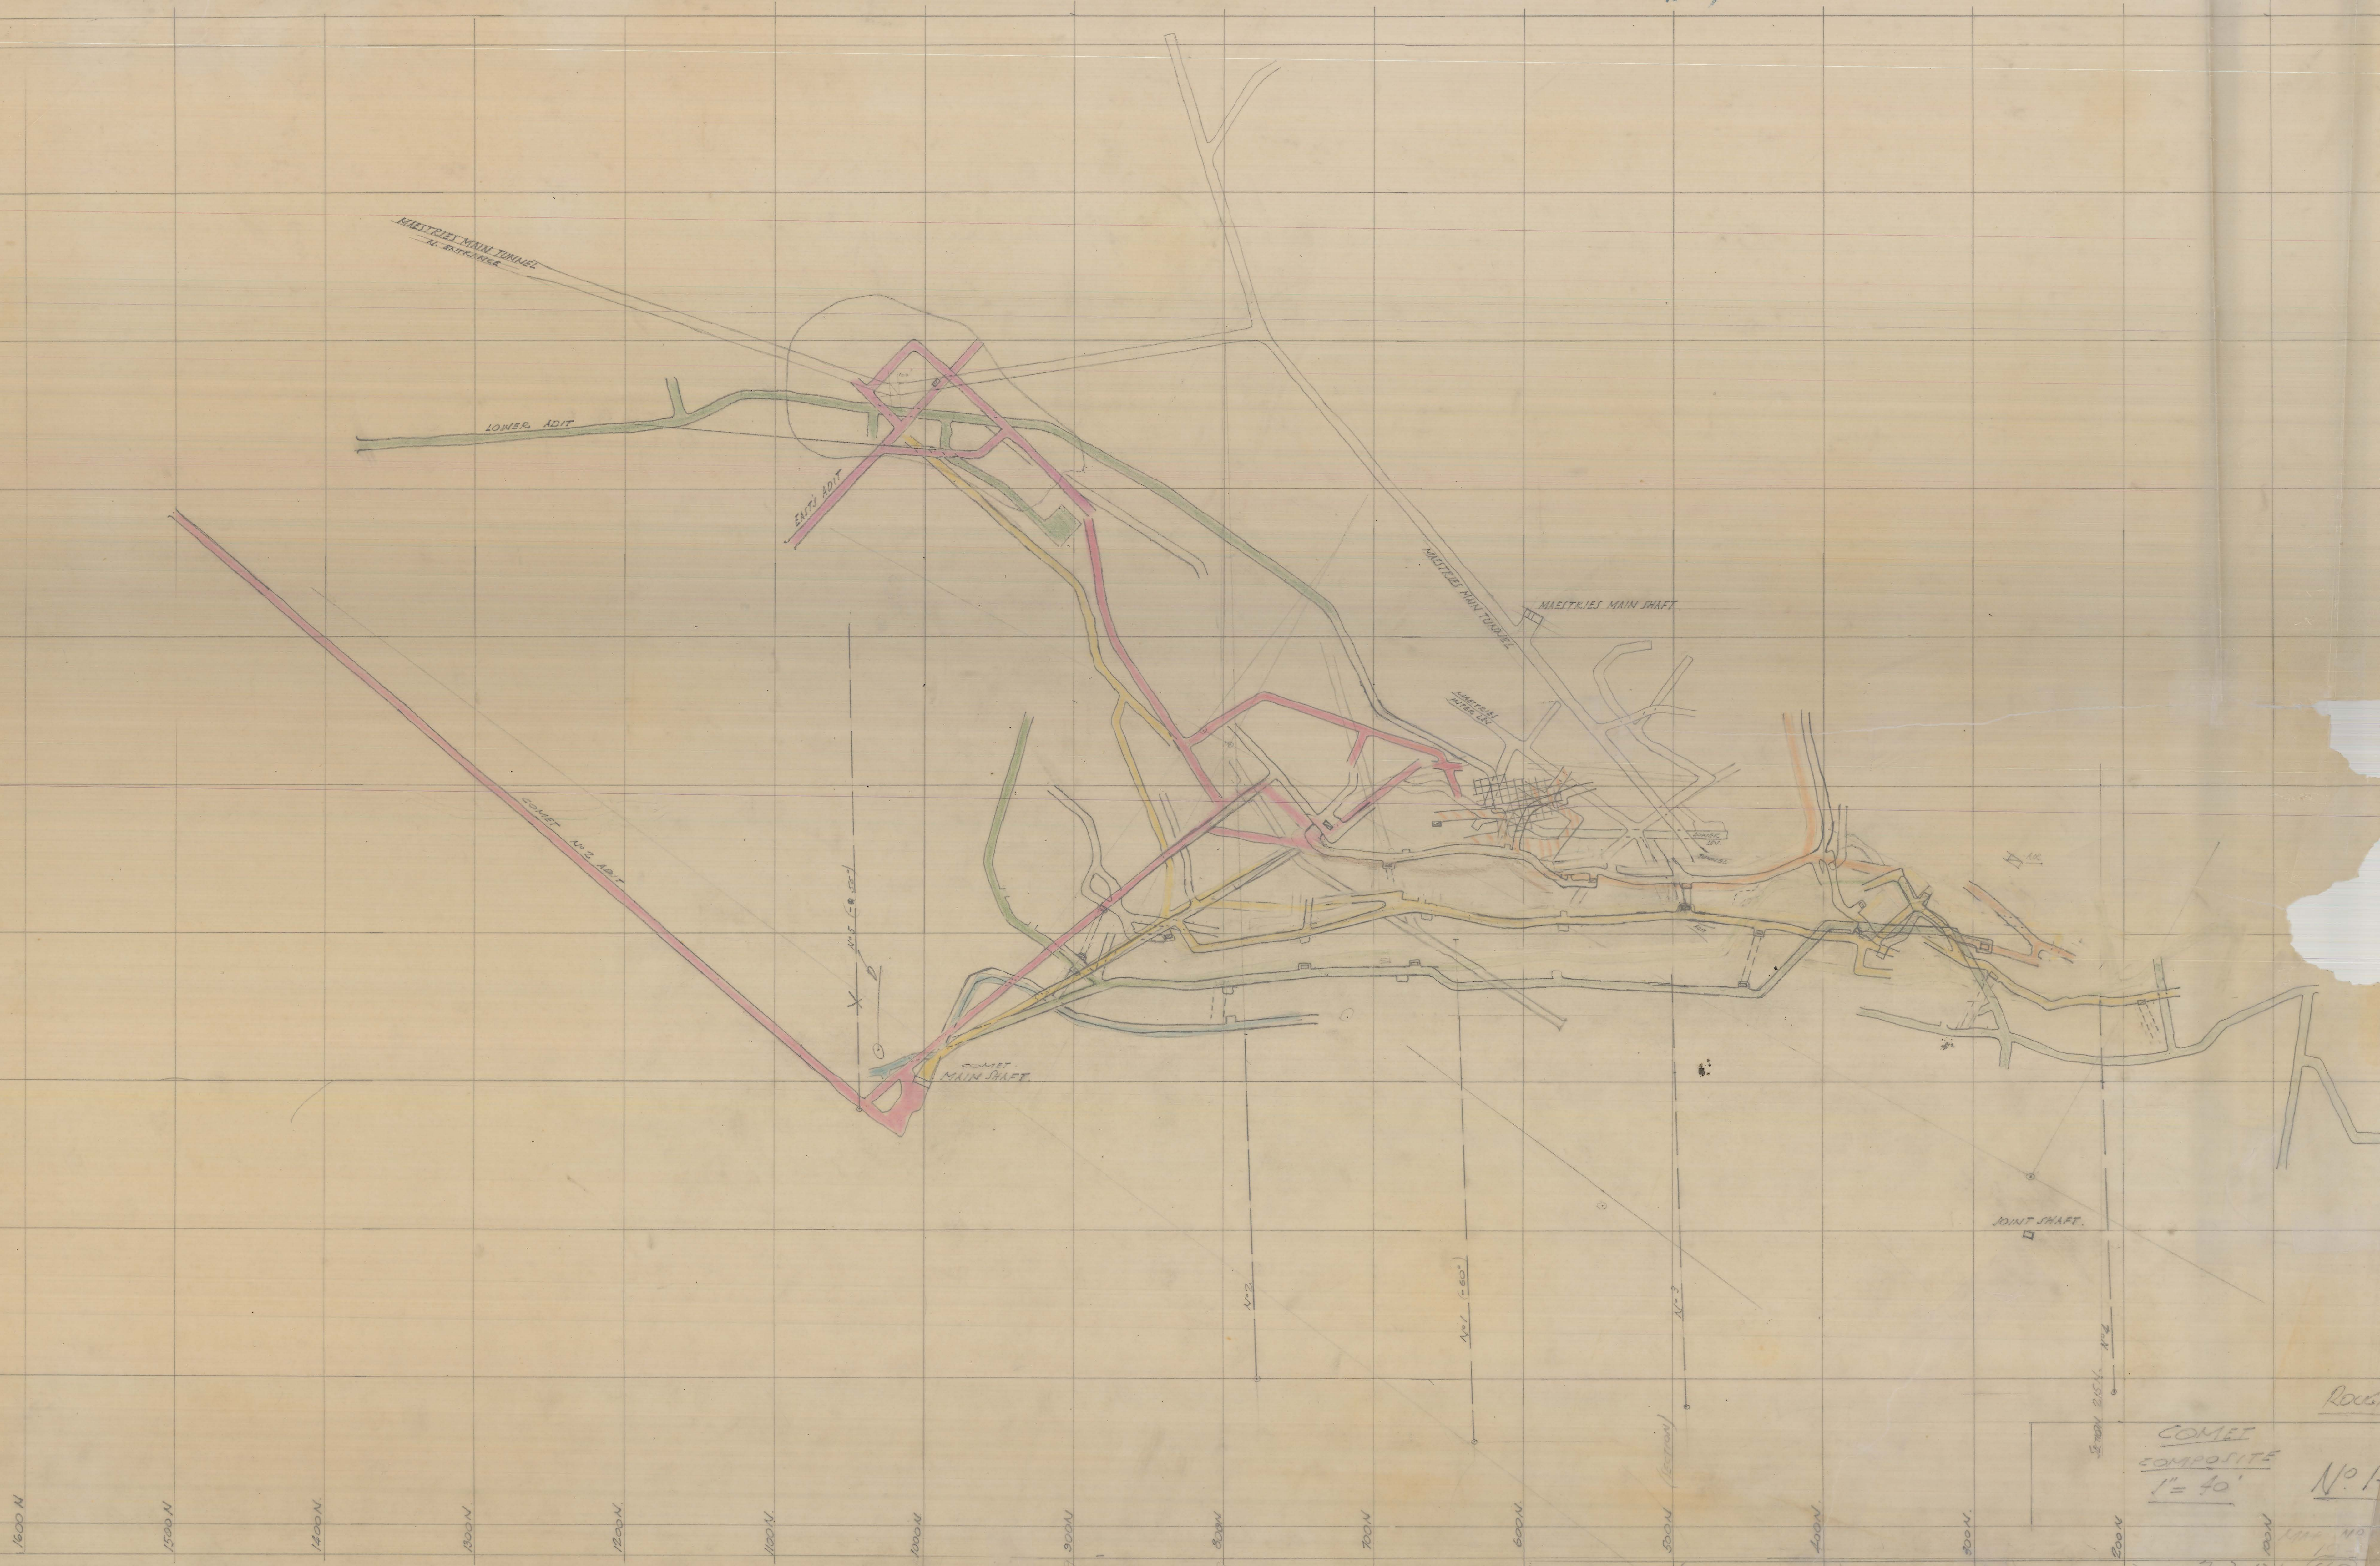

COMET
COMPOSITE
1" = 40'

ROUGH
No 1

7-3-12 (667)