


0355-036

5 cm

4

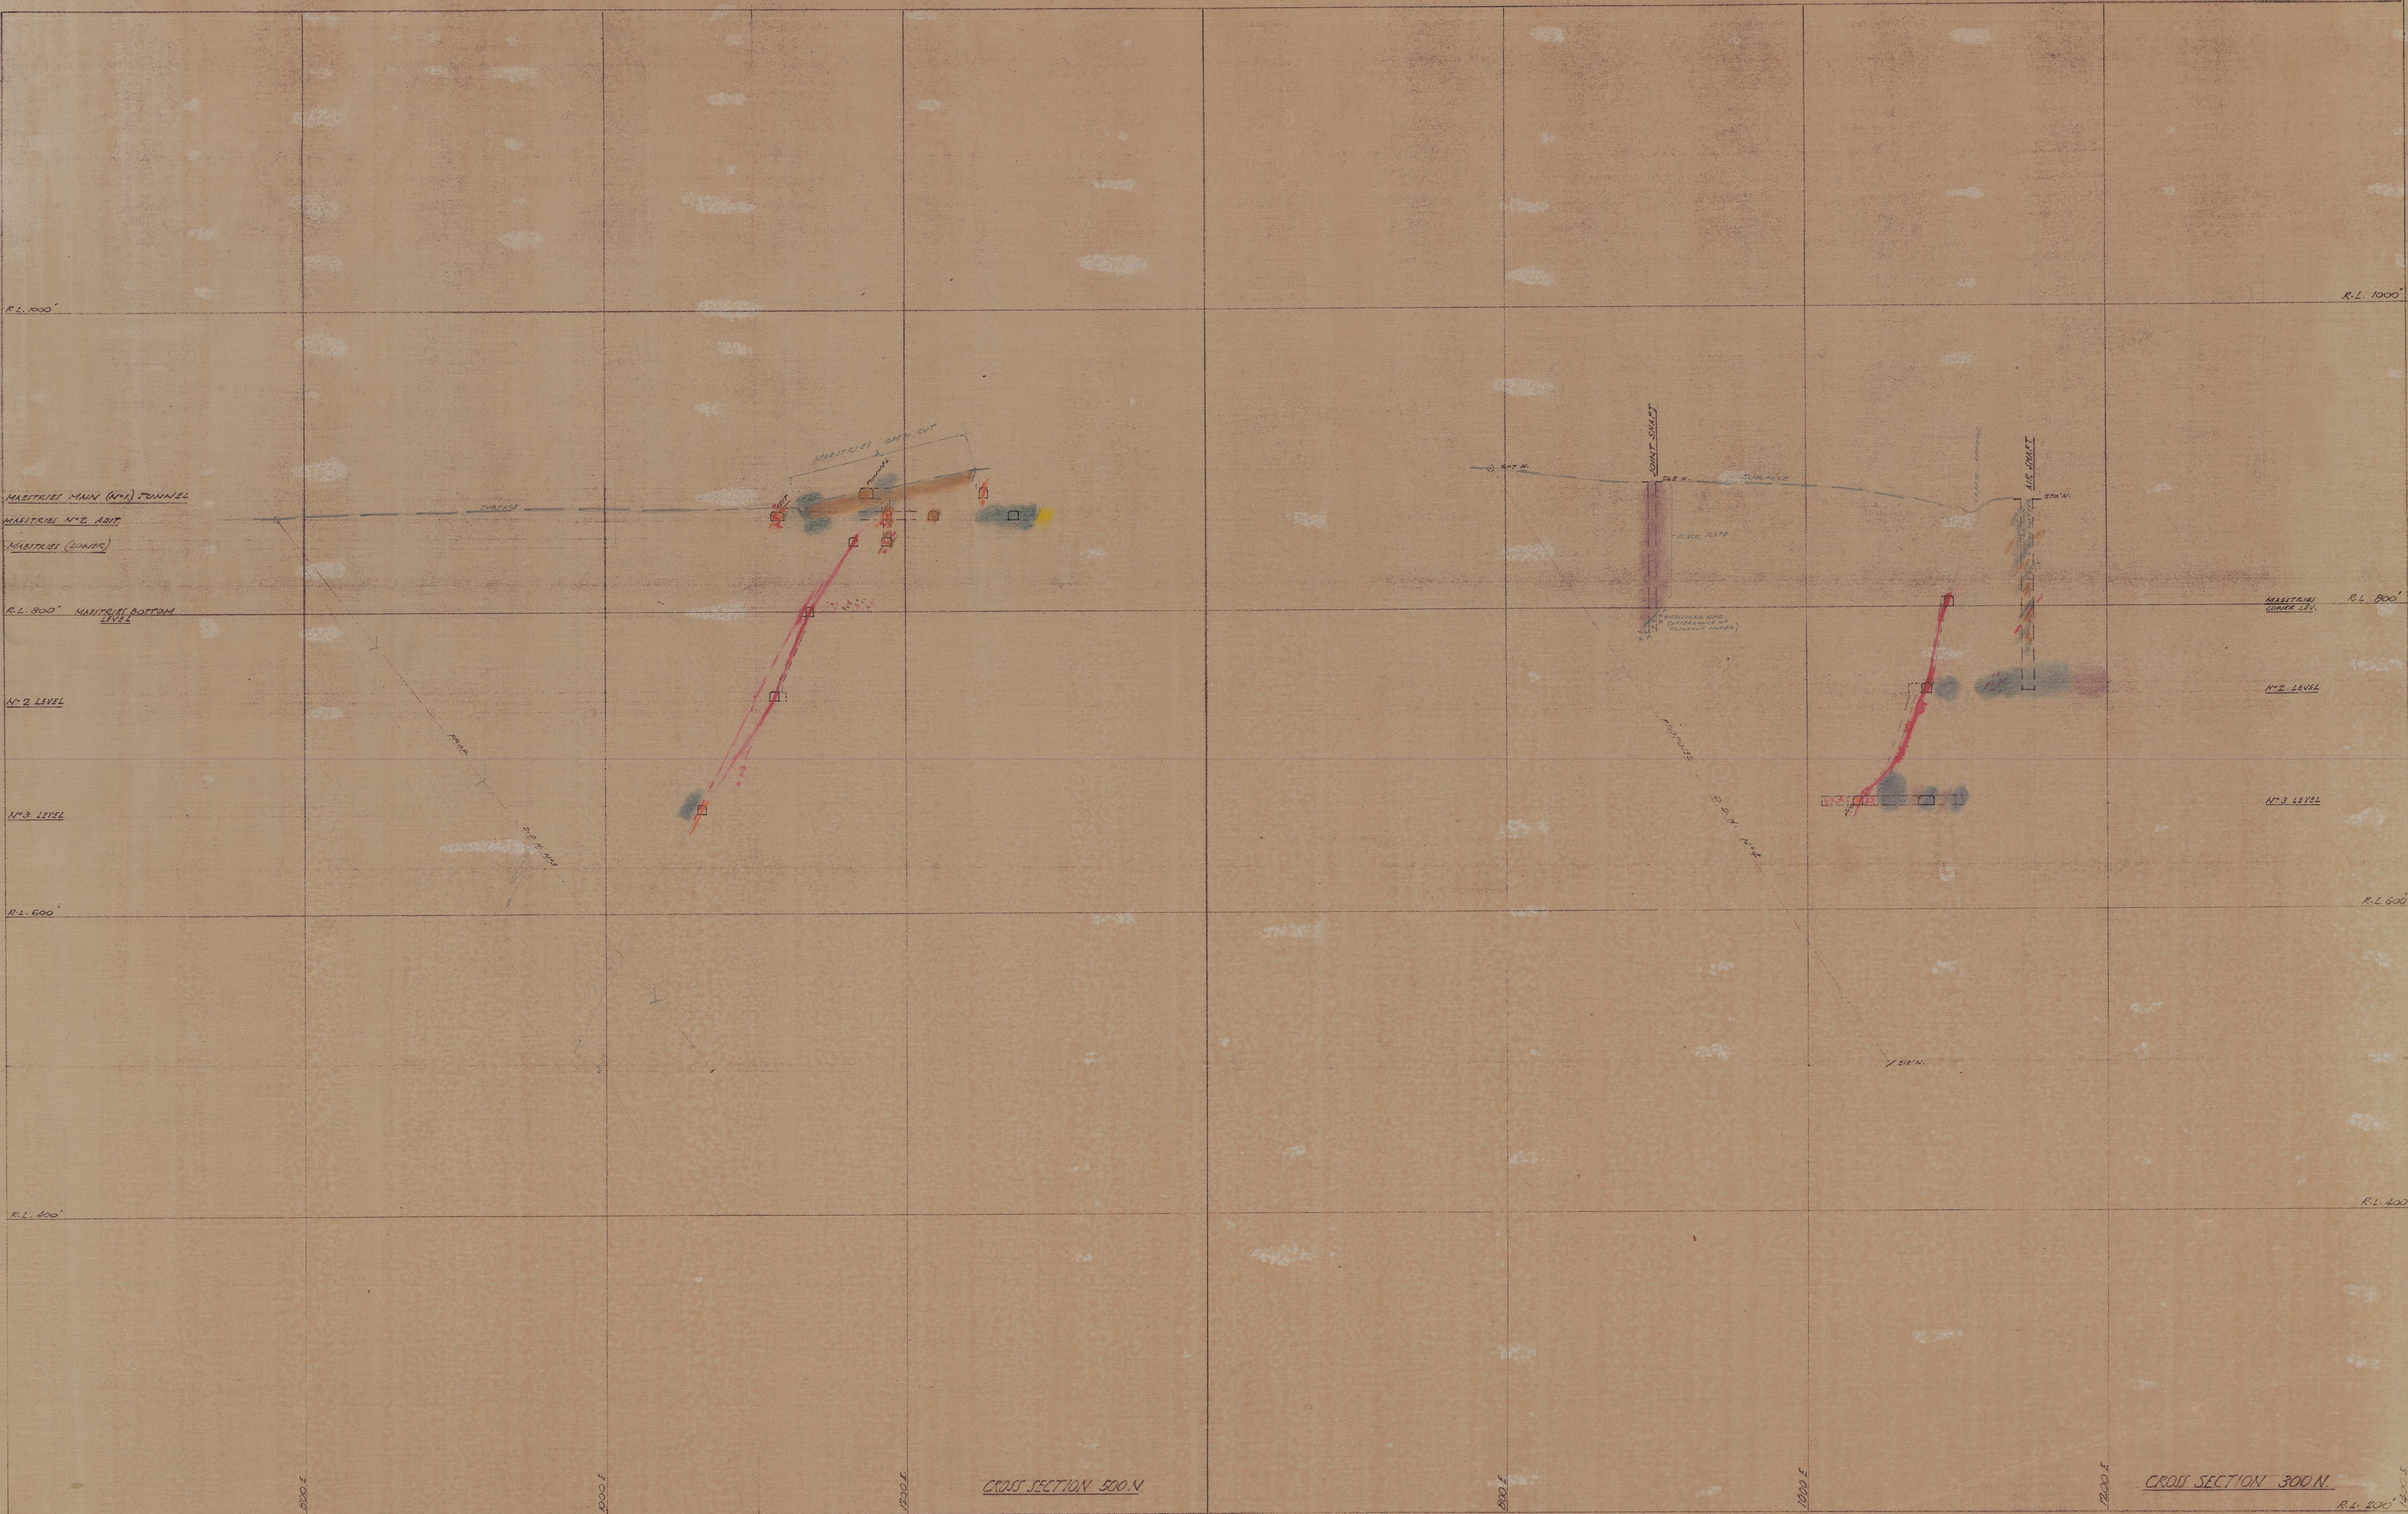

SCALE 1" = 40'

COMET MINE
CROSS SECTIONS 300N & 500N

N°1-C/17
DATE: APR. '48

A.A. MASON

7-3-13

660