TAS. SMELT. Co

PLAN

SCALE 25FT-1IN.

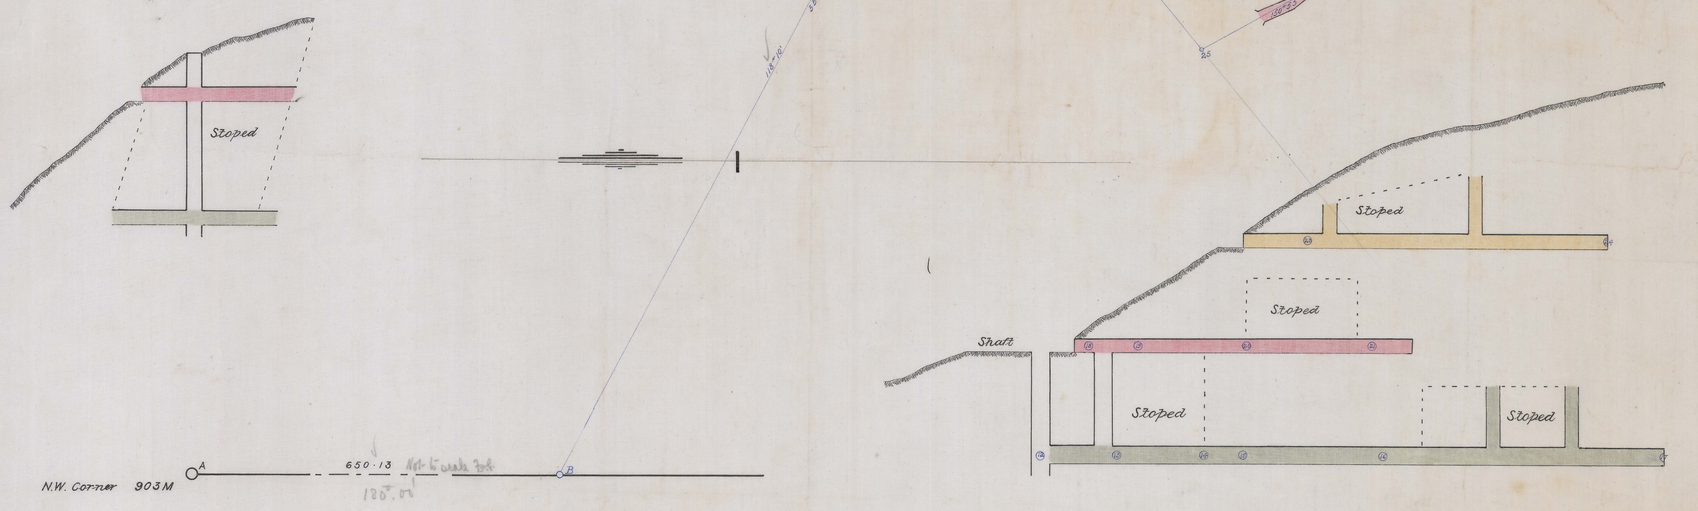

LONGITUDINAL SECTION

A. McIntosh Reid, Surveyor
Inst., 5 inch transit.
28th April, 1909.

GOVERNMENT GEOLOGIST
MAY - 6 1909
LAUNCESTON

356
01