SYLVESTER. S. L. M. Co.

820
87M

SCALE 30 FEET TO AN INCH

W. H. Westley
24.3.96

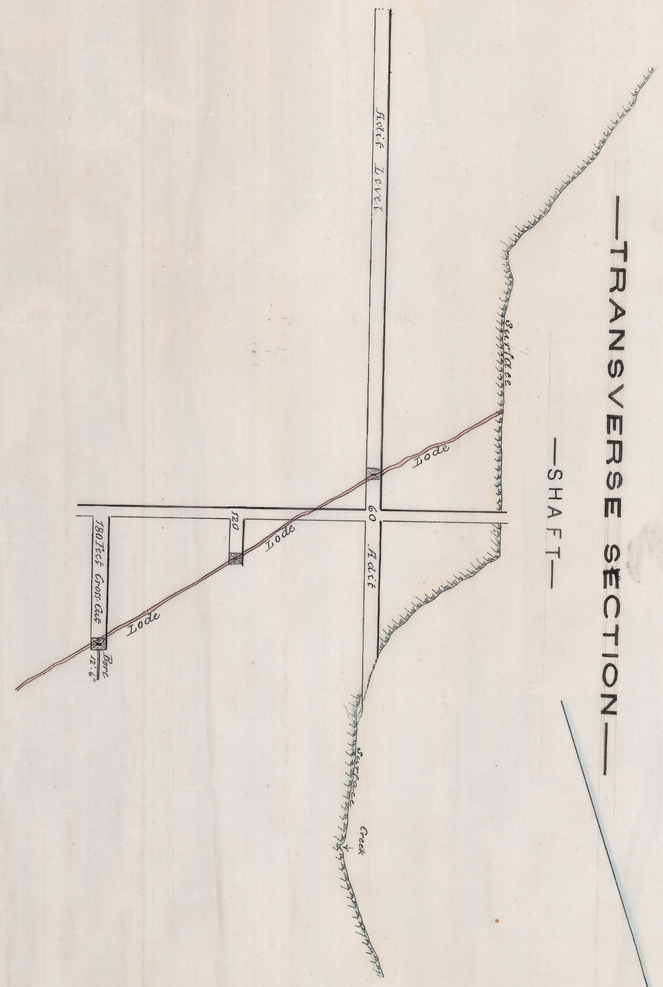

—TRANSVERSE SECTION—

—SHAFT—

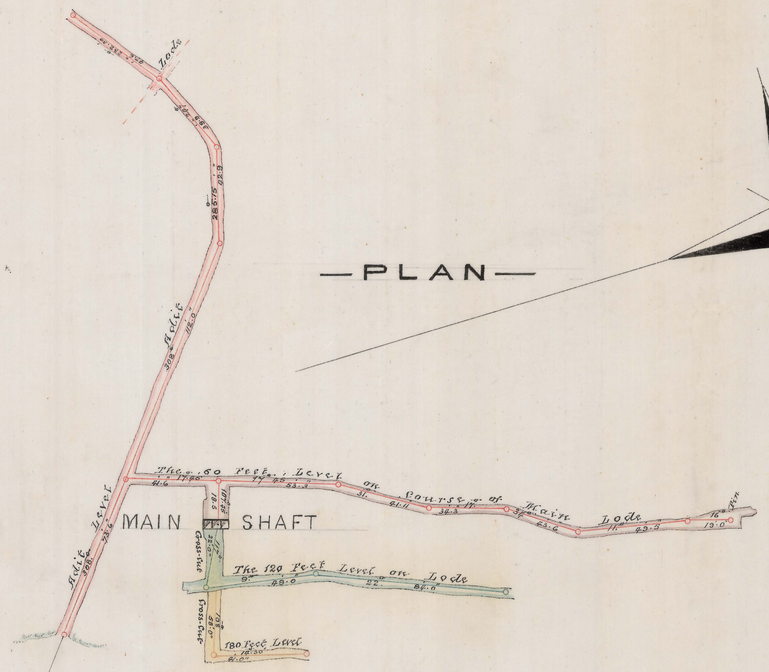

—PLAN—

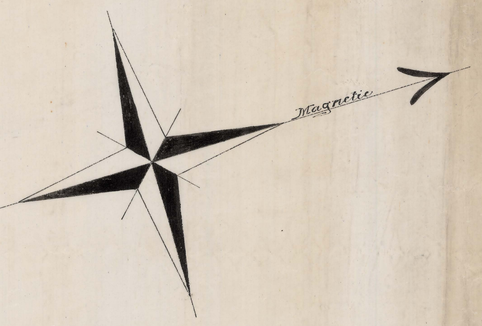

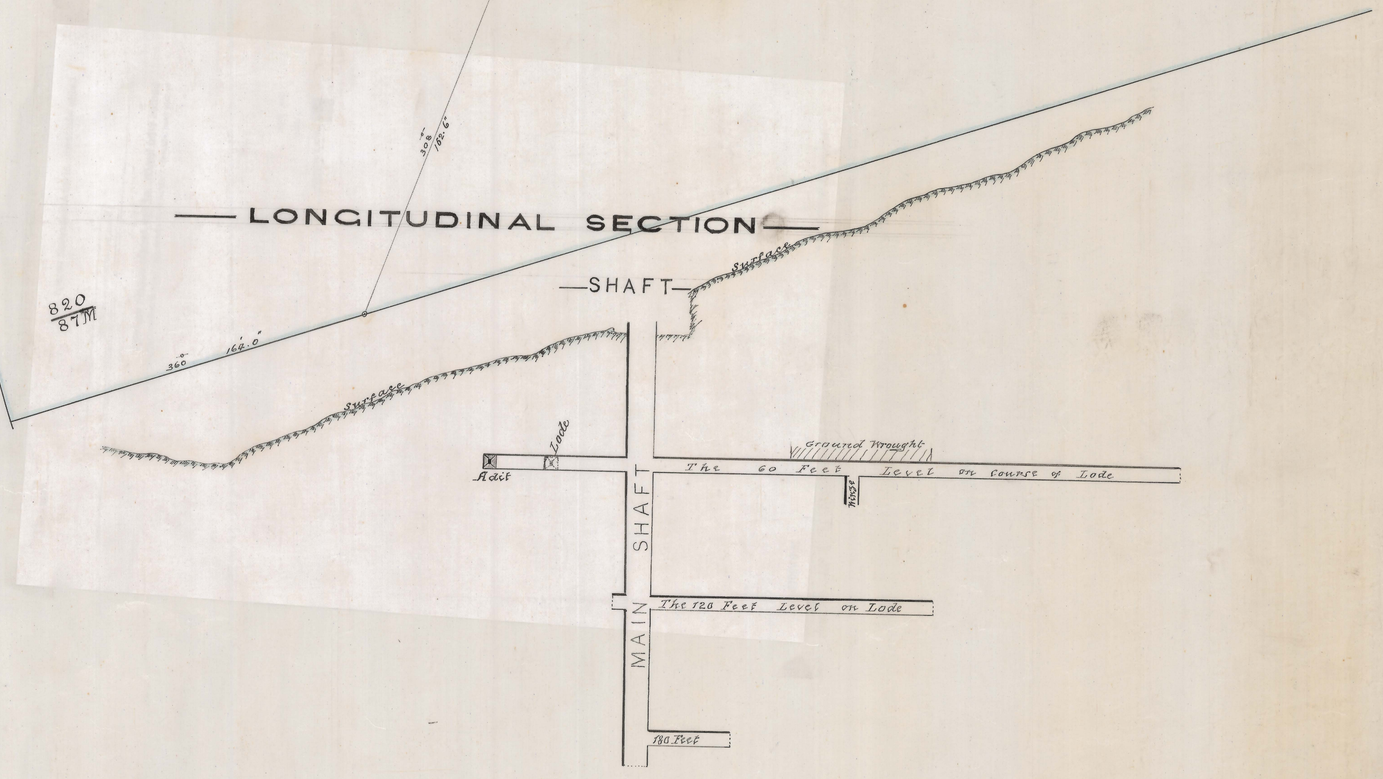

—LONGITUDINAL SECTION—

—SHAFT—

820
87M