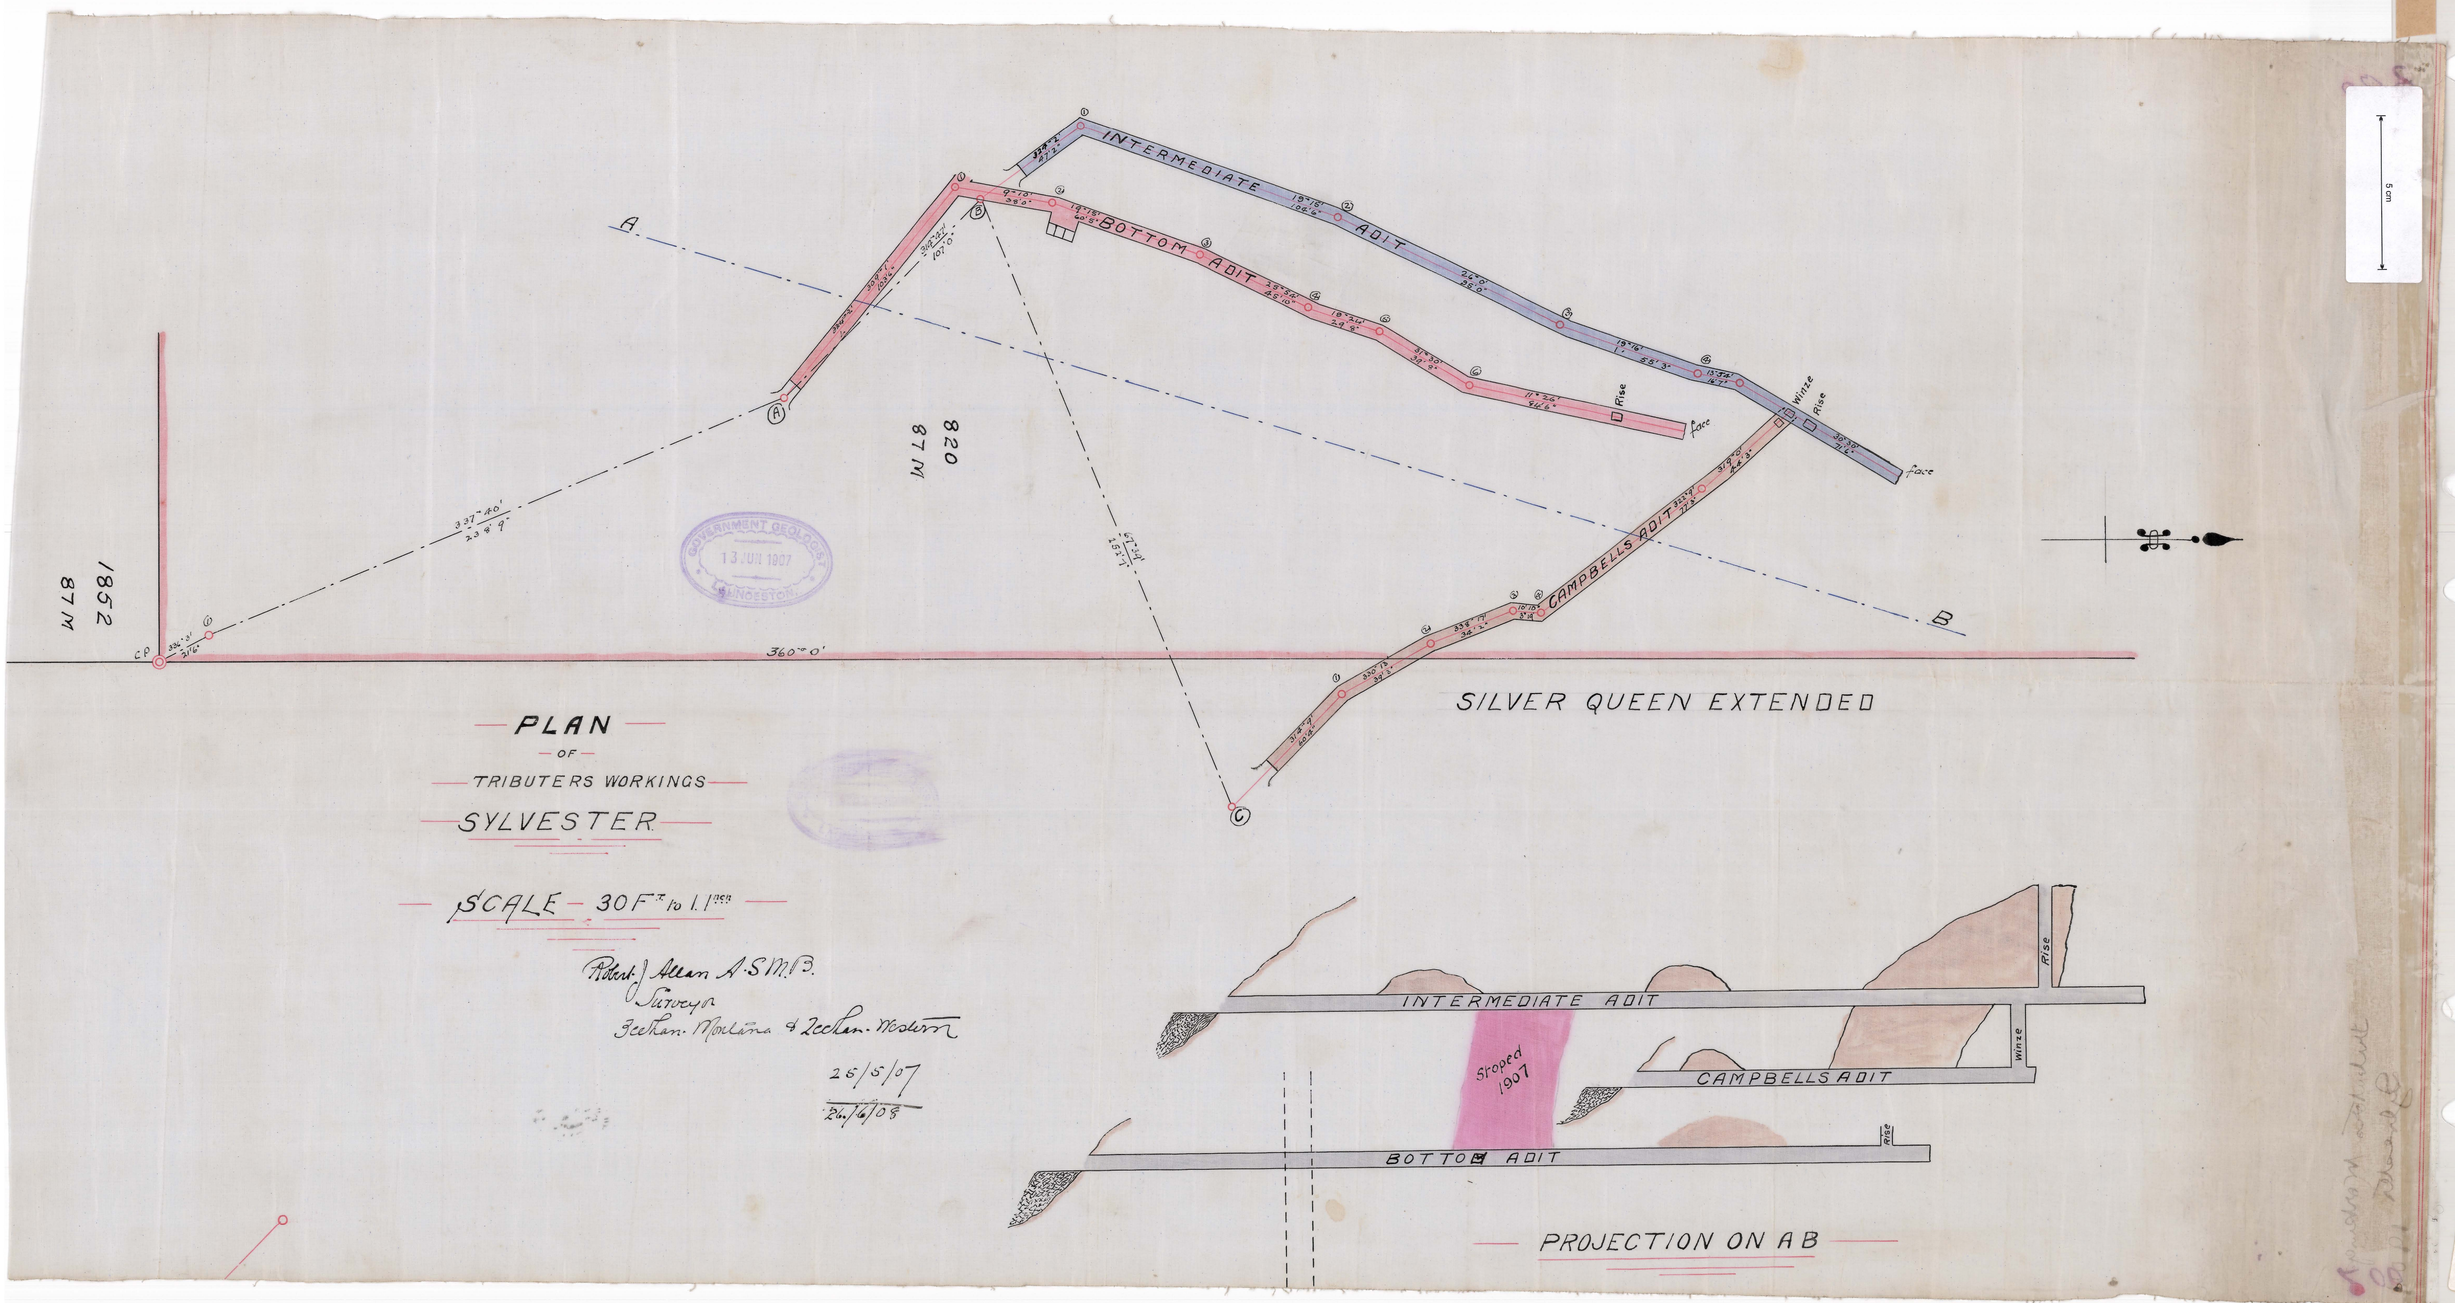

GOVERNMENT GEOLOGIST
13 JUN 1907

PLAN
OF
TRIBUTERS WORKINGS
SYLVESTER

SCALE – 30 Ft to 1 Inch

Robert J. Allen A.S.M.B.
Surveyor

25/5/07
24/6/08

PROJECTION ON AB

Resubmitted with Statement