FLORENCE S.M. Co

underground workings
levels No. 1 and 2 and Curries No. 4
Scale 25 Feet 1 Inch

No. 1 Level
No. 2 Level
Curries No. 4
Shafts

No. 2 Level main Shaft 71ft. 11in.
below Curries bottom Level 144 feet

J. Clinie
Jeehan 27/2/04.

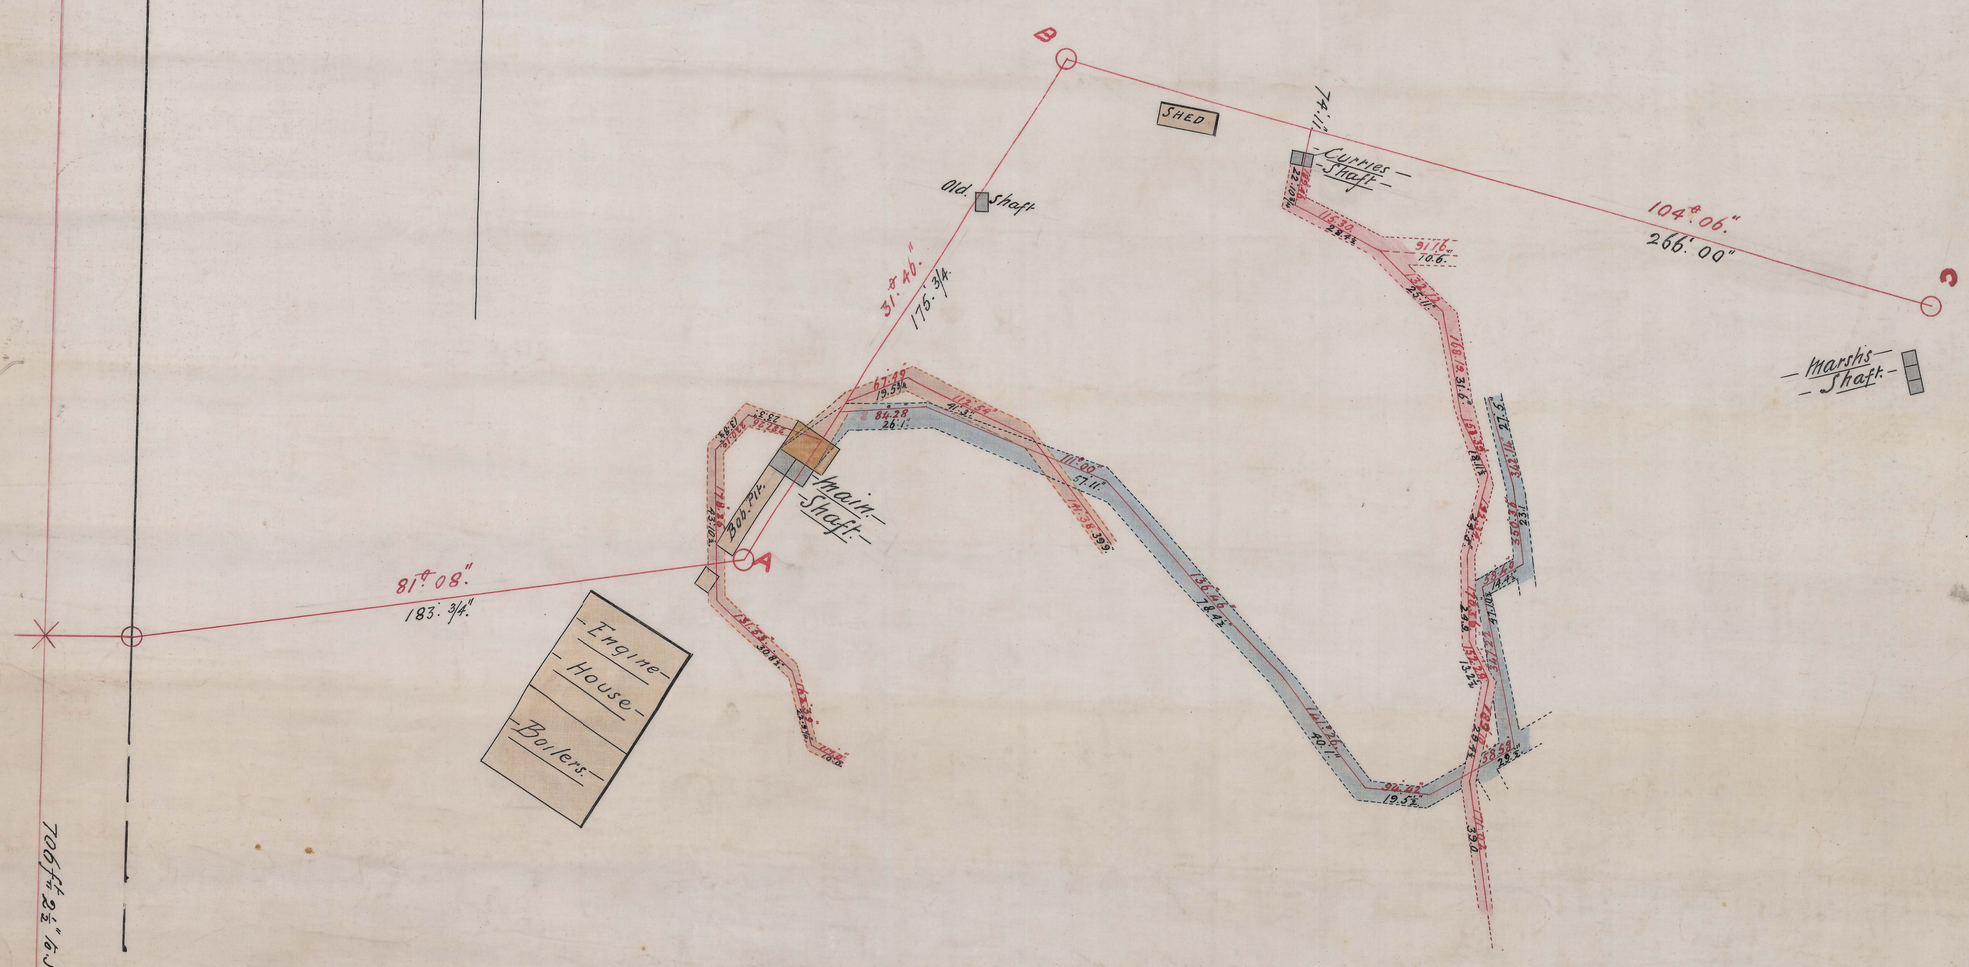

Instrument used Theodolite