FLORENCE S.M.

PLAN

—Scale 25 Feet to 1 Inch—

LONGITUDINAL SECTION

—FACING WEST—

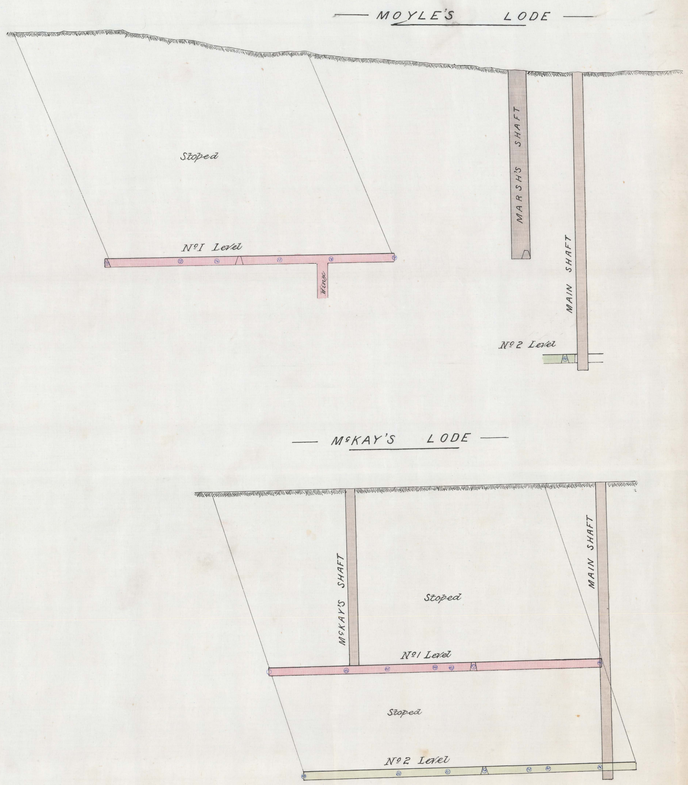

A. McSchlosh Reid
Surveyor.
Surveyed 28th Aug. 1908. Scale 25 feet to 1 Inch.