
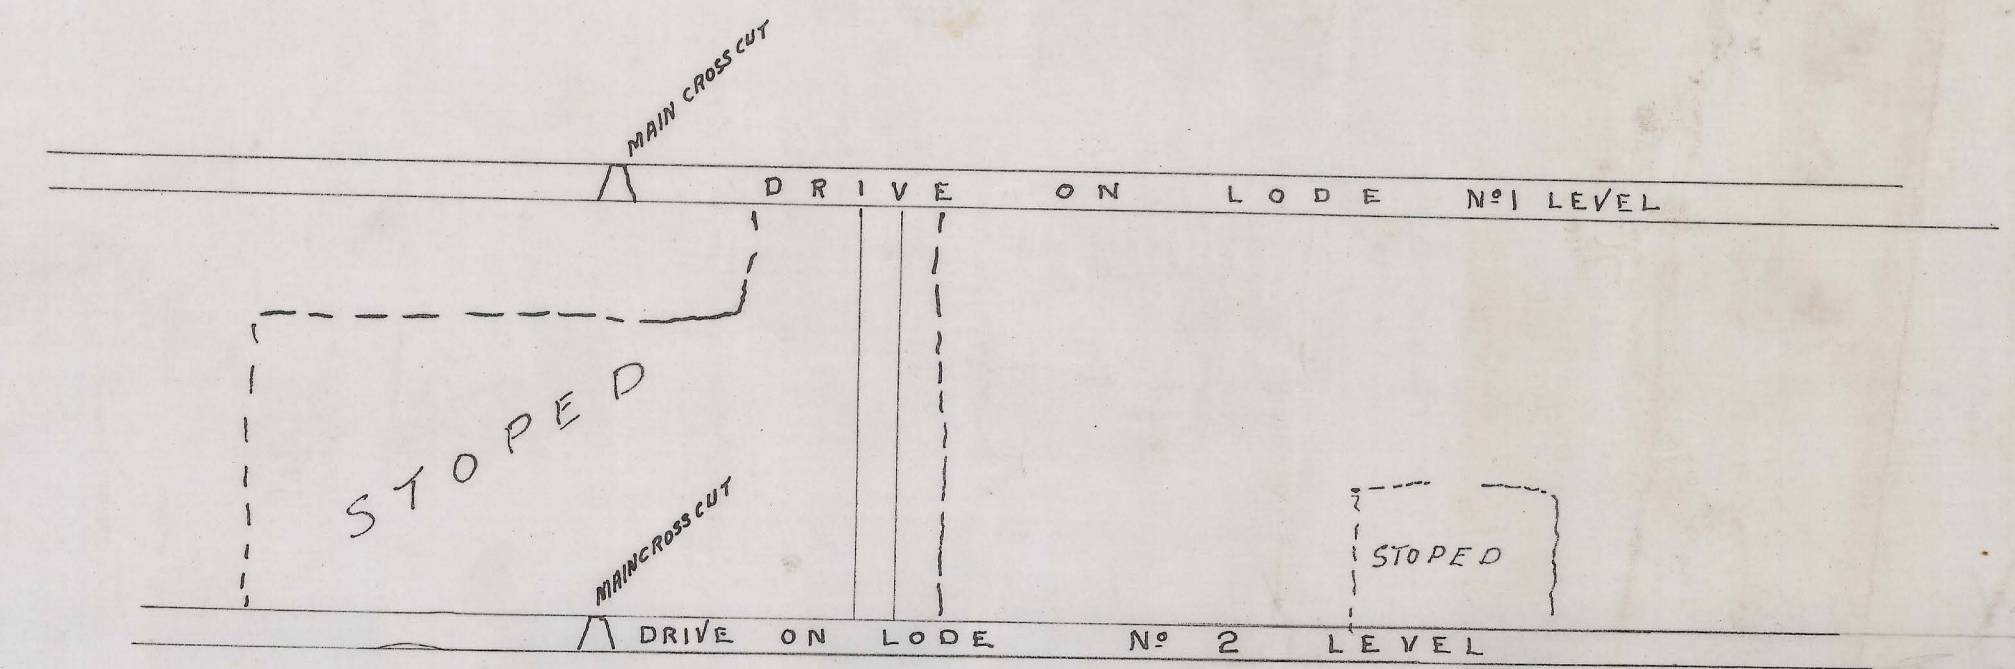


360
02

5 cm

MONTAGU No 1. S.M.
SCALE 30 FEET TO ONE INCH

28

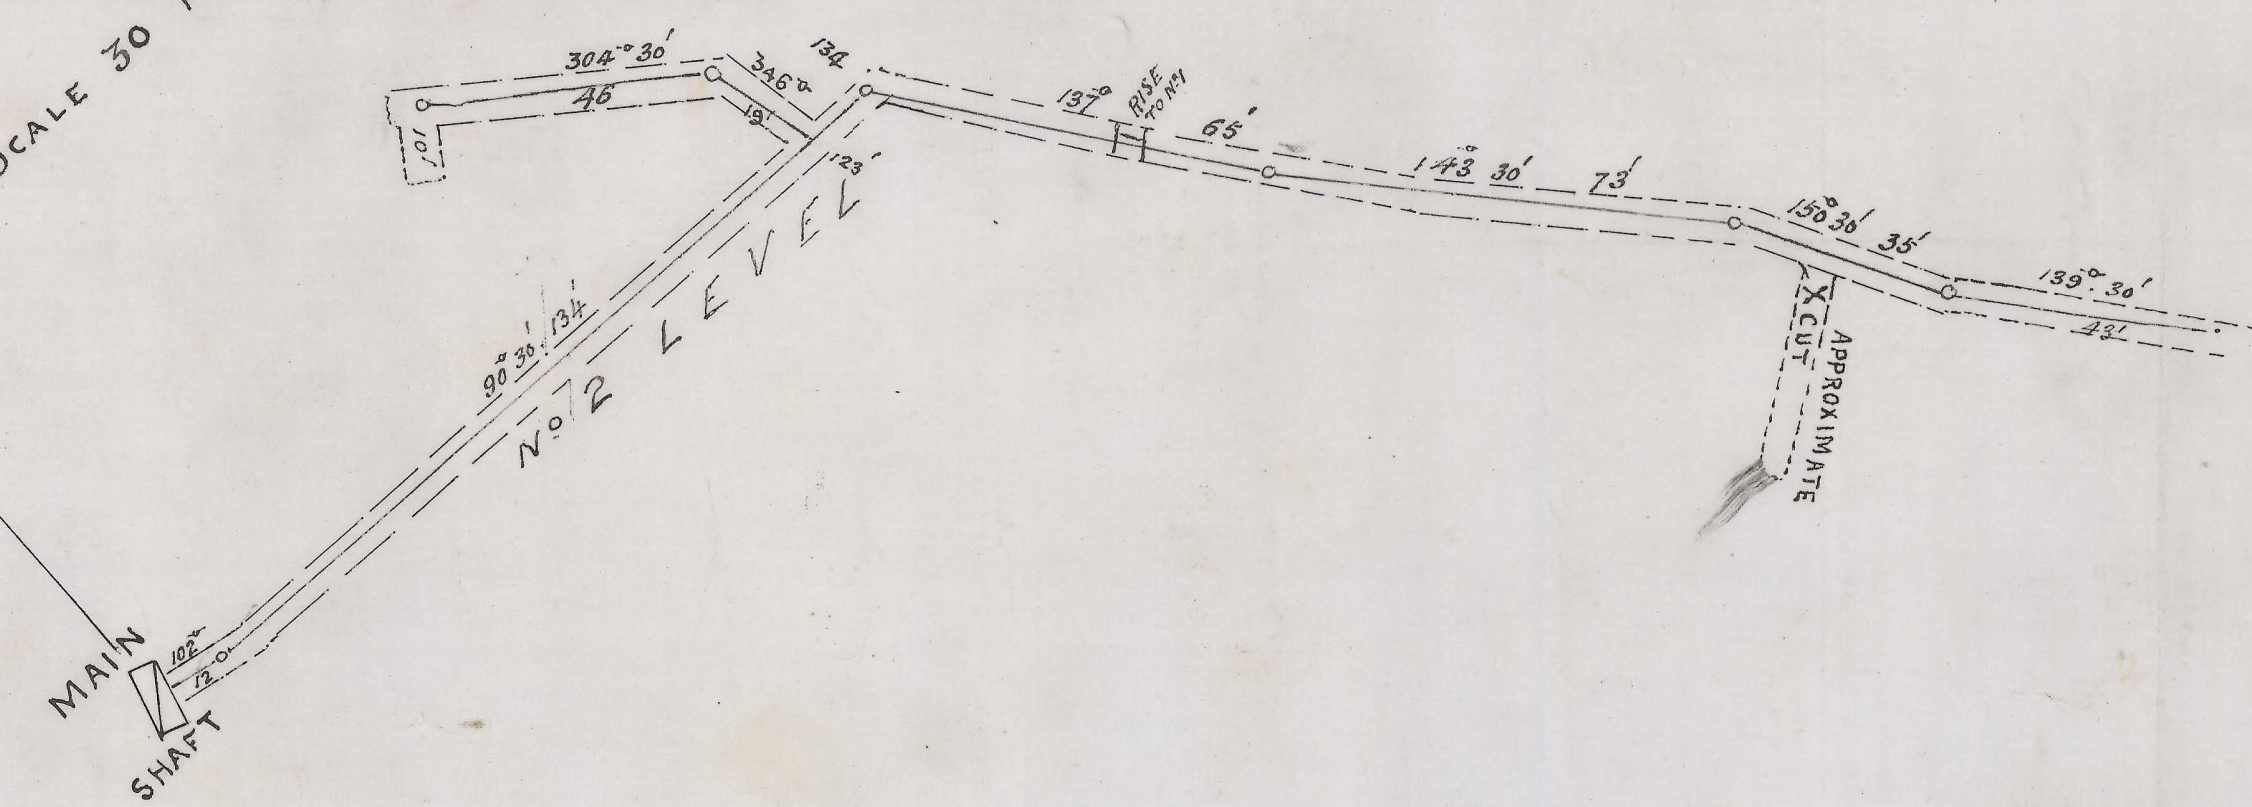

LONGITUDINAL SECTION

Montagu No 1
Longitudinal Section

360
02