


360
04

5 cm

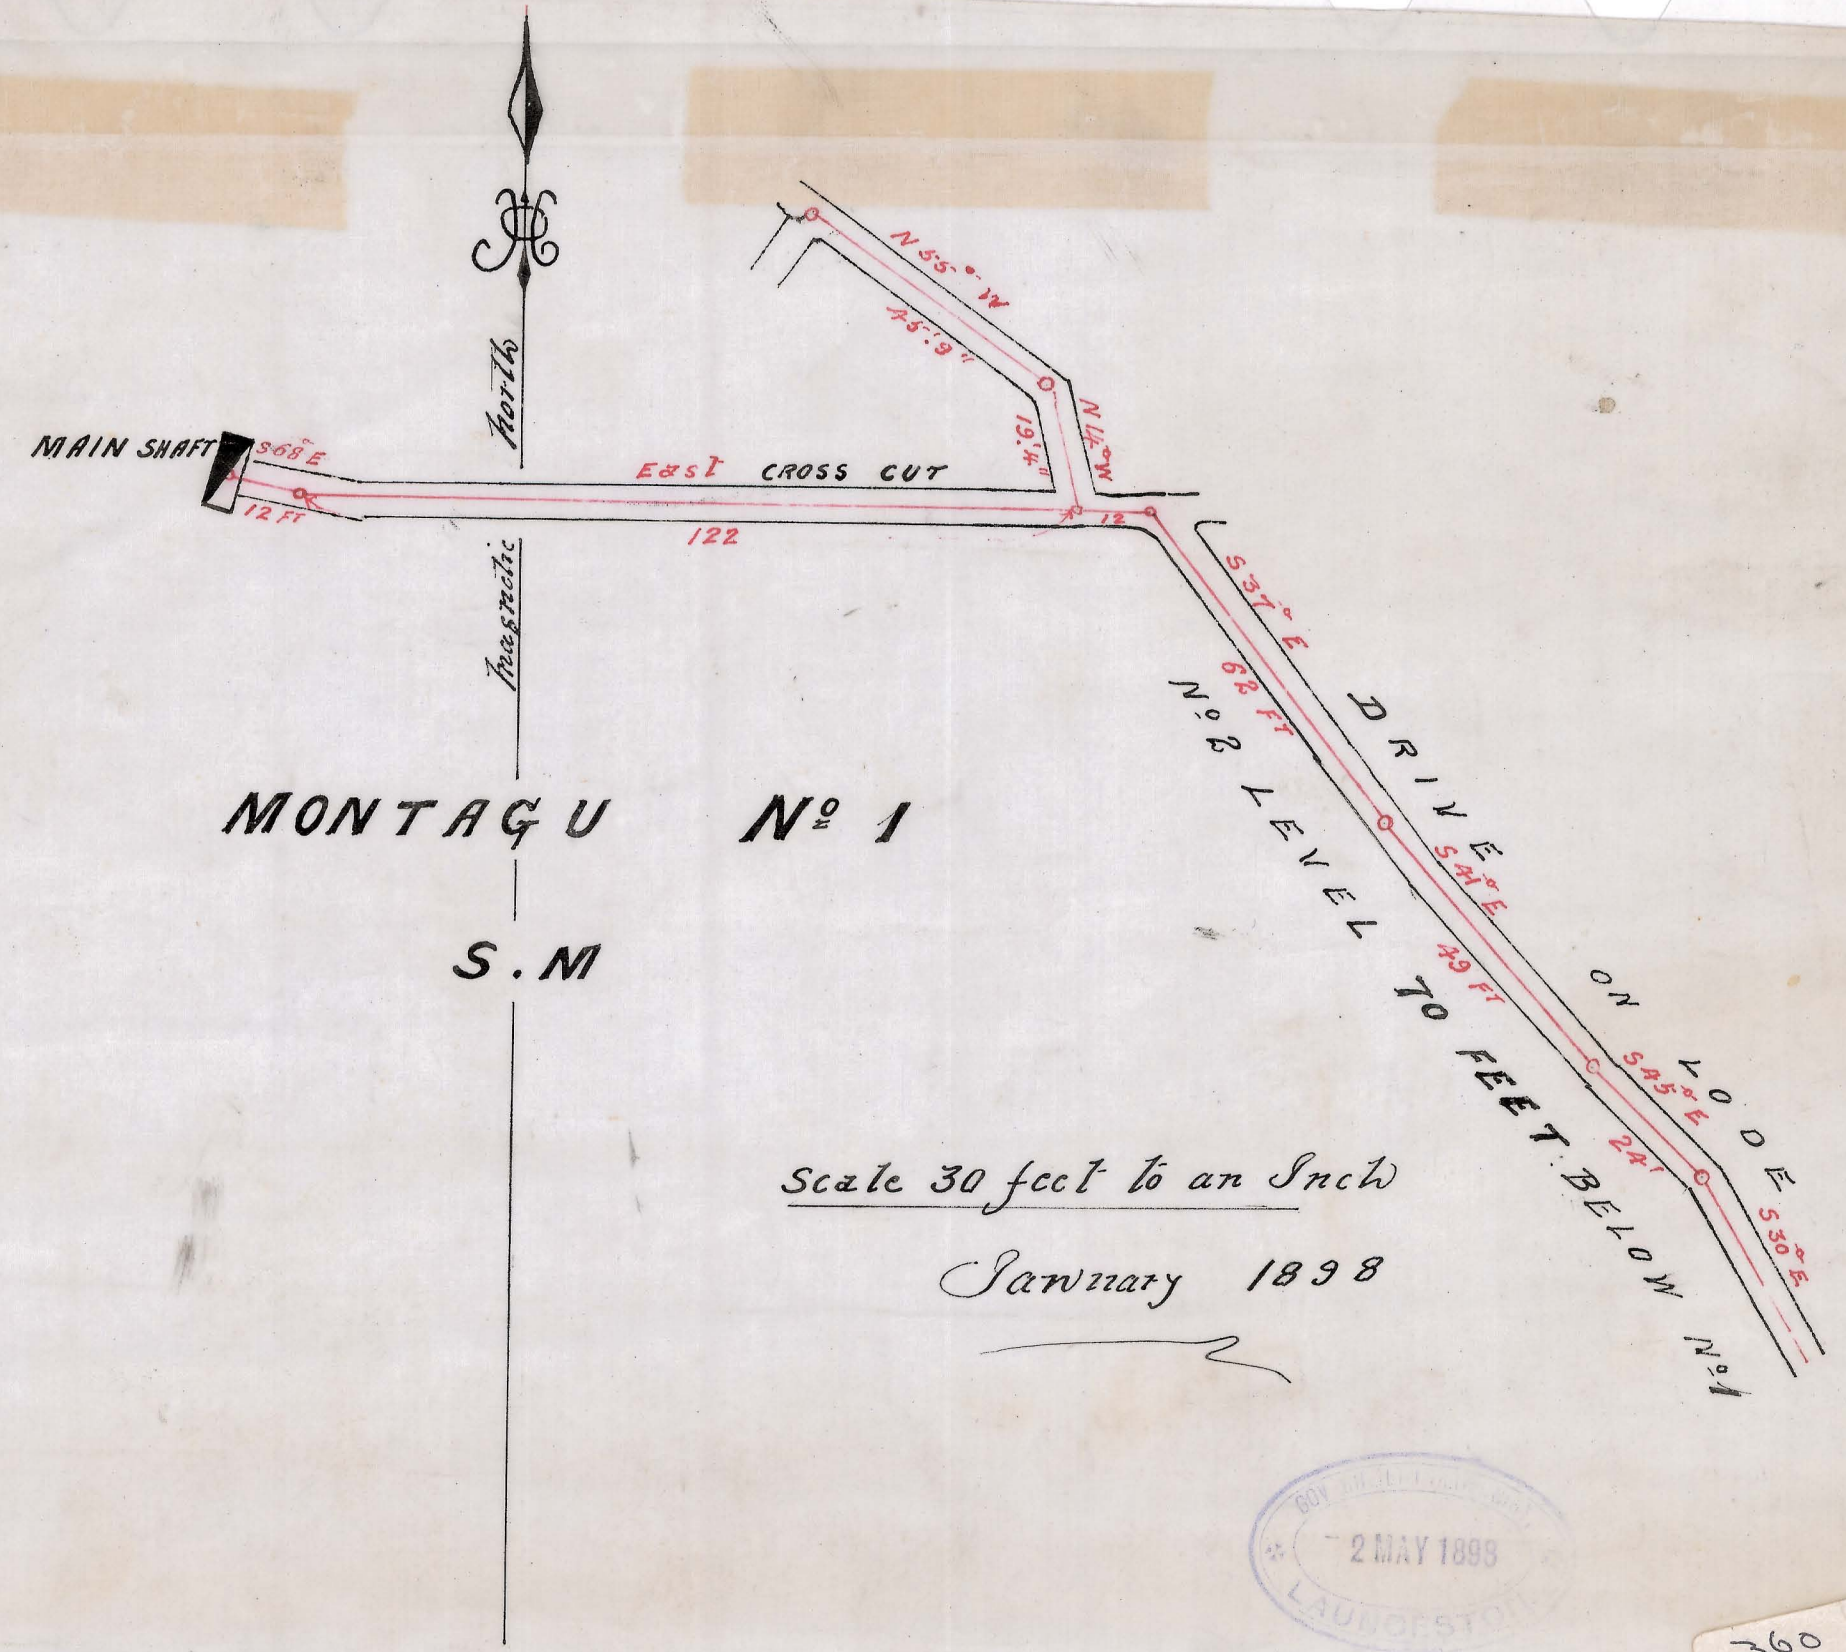

360
04