
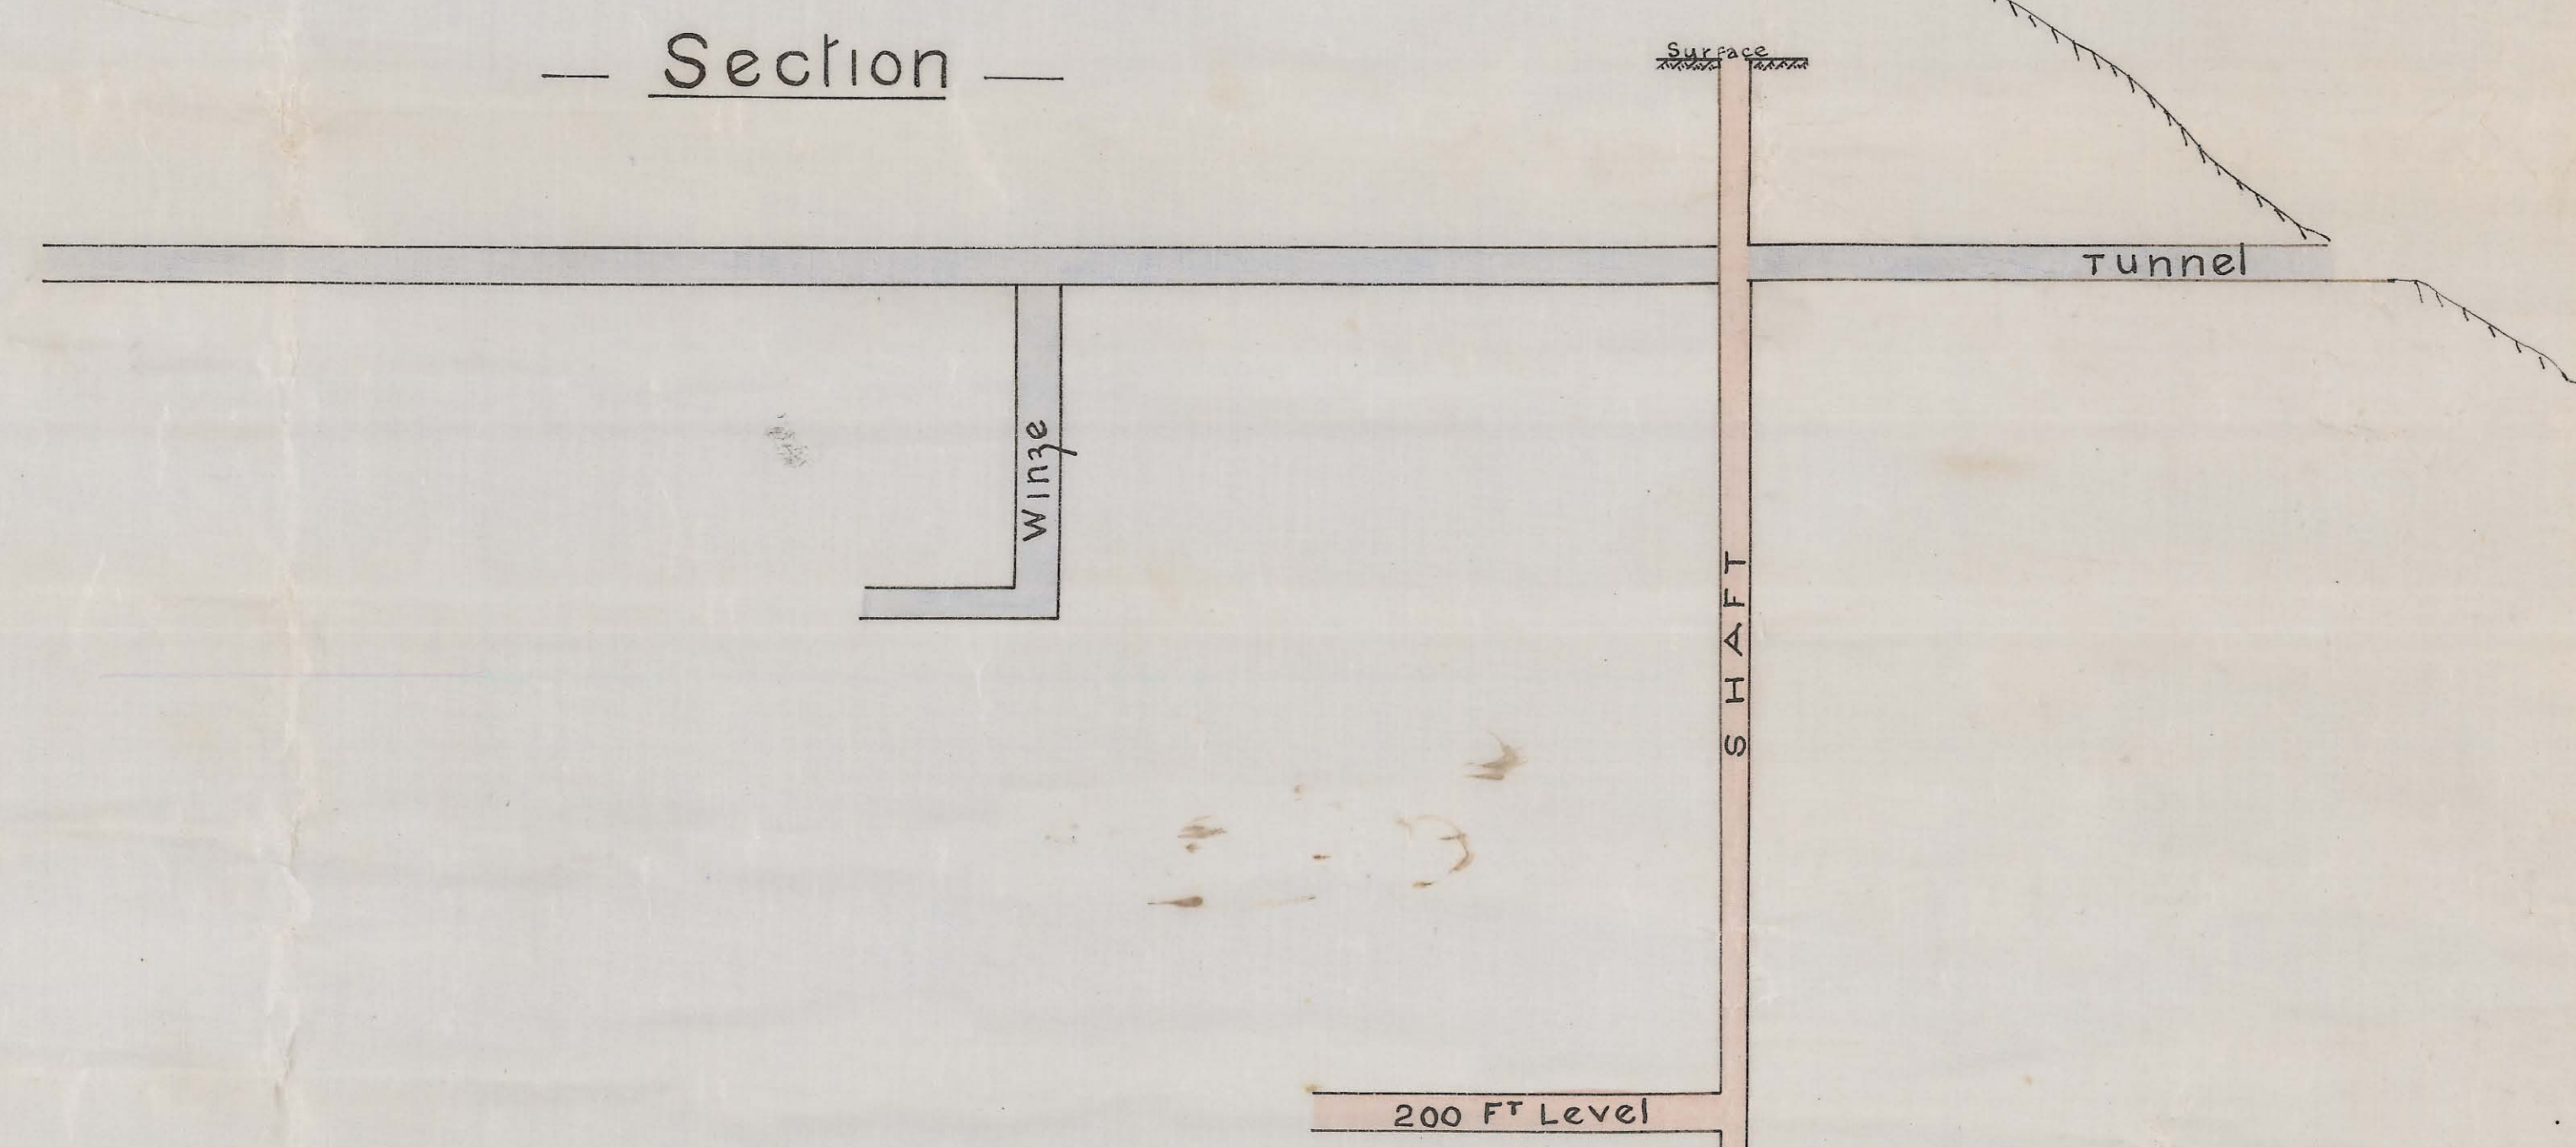


— COLONEL NORTH S. M. C^{OR} —

— Zeehan. Tas. —

— Scale 30 Feet to an Inch —

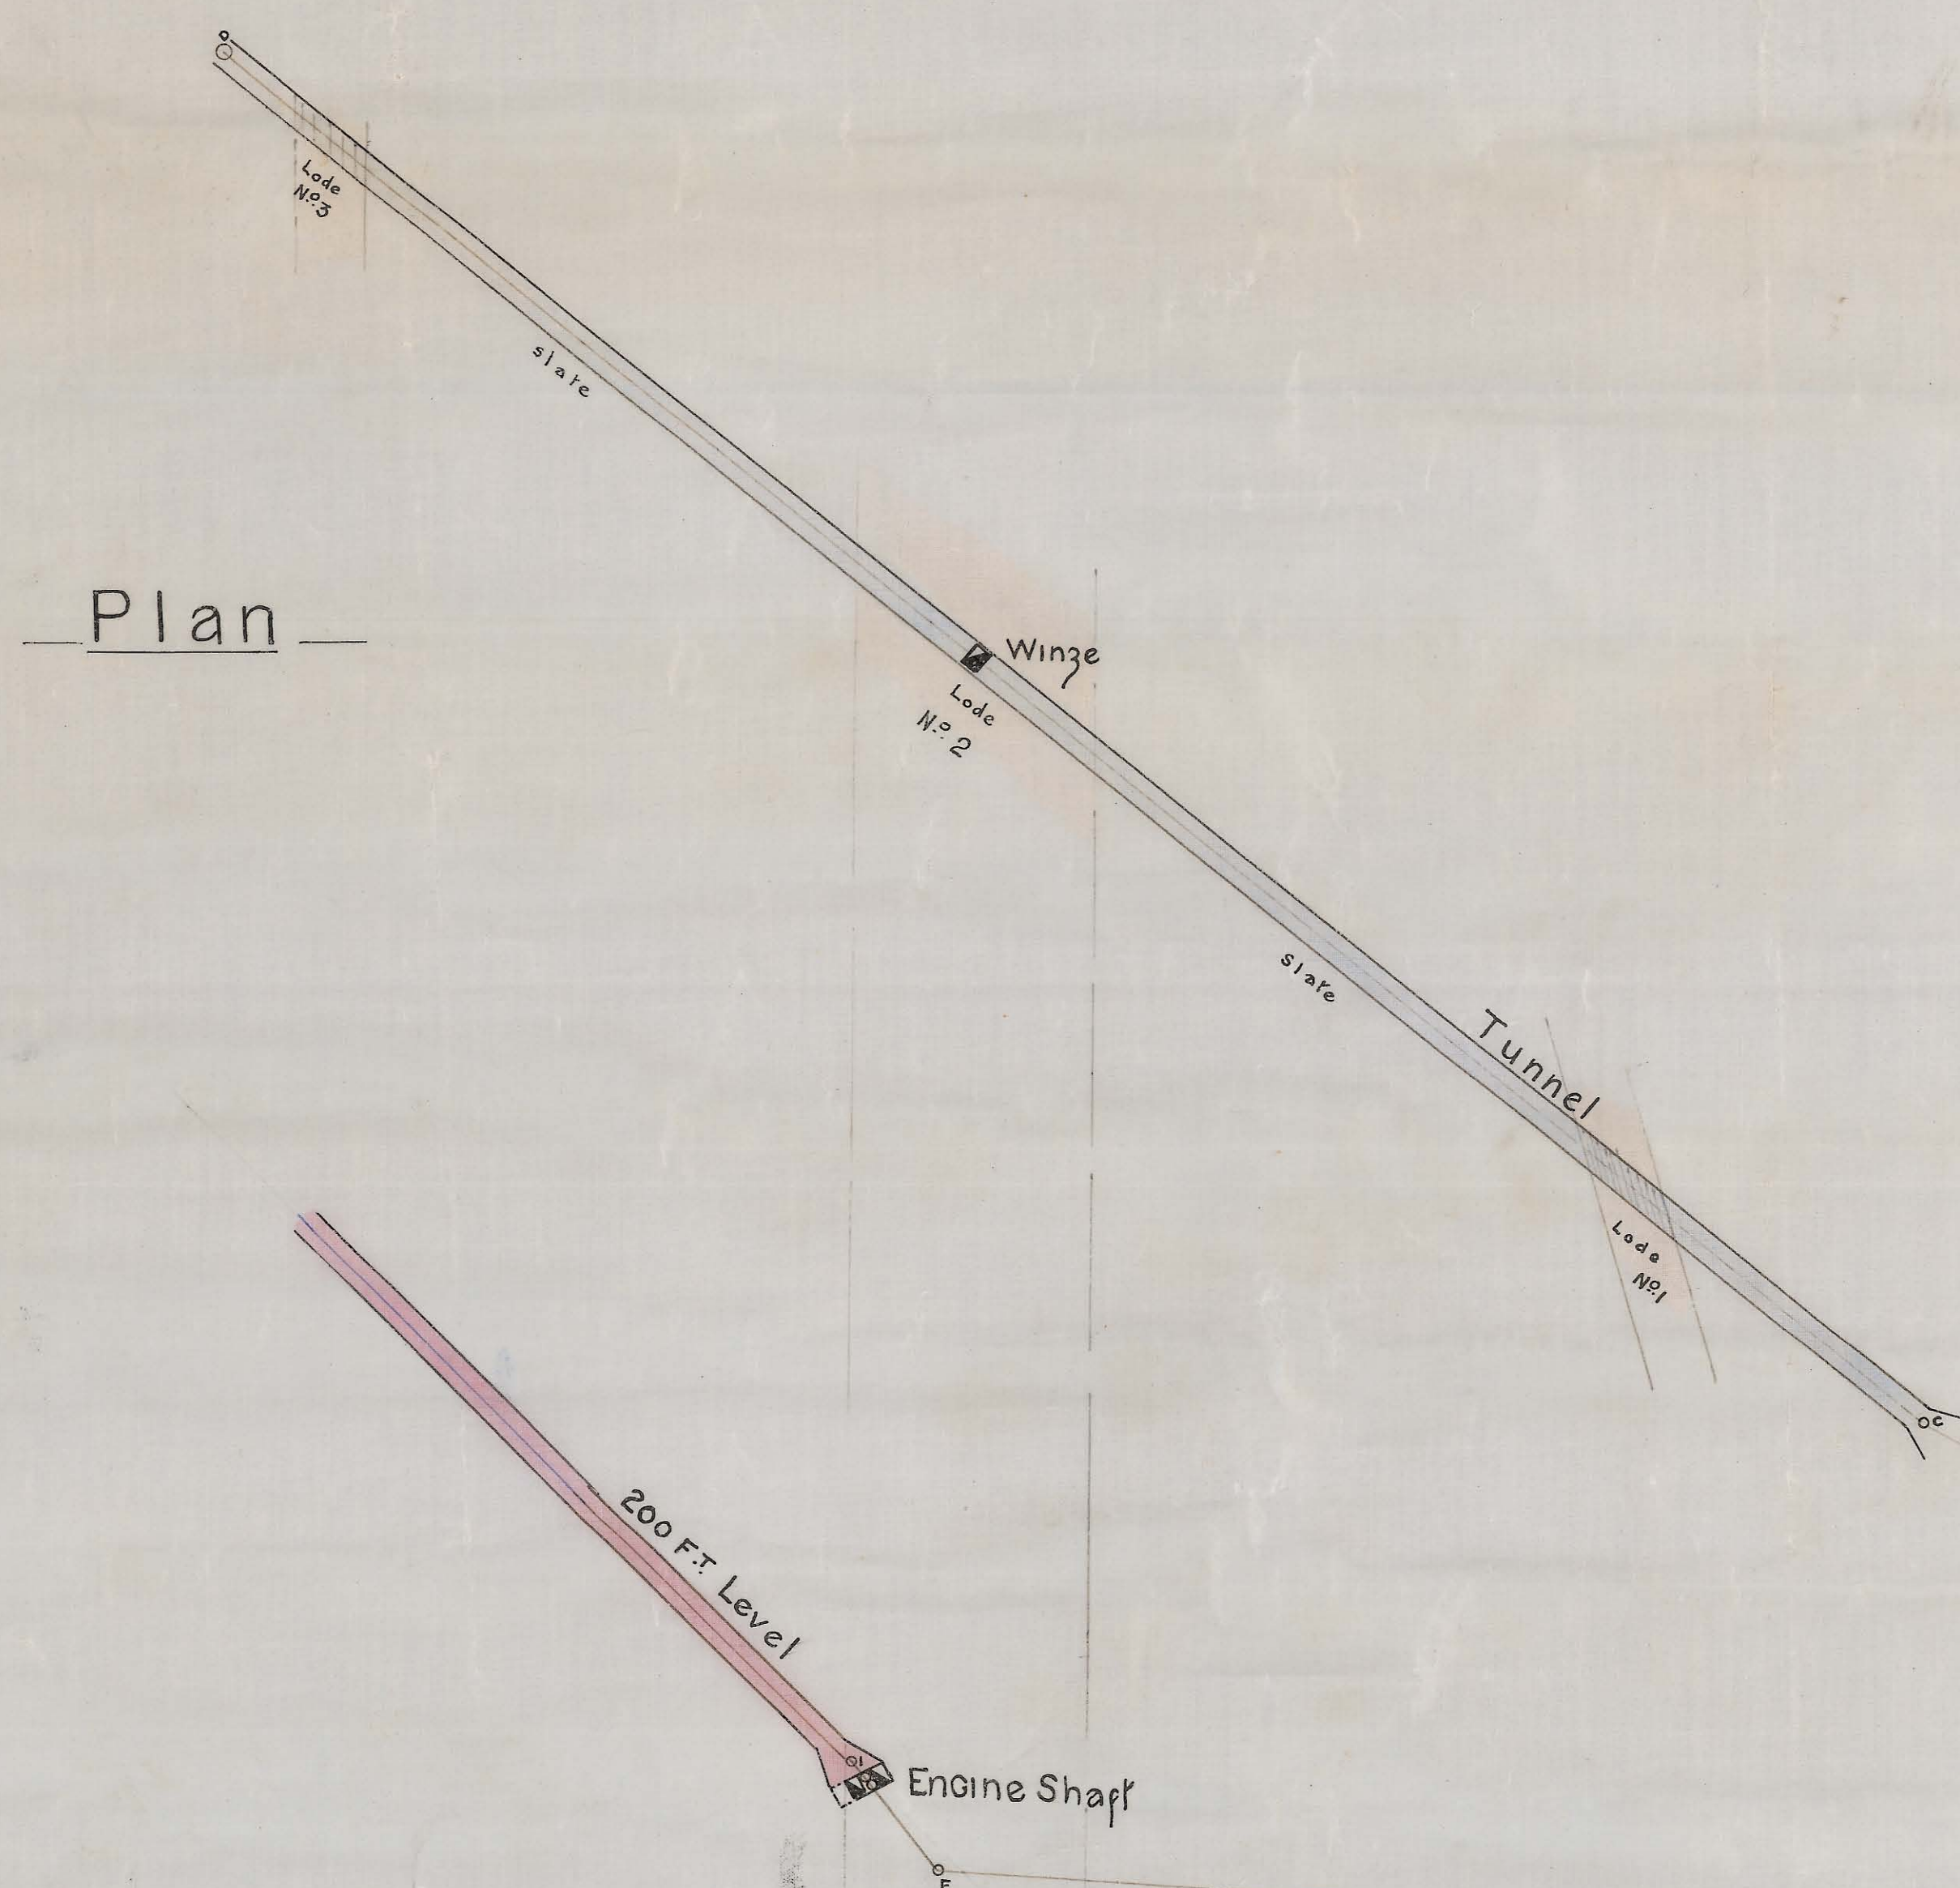

1585 80 Ac

