
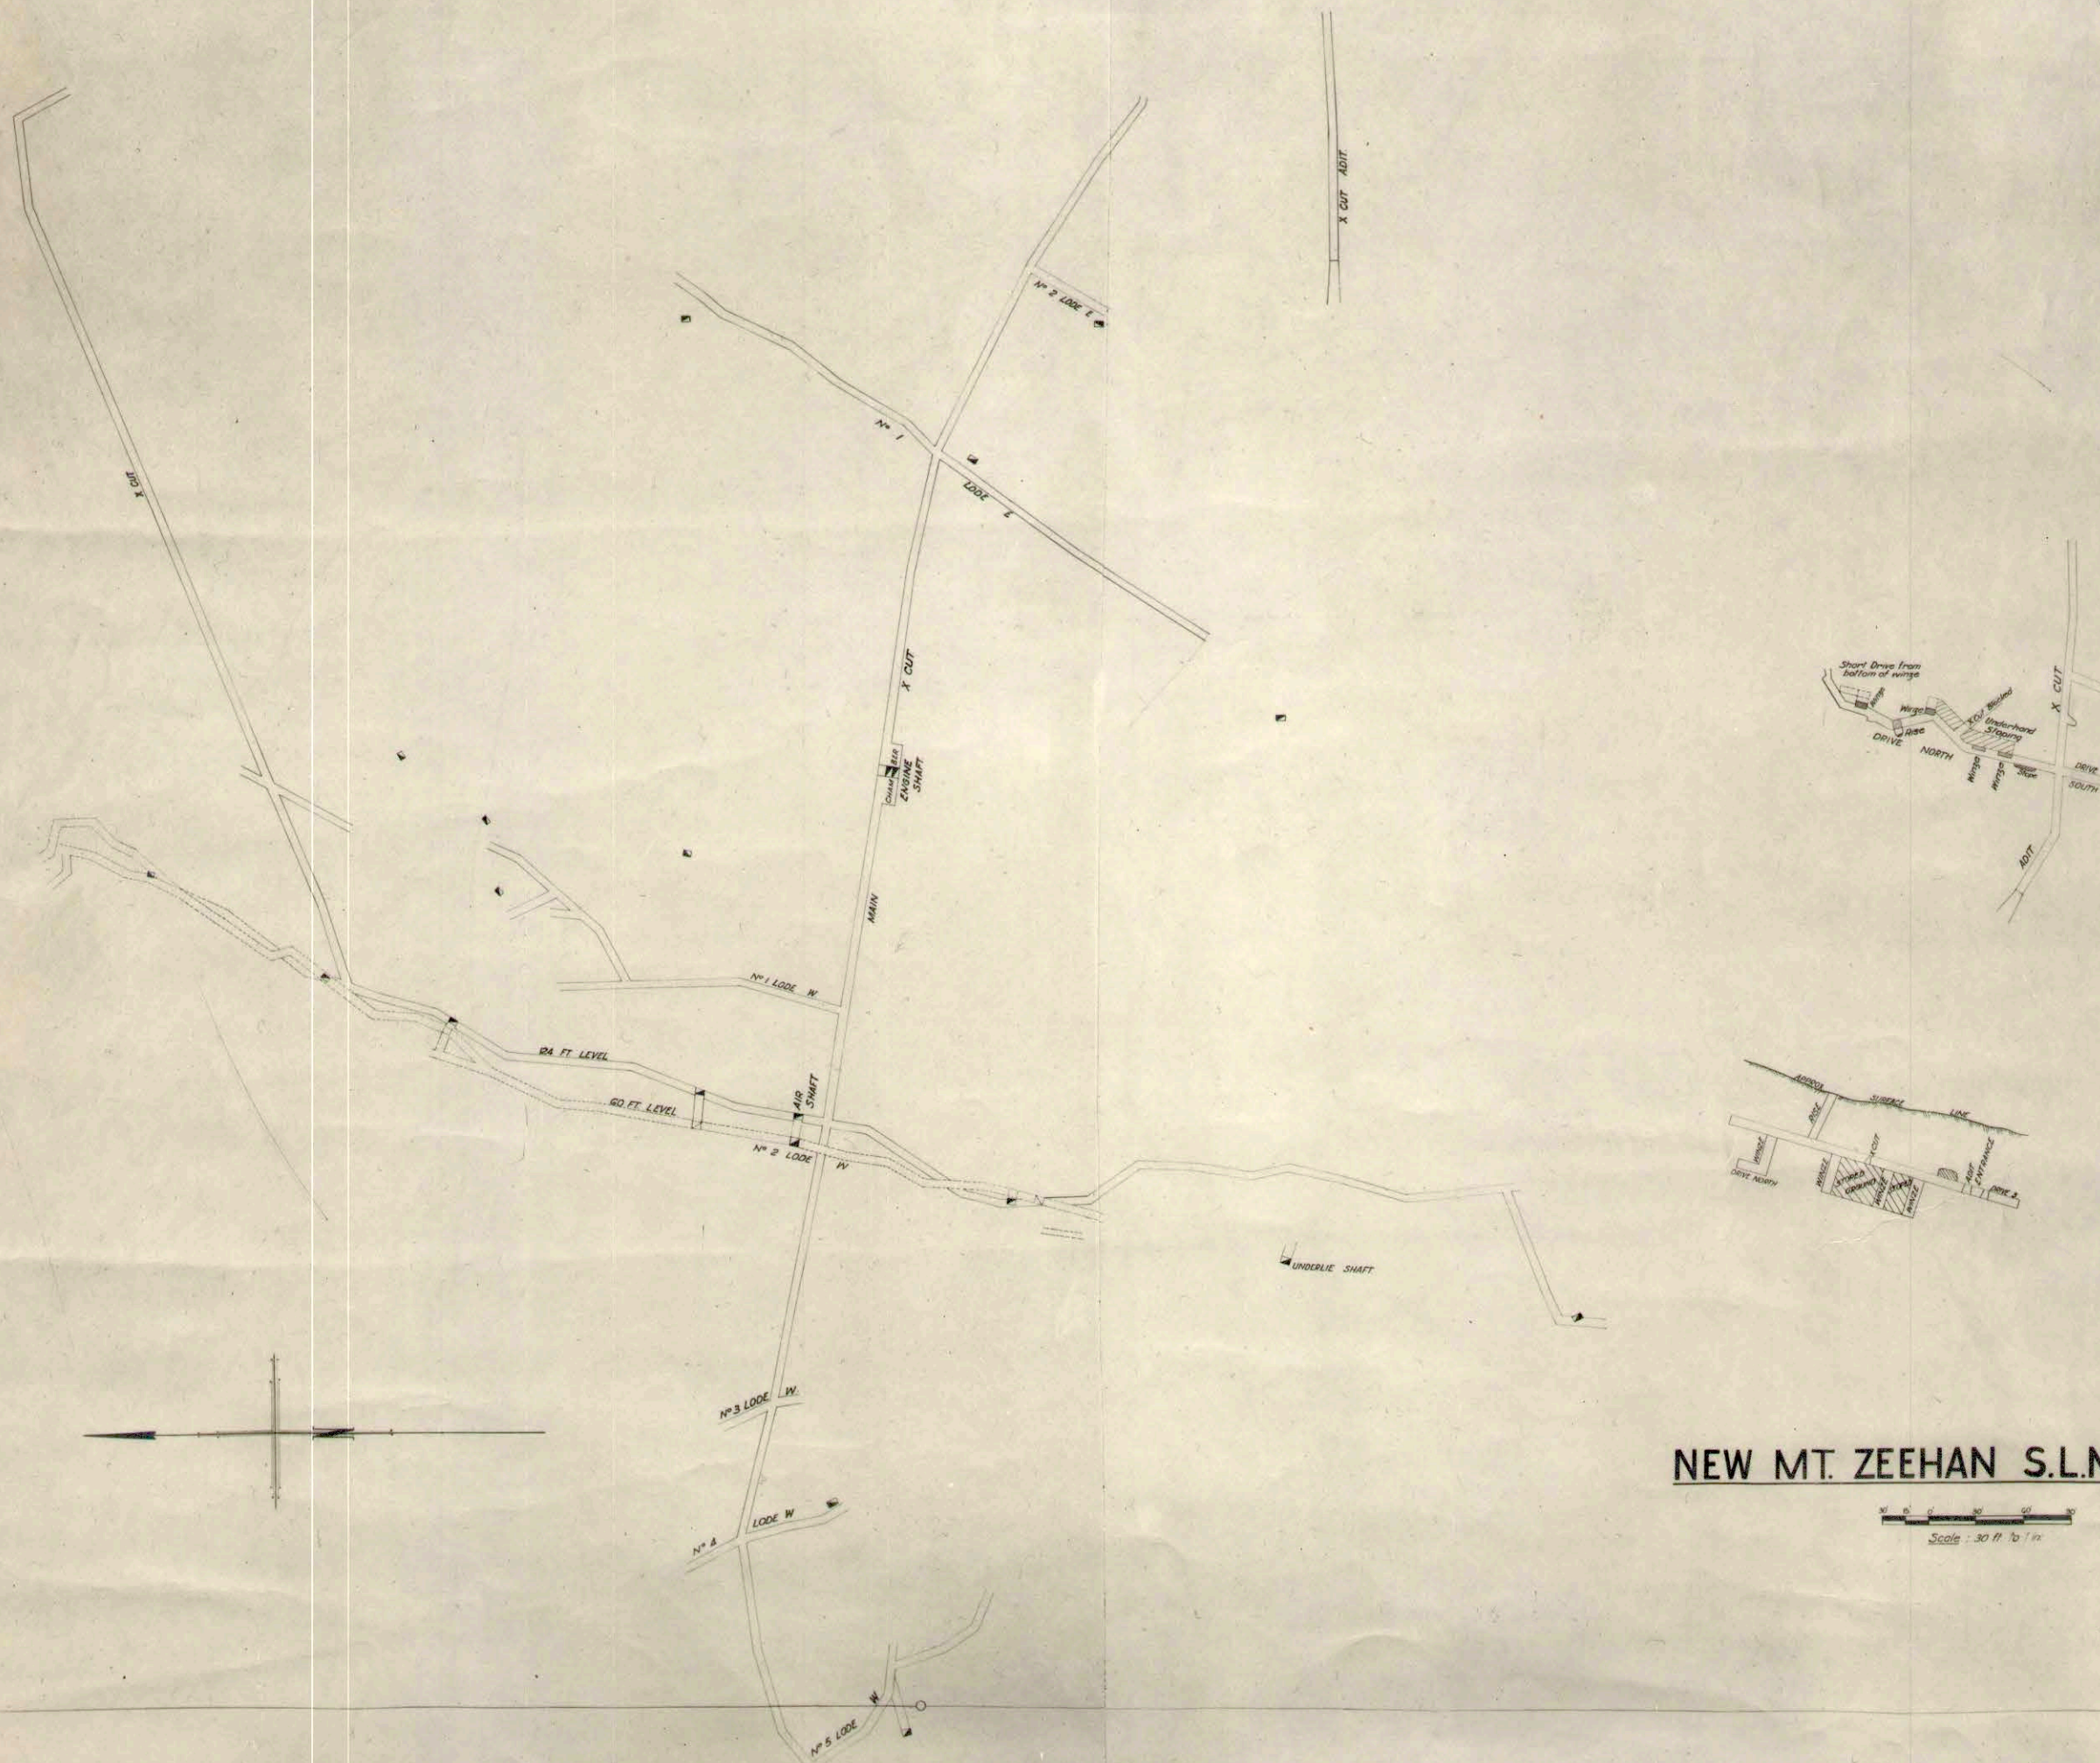
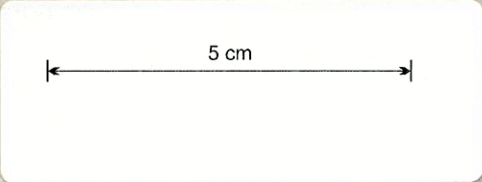


NEW MT. ZEEHAN S.L.M. COY. LTD.

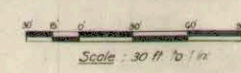

THIS DRAWING PREPARED FROM
AND FROM PLAN BY
J. CRANE, MANAGER
JANUARY 20th 1900