

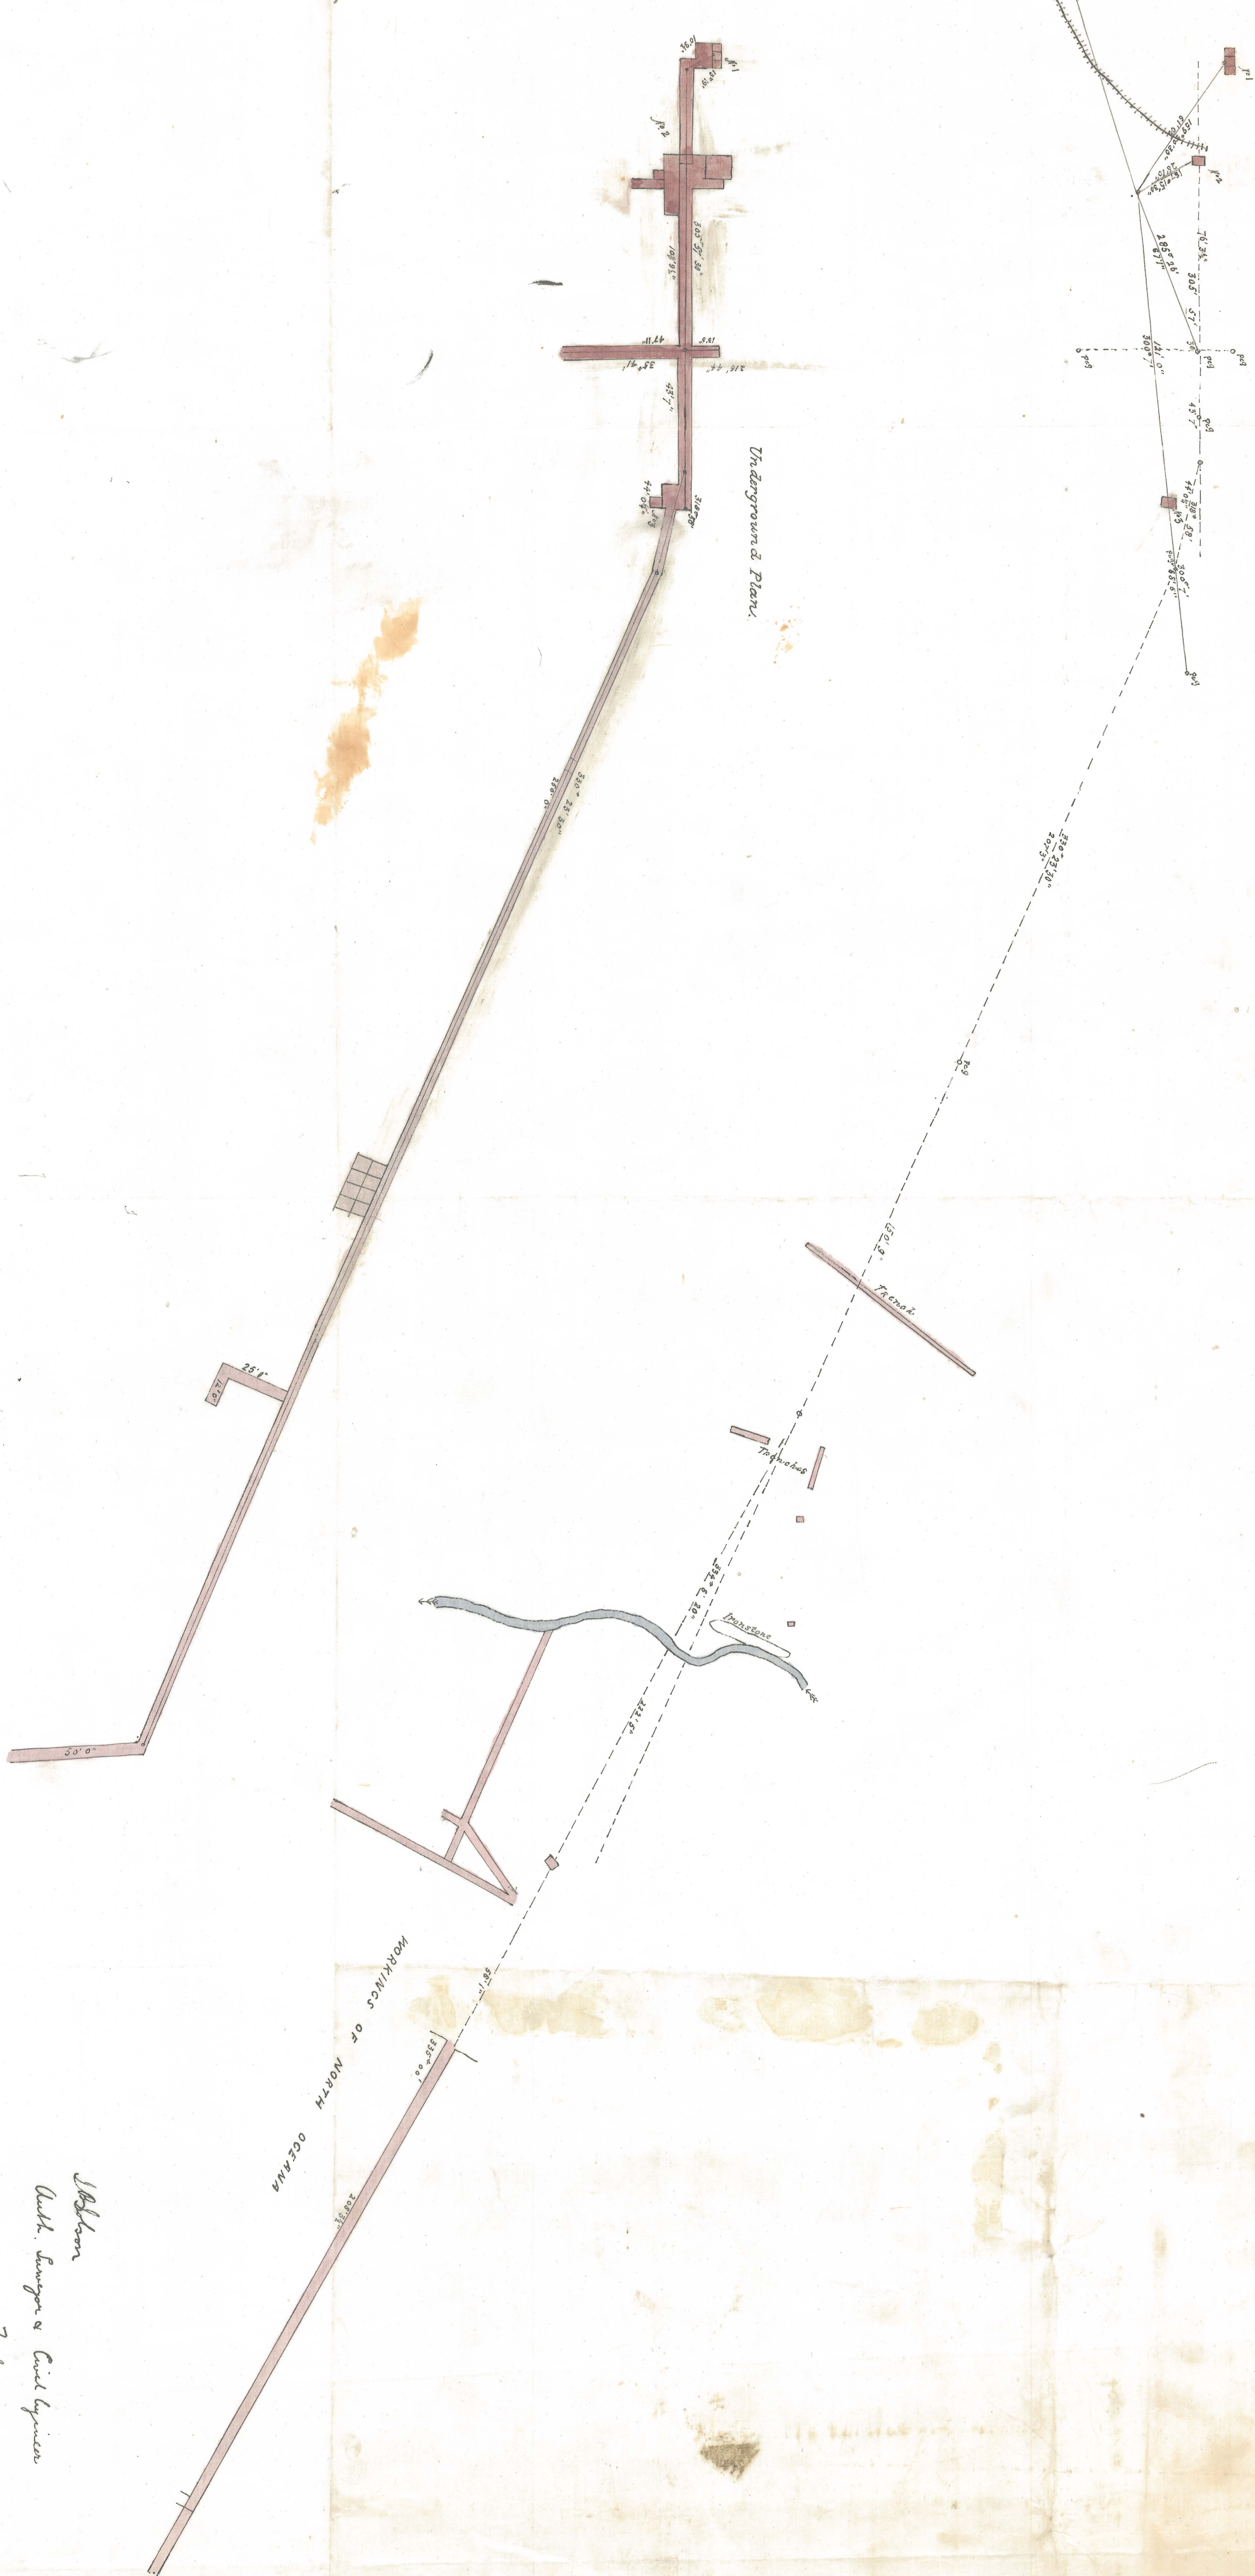


PLAN
SHEWING WORKINGS OF
OCEANA S. M. CO.
ZEEHAN

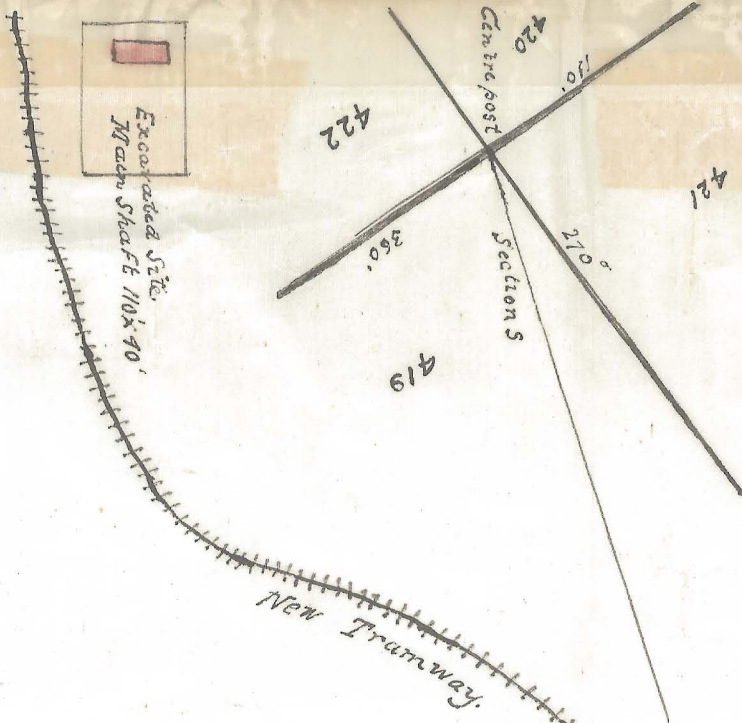

Underground Plan

SECTION PLAN

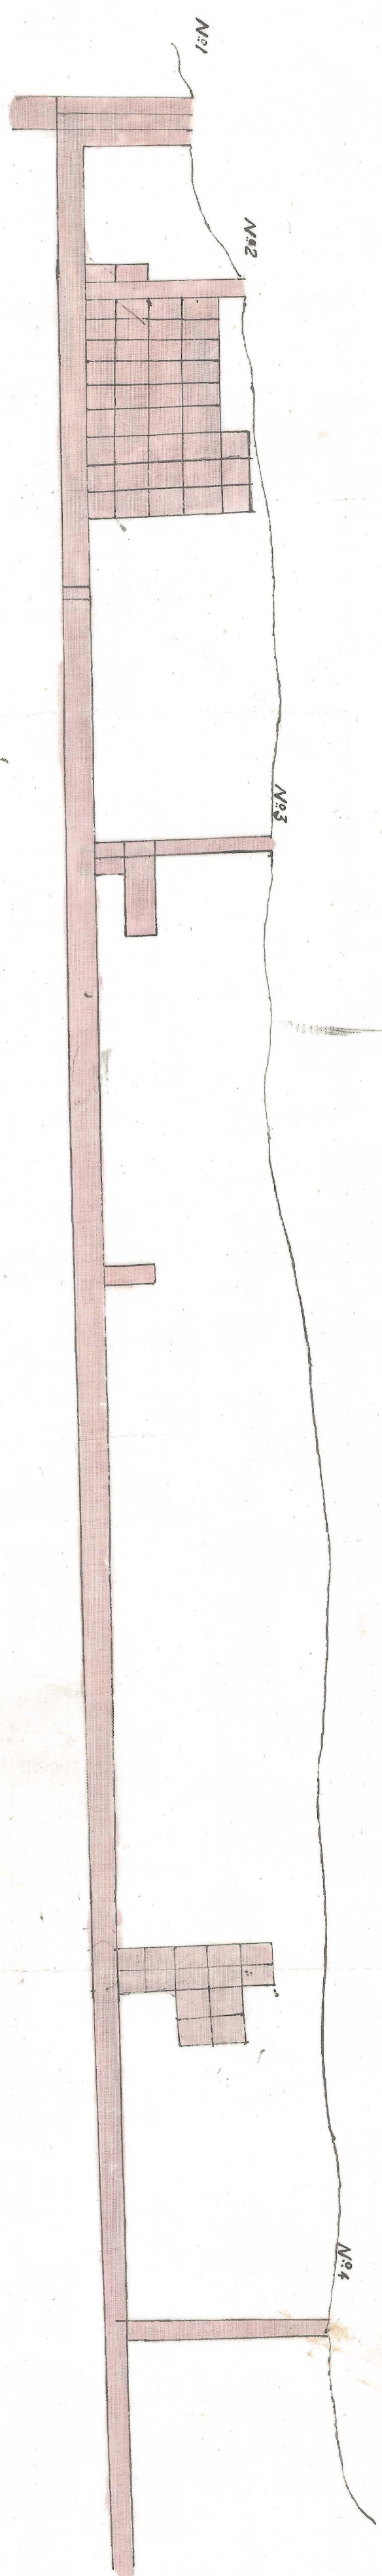

*W. H. Brown
Capt. Engineer & Civil Engineer
Zeehan*

Oceanic Mine