


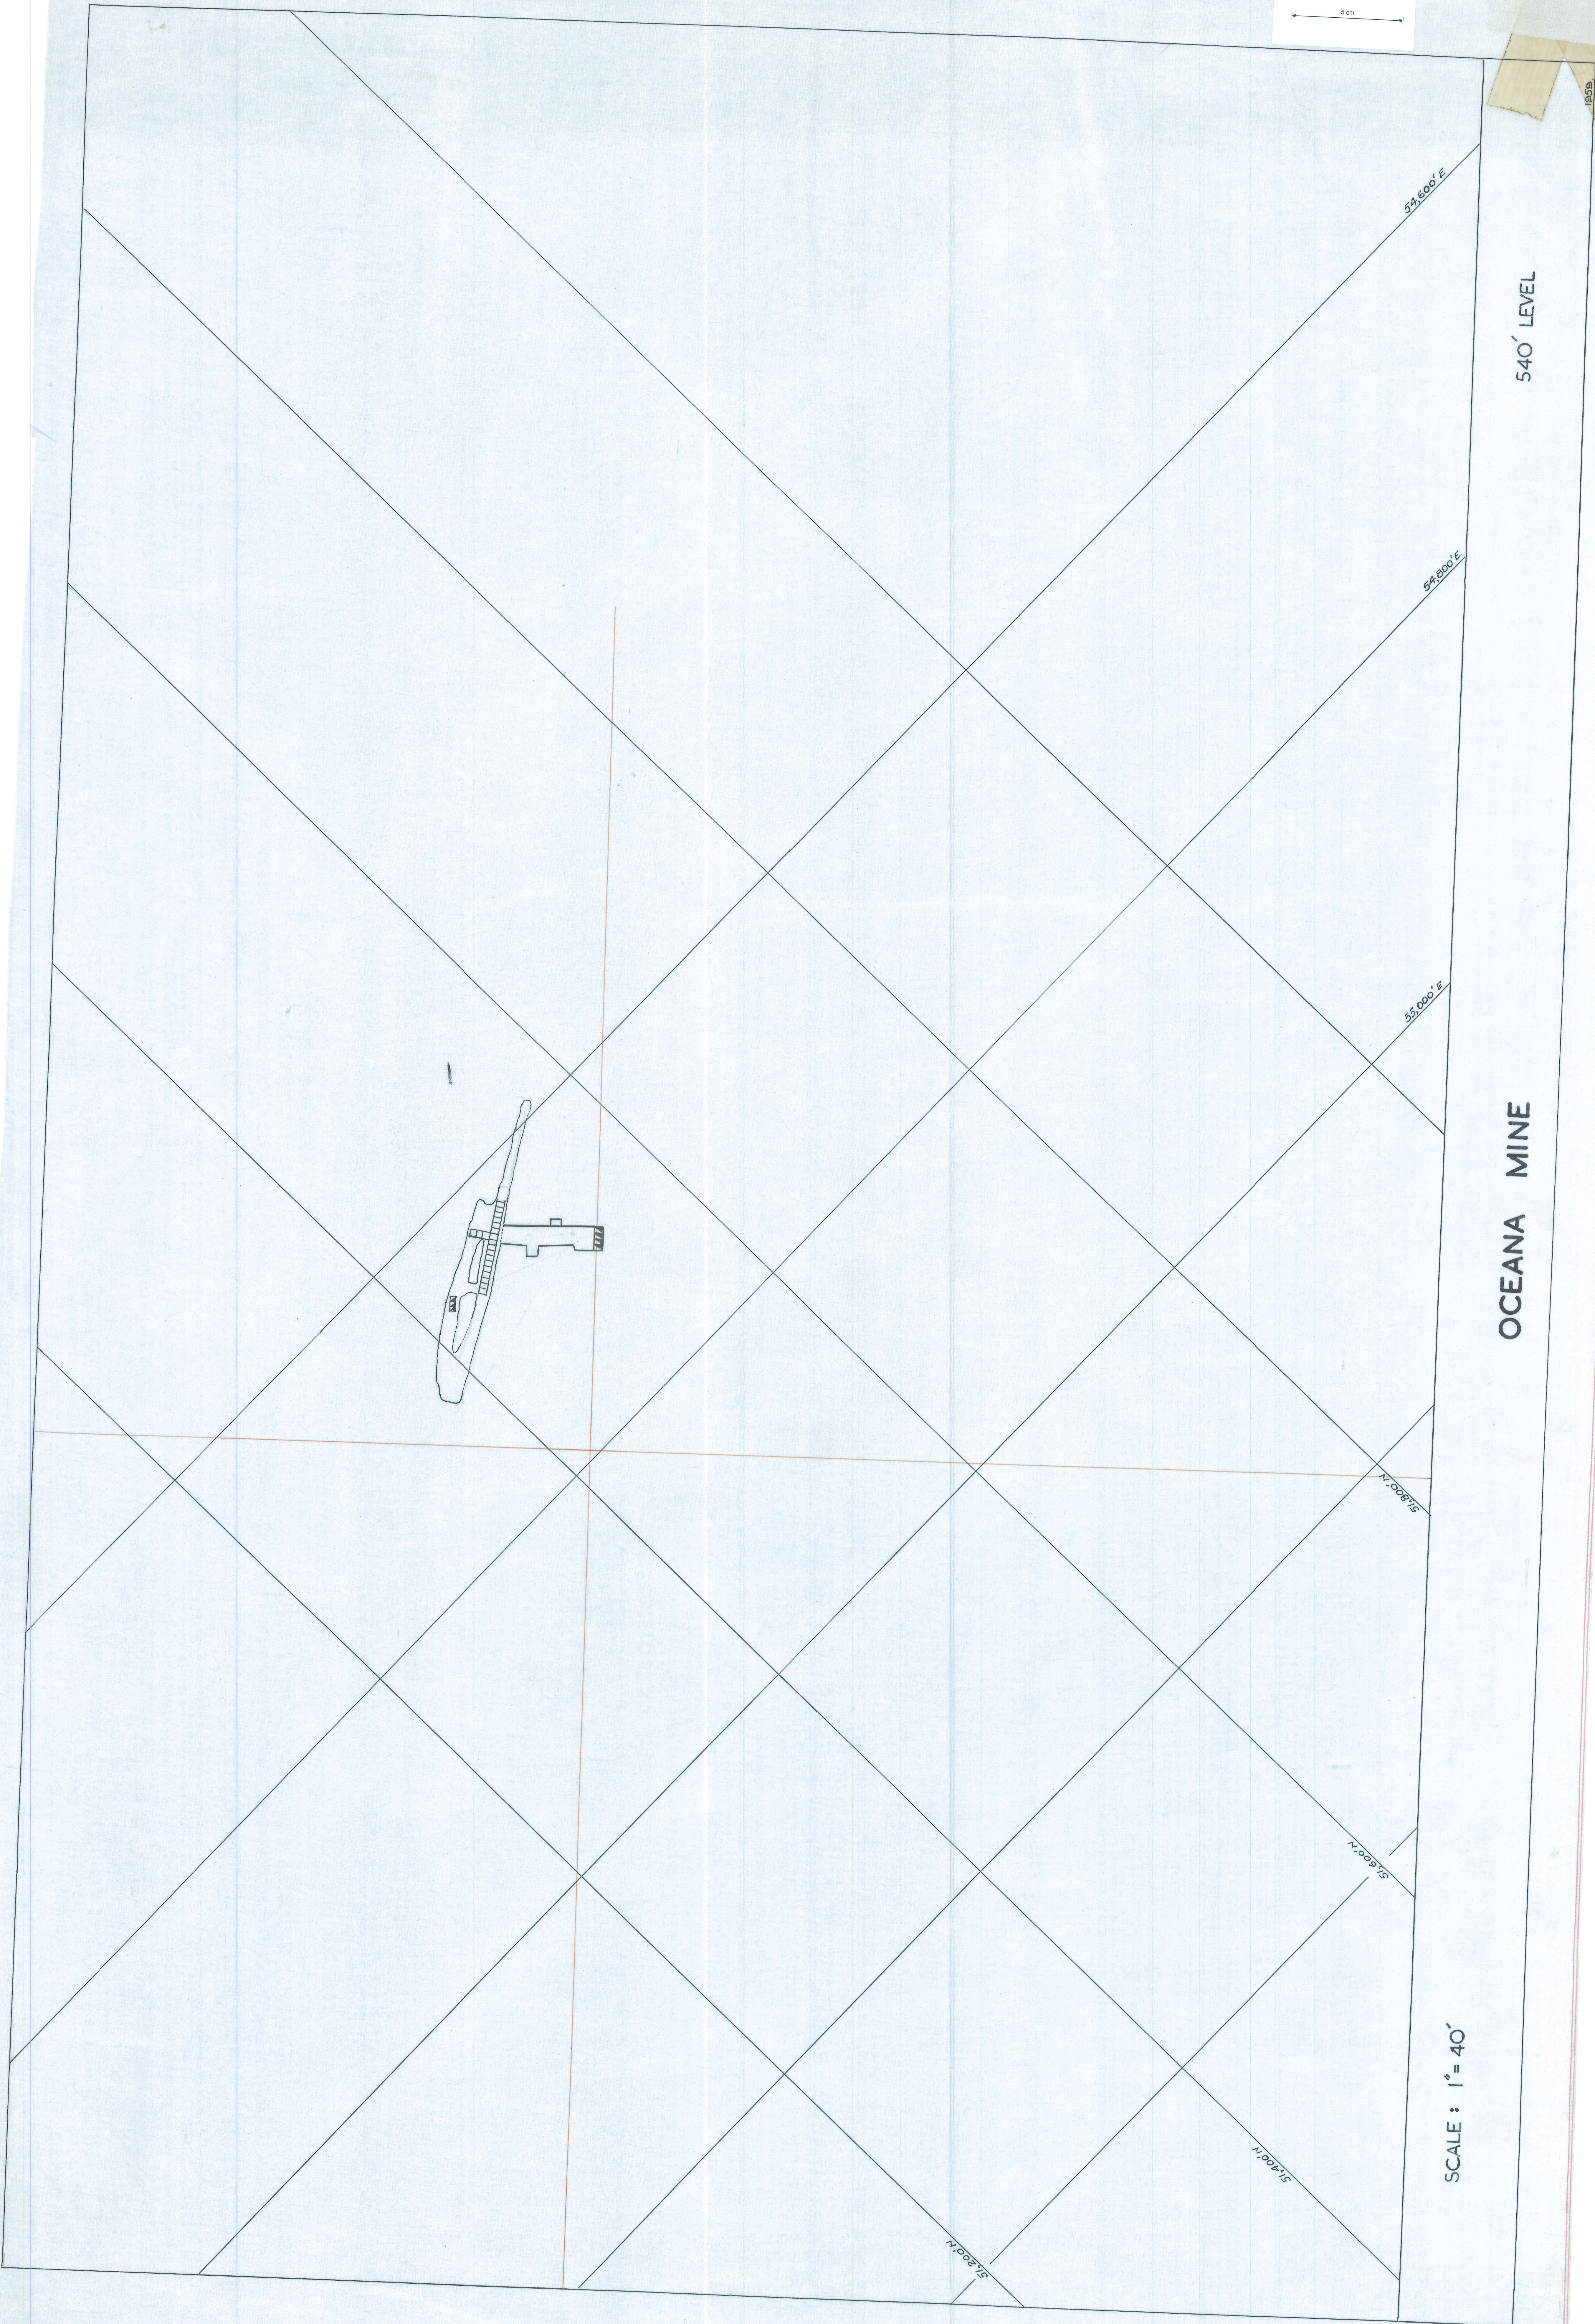

SCALE : 1" = 40'

OCEANA MINE

540' LEVEL

54,600' E

54,800' E

55,000' E

51,800' N

51,000' N

51,200' N

5 cm

364