160' South Stope.

5 cm

Samples
① Test Hole 1.3%
② " 0.2%
③ " 1.5%
④ Bulk 5%
⑤ Grab 4%
⑥ Grab 3%

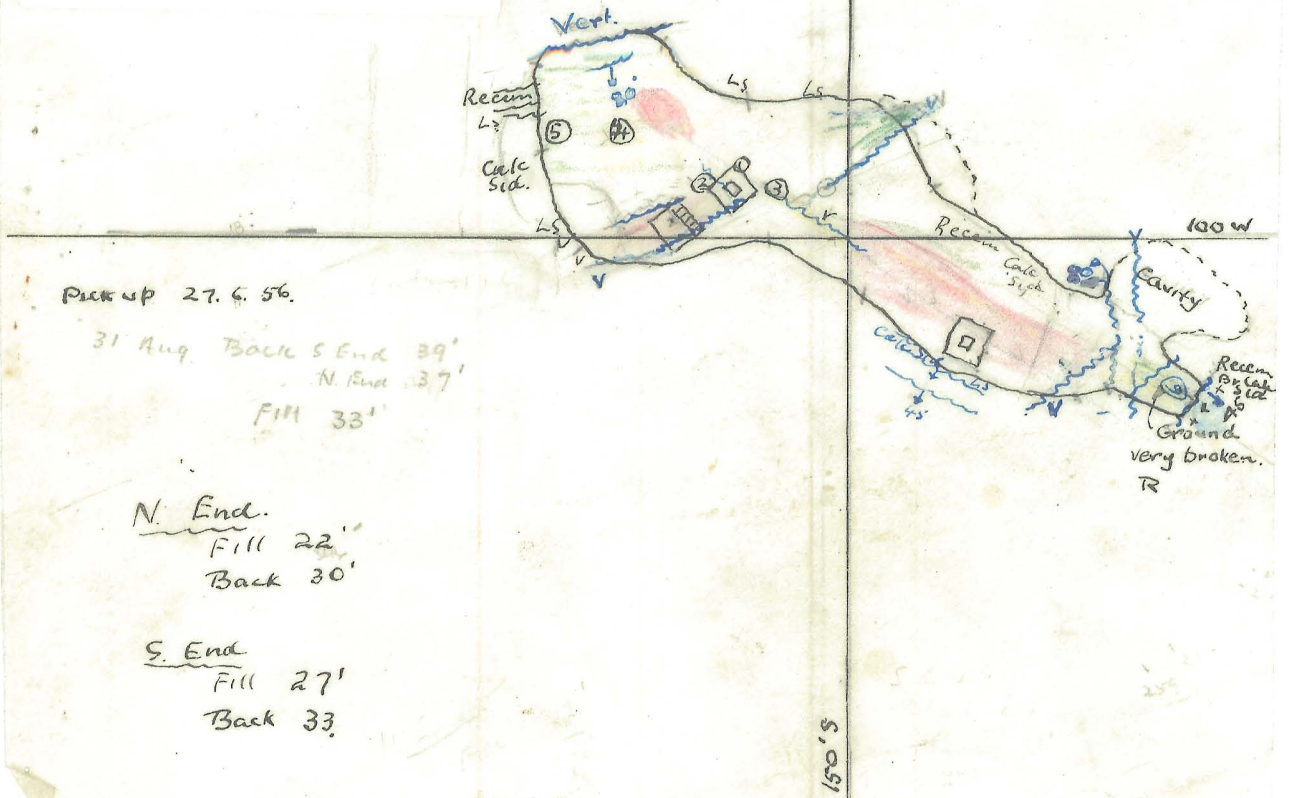

Pick up 27. 6. 56.

31 Aug Back S End 39'
N. End 37'
Fill 33'

N. End.
Fill 22'
Back 30'

S. End
Fill 27'
Back 33