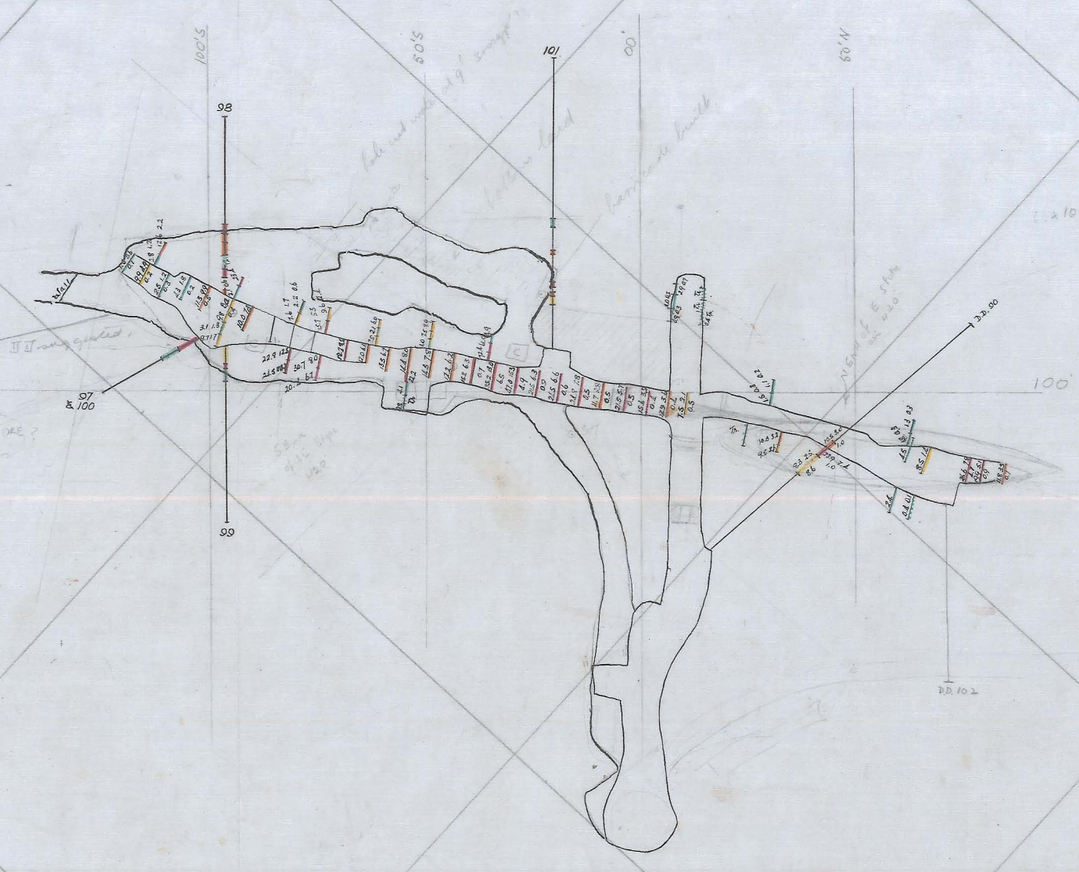

300 LEVEL ASSAY PLAN

Scale 1" = 20'