


ZEEHAN MINES PTY. LTD.

OCEANA

LEVEL PLANS 150 & 300

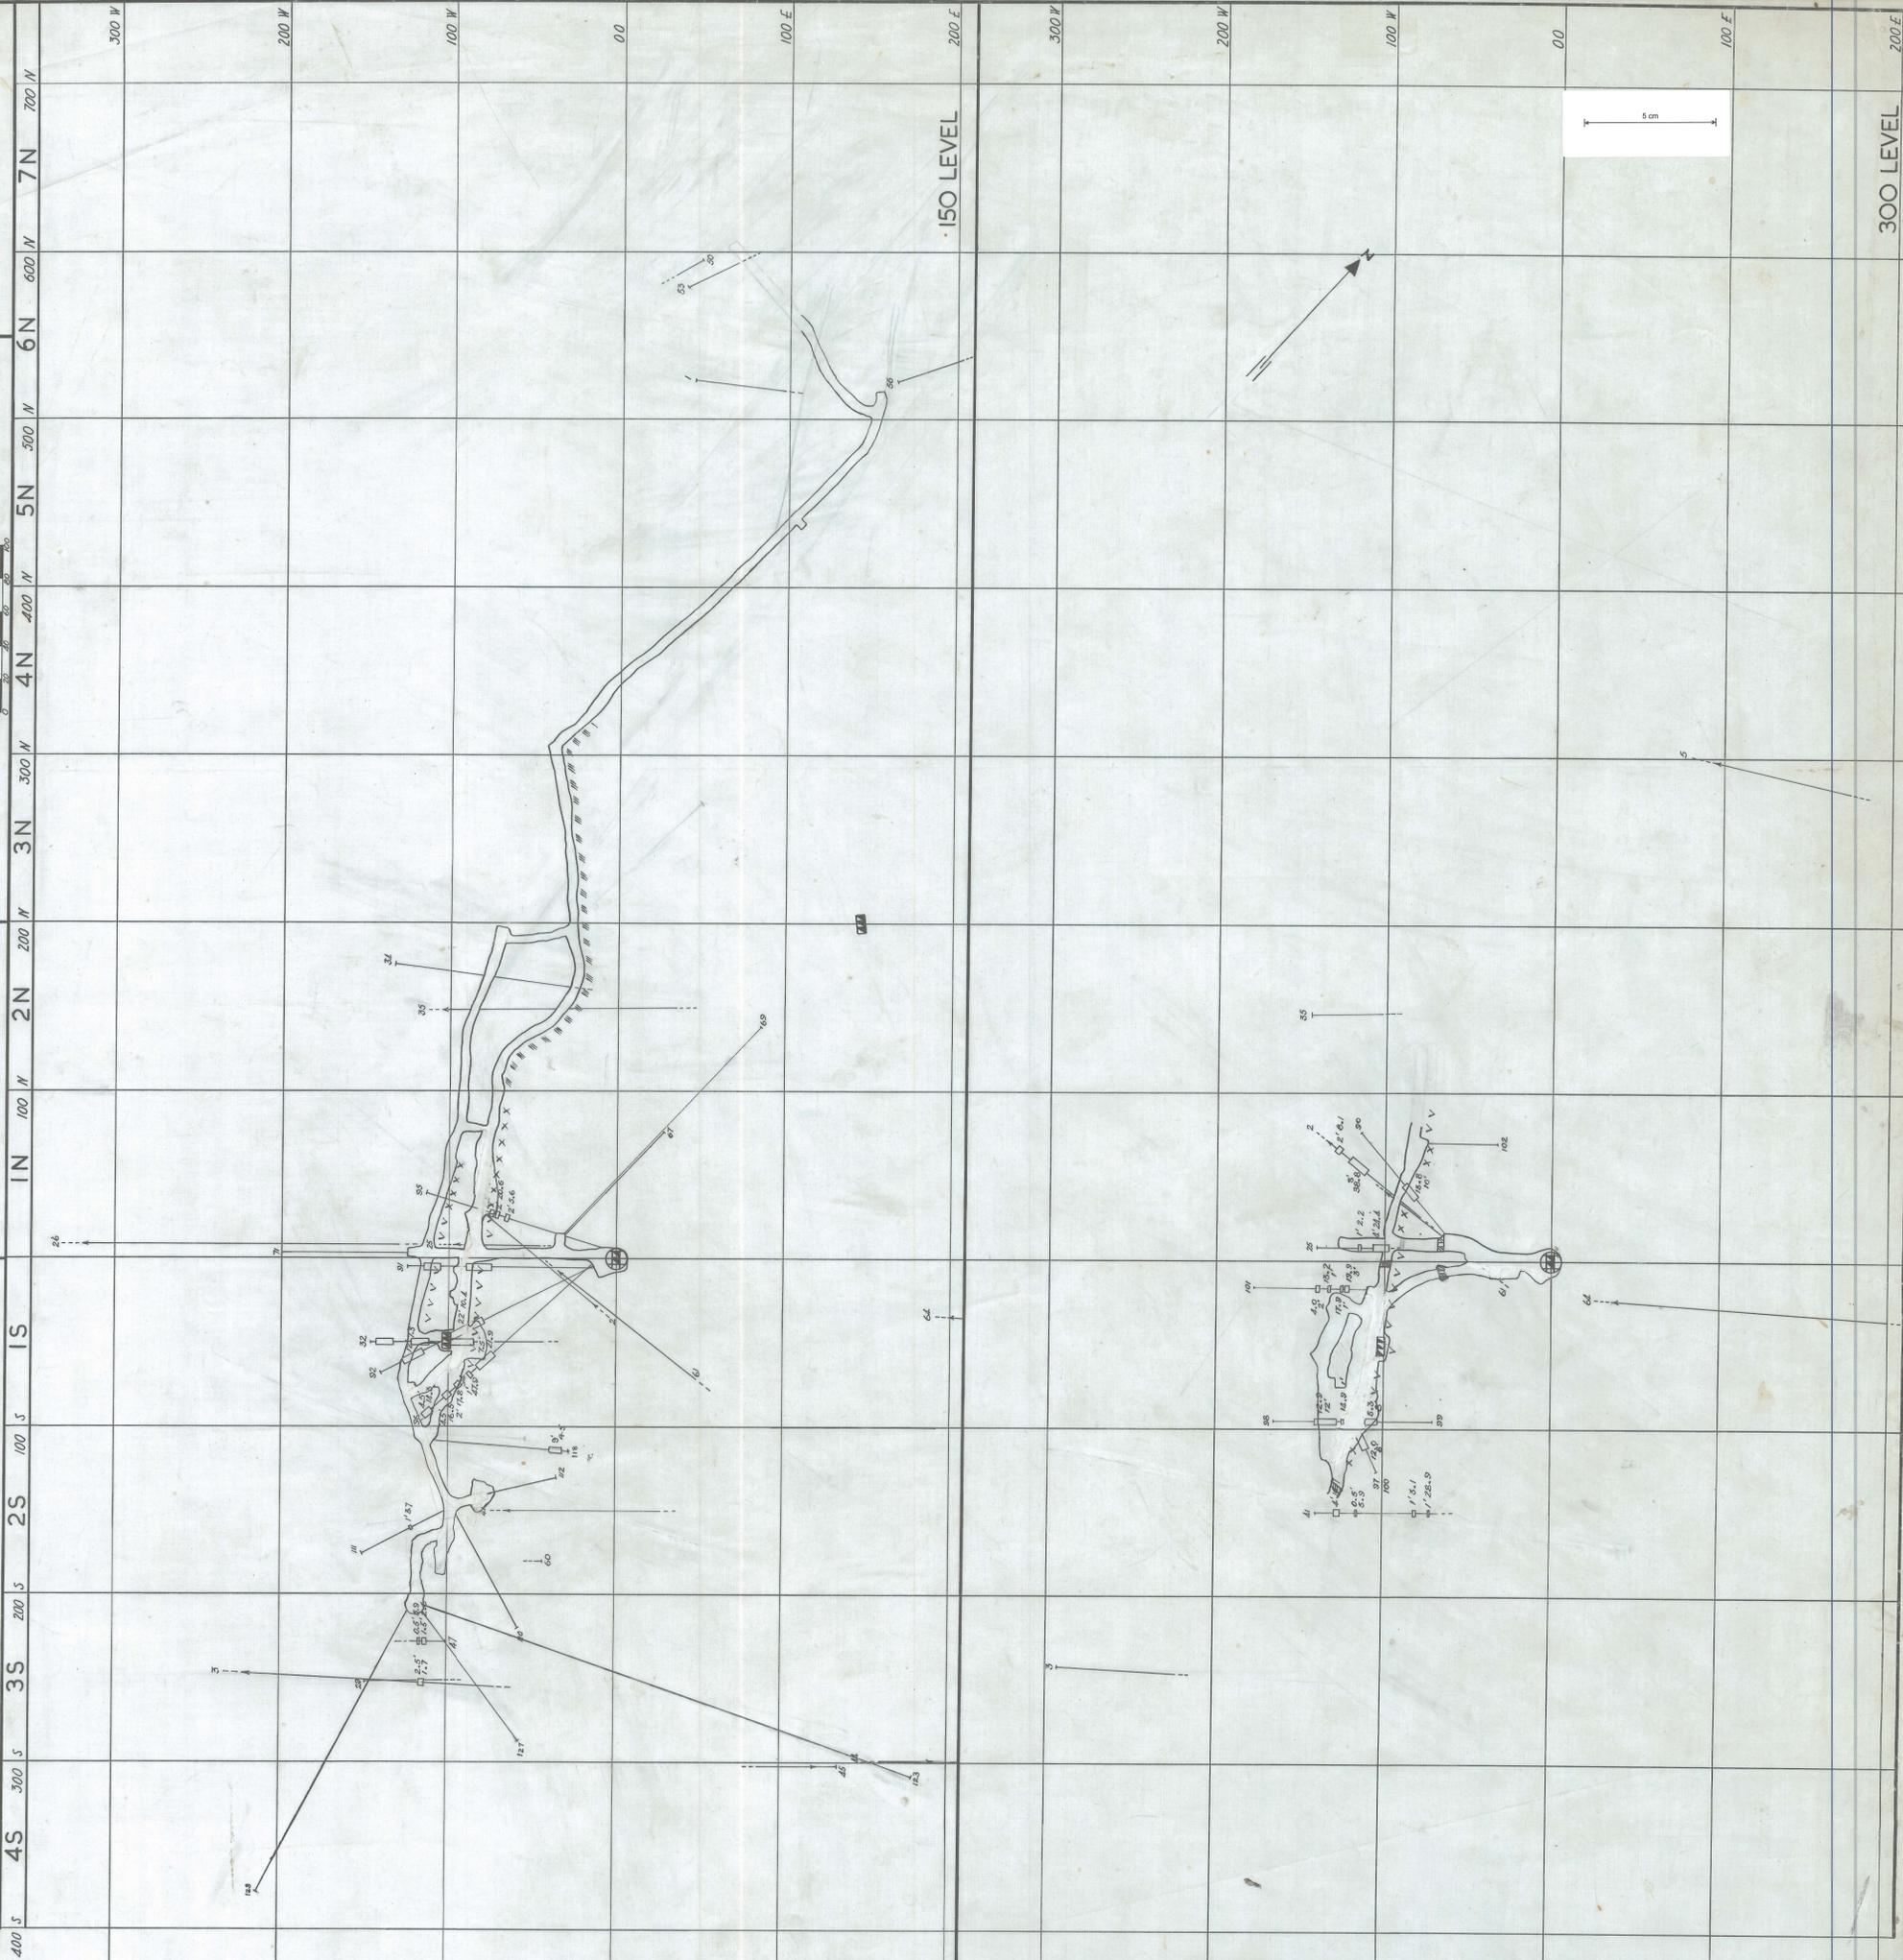

150 LEVEL

300 LEVEL