


ZEEHAN MINES PTY. LTD.

OCEANA

TRANSVERSE SECTIONS

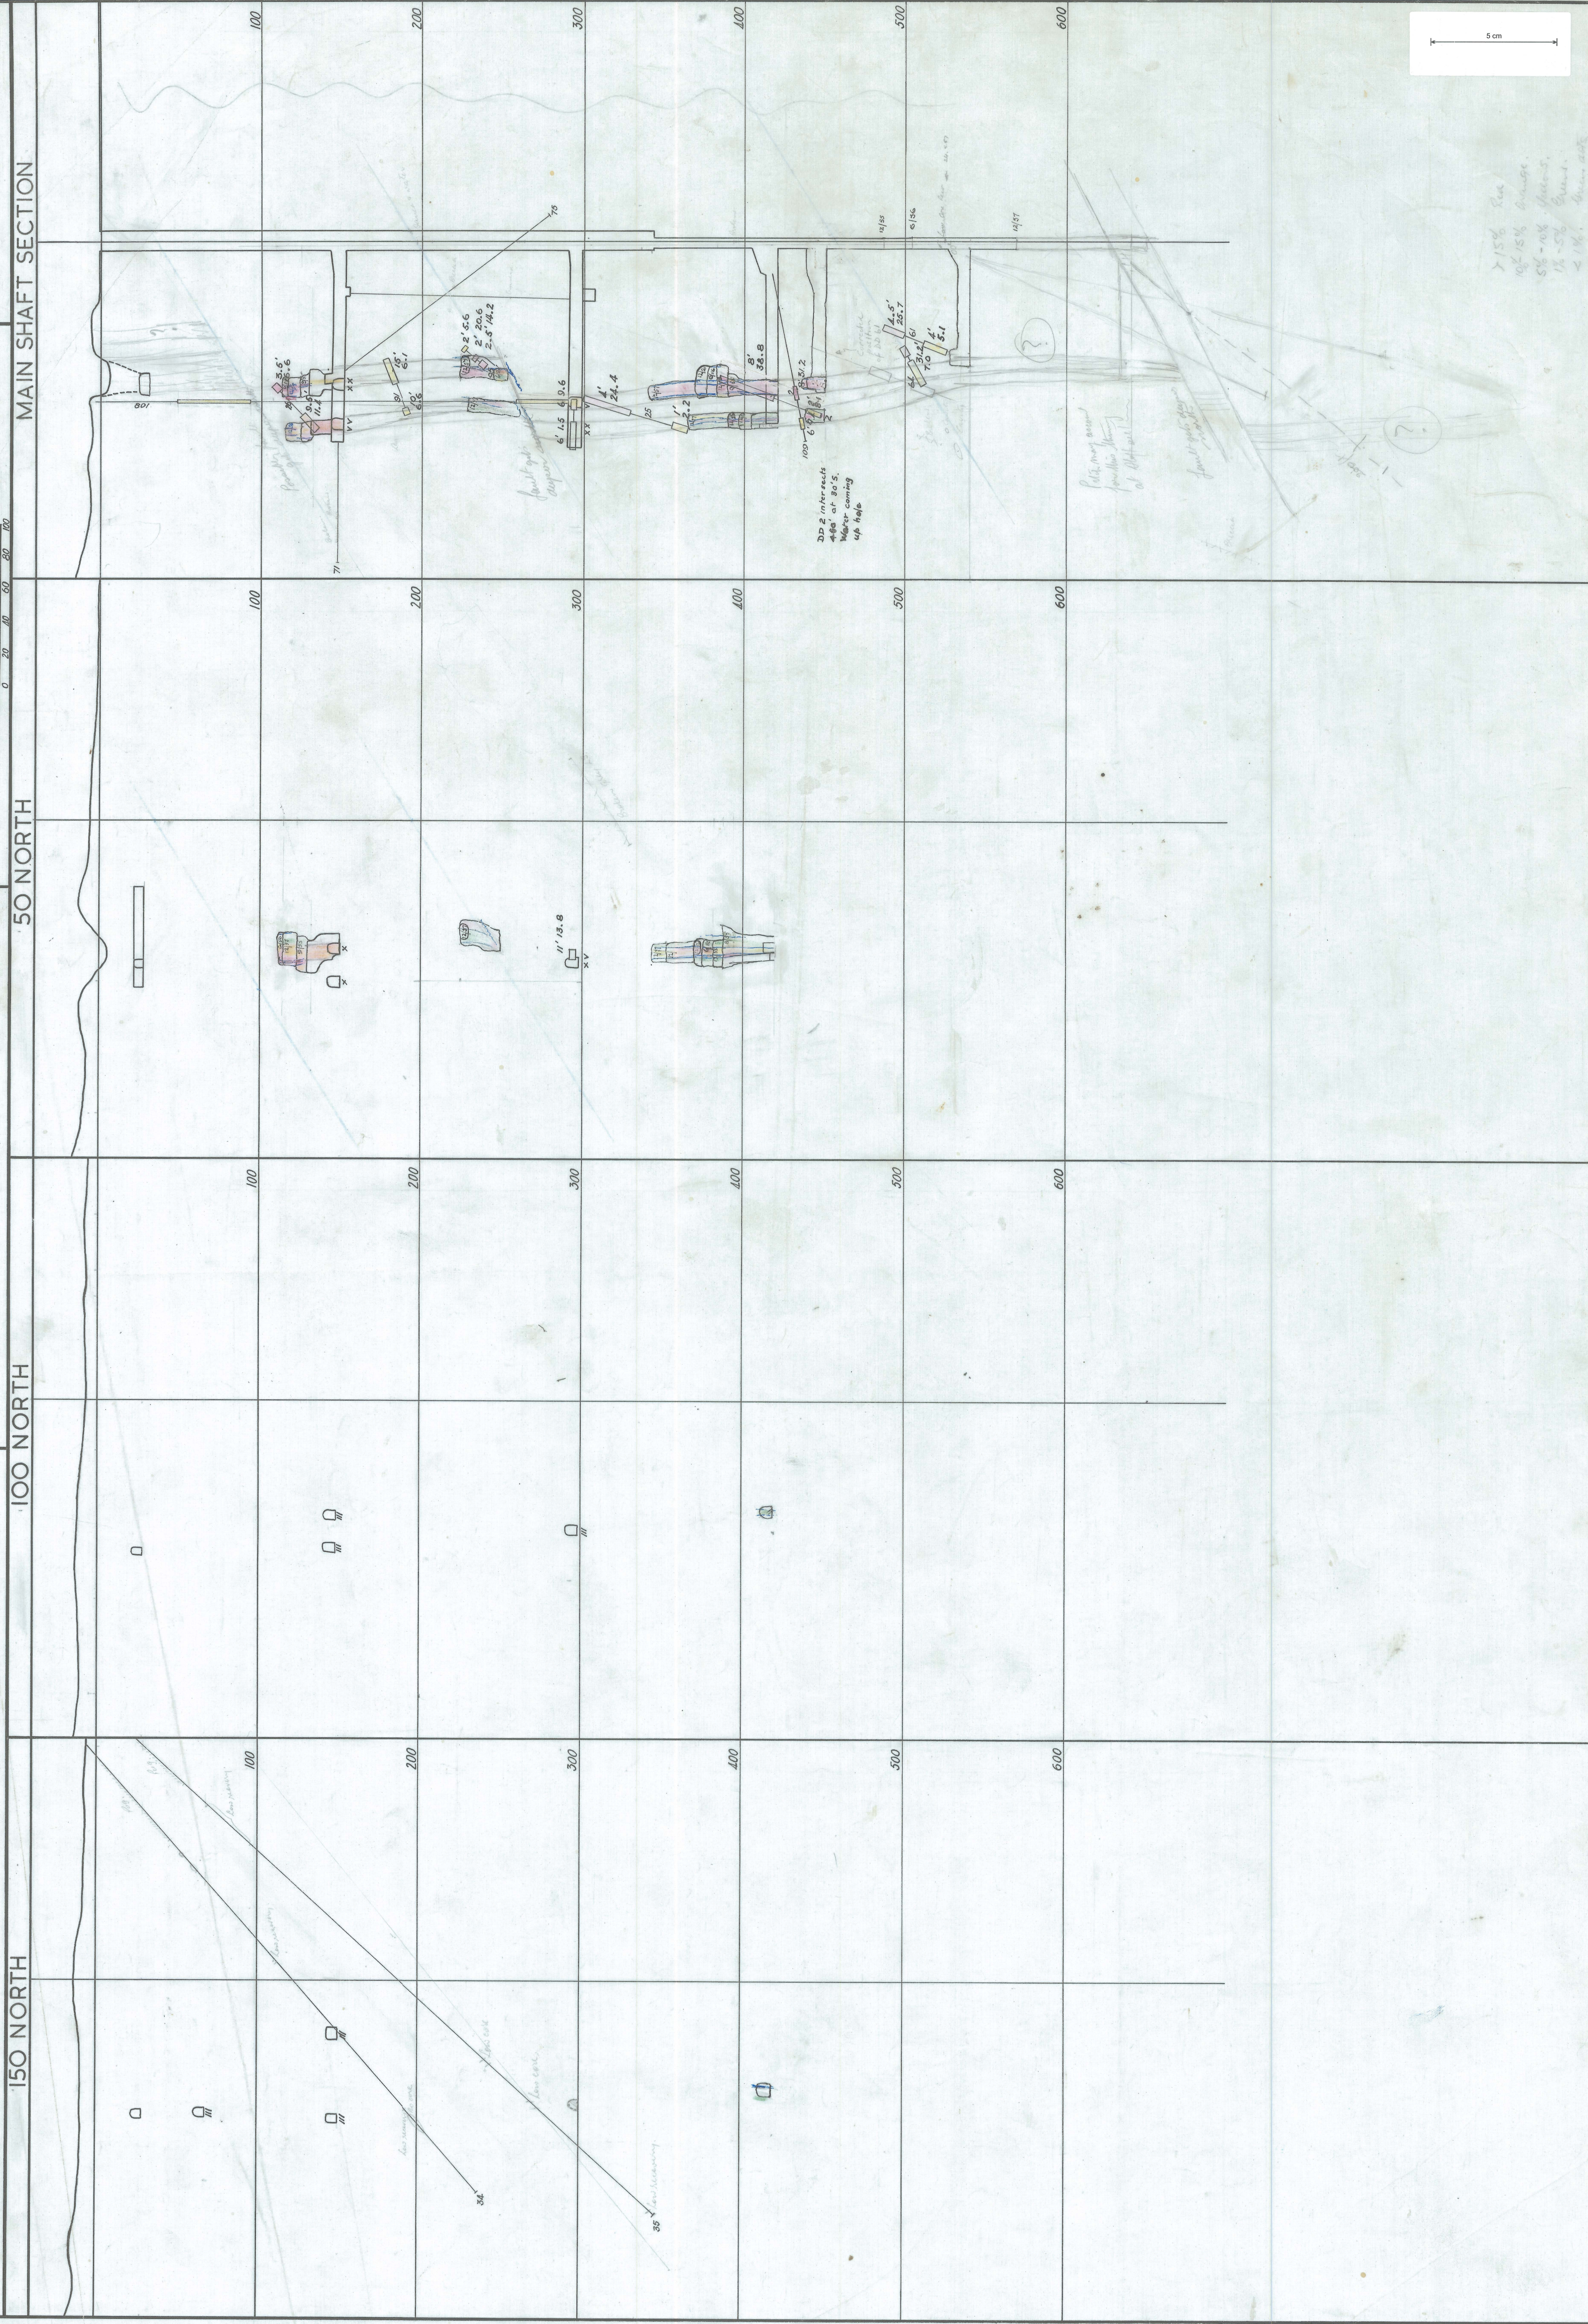

CROSS SECTIONS

0 - 150' N