


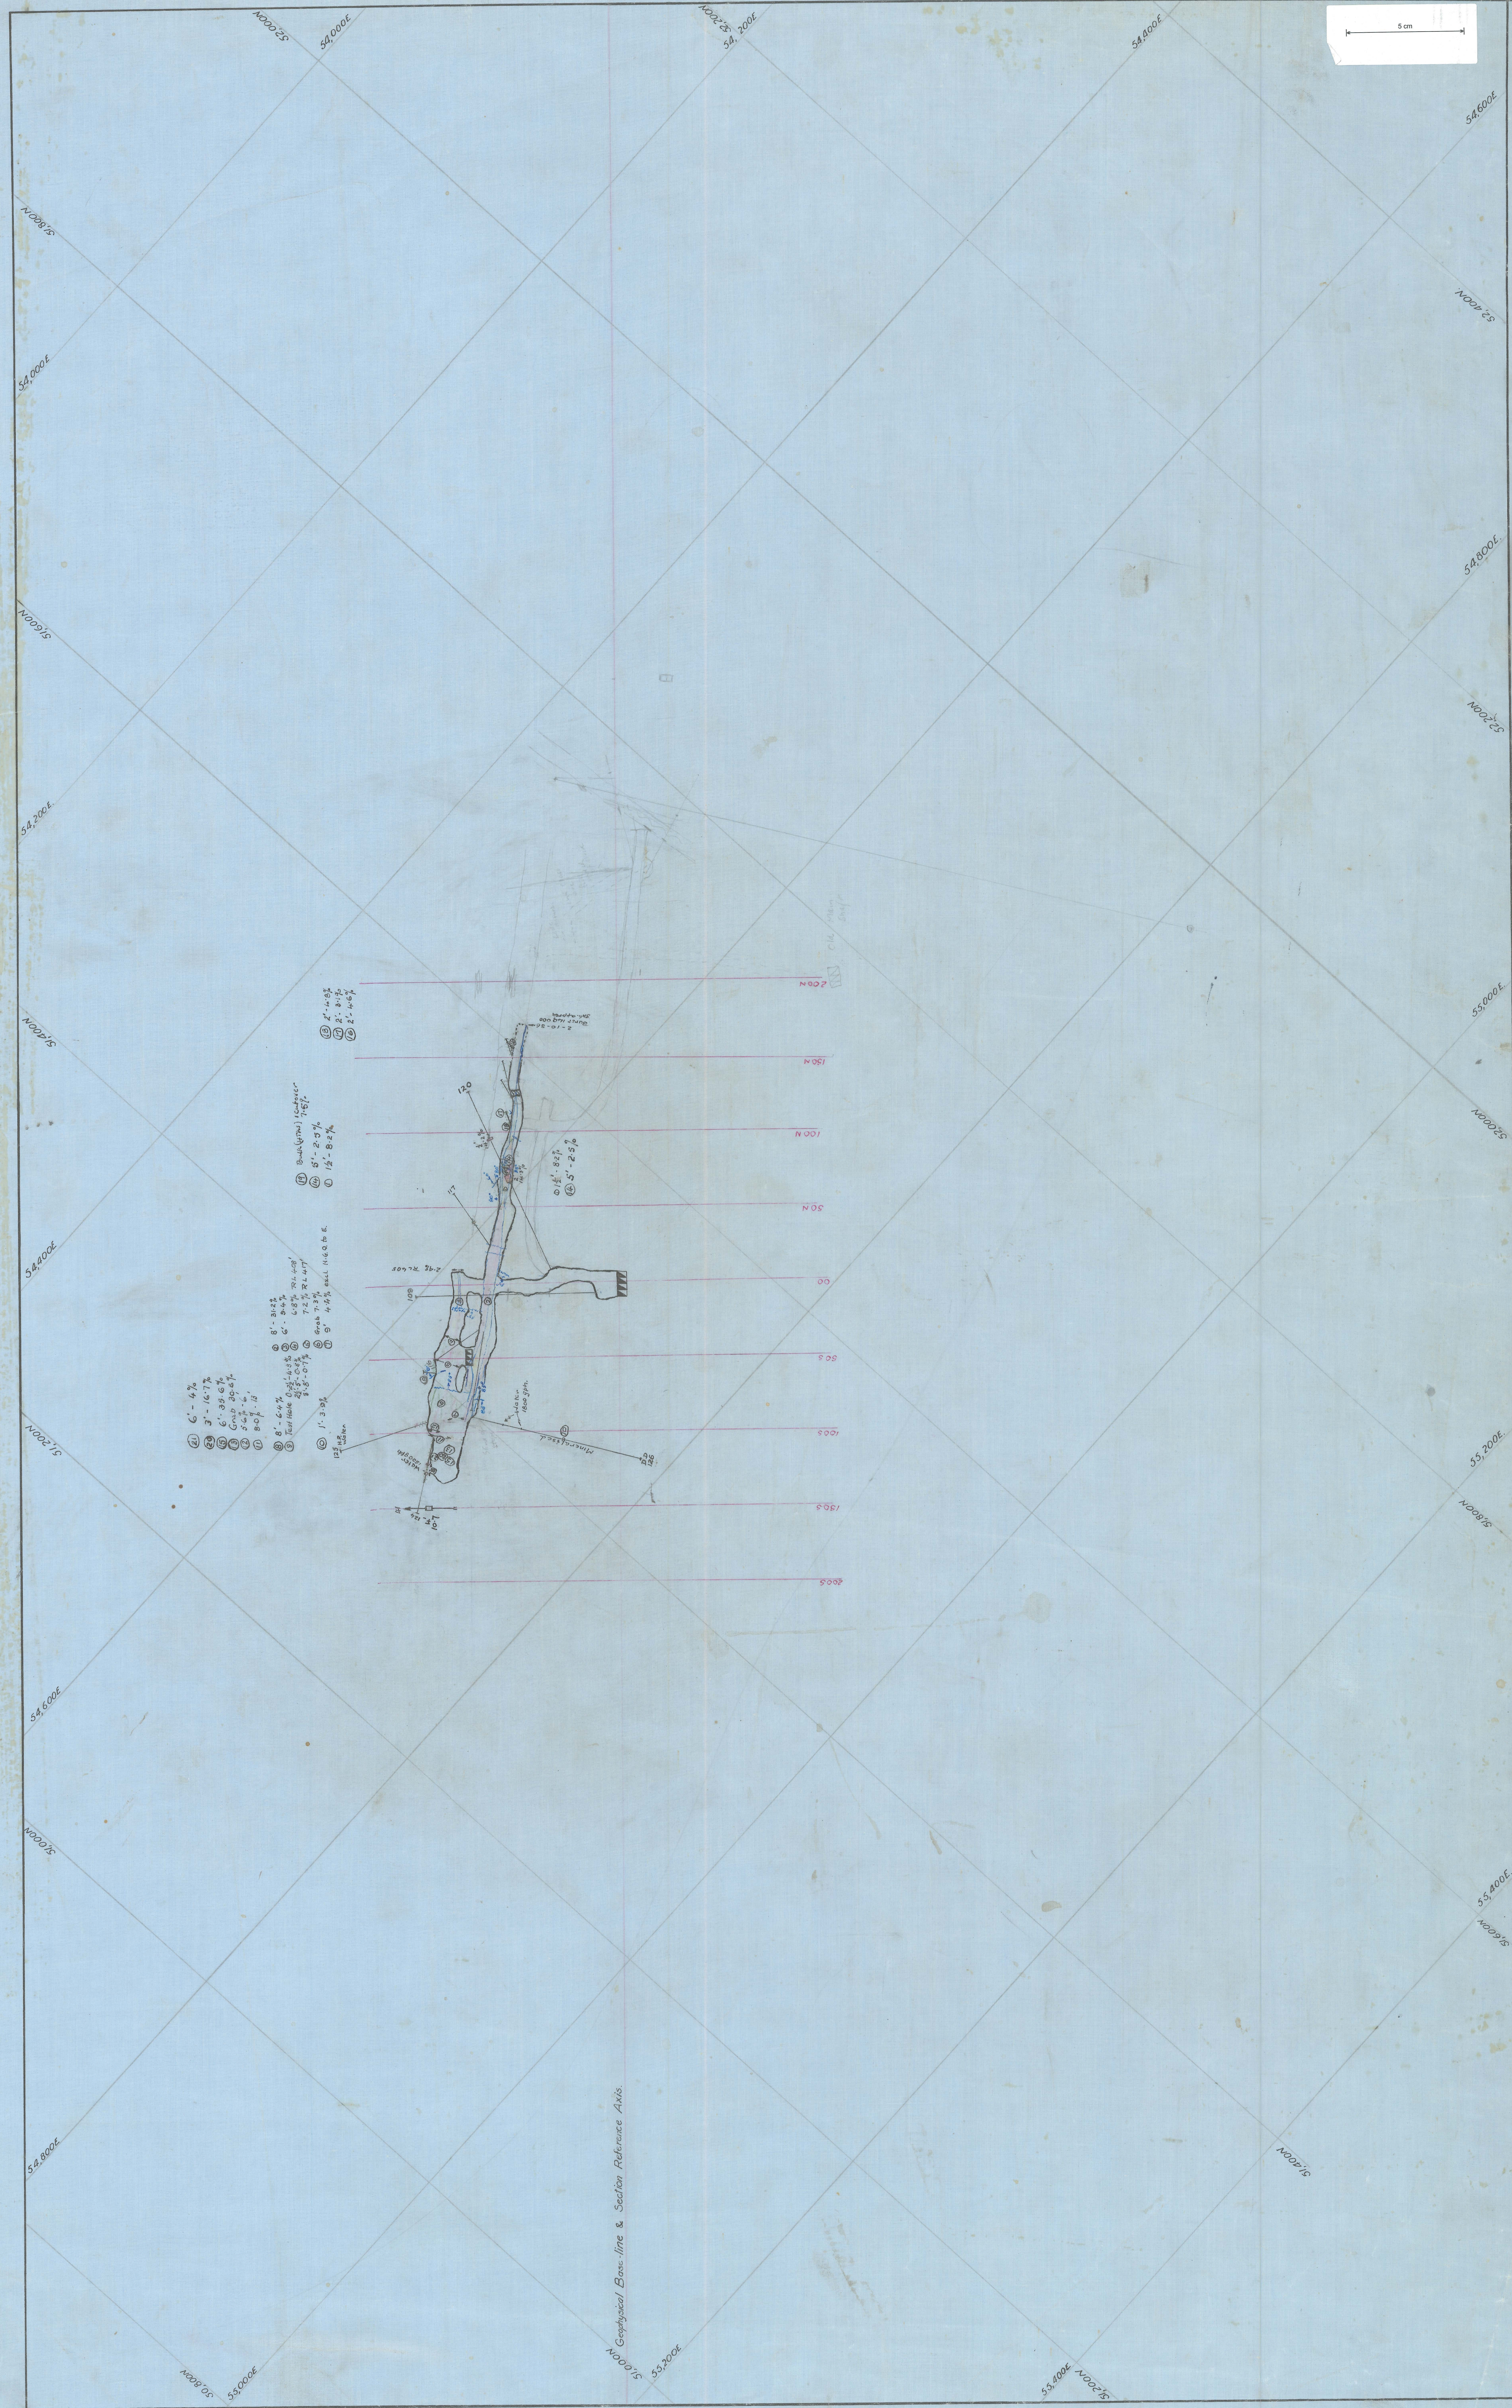

ZEEHAN MINES PTY. LTD.
OCEANA

NO 3 LEVEL

SCALE 1" : 40'