


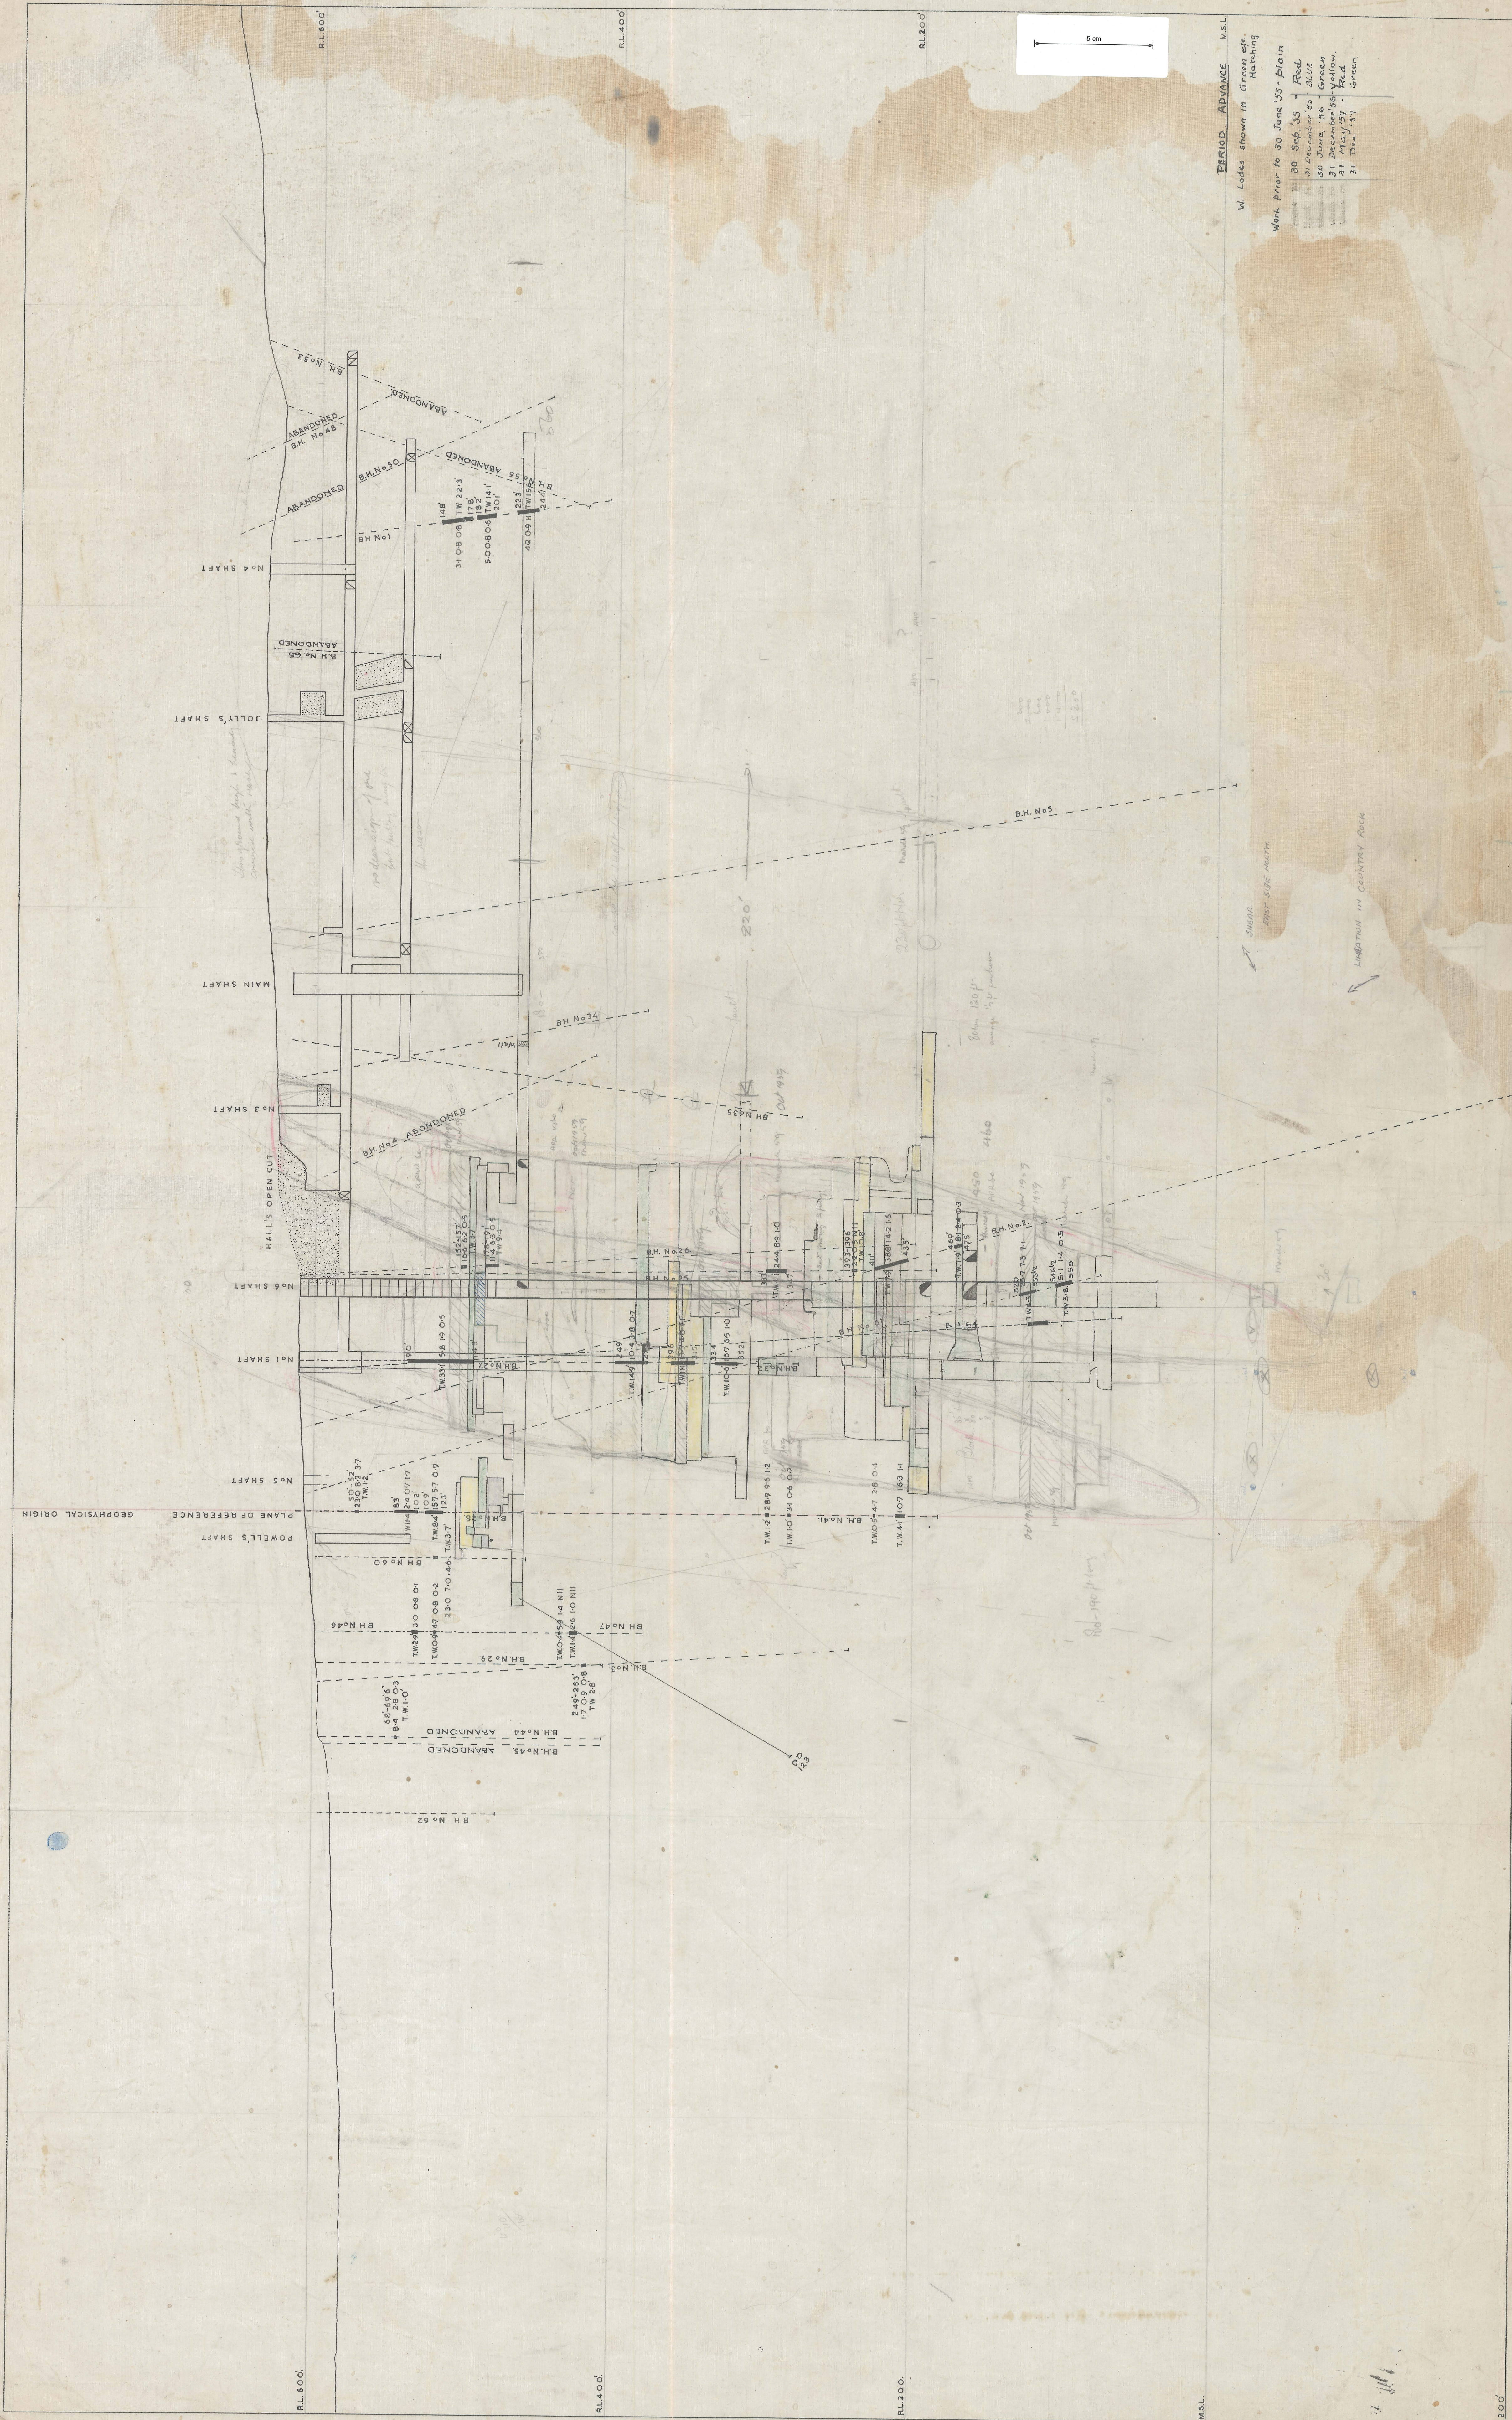

VERTICAL LONGITUDINAL PROJECTION

SCALE 1" = 40'

ZEEHAN EXPLORATIONS

OCEANA

LOOKING WEST

PLANE OF REFERENCE ON GEOPHYSICAL BASELINE N42°30'W