JUNCTION SILVER MINING COMPANY

SCALE 25 FEET TO AN INCH

W. H. Wesley
19.3.94

PLAN

819
87M

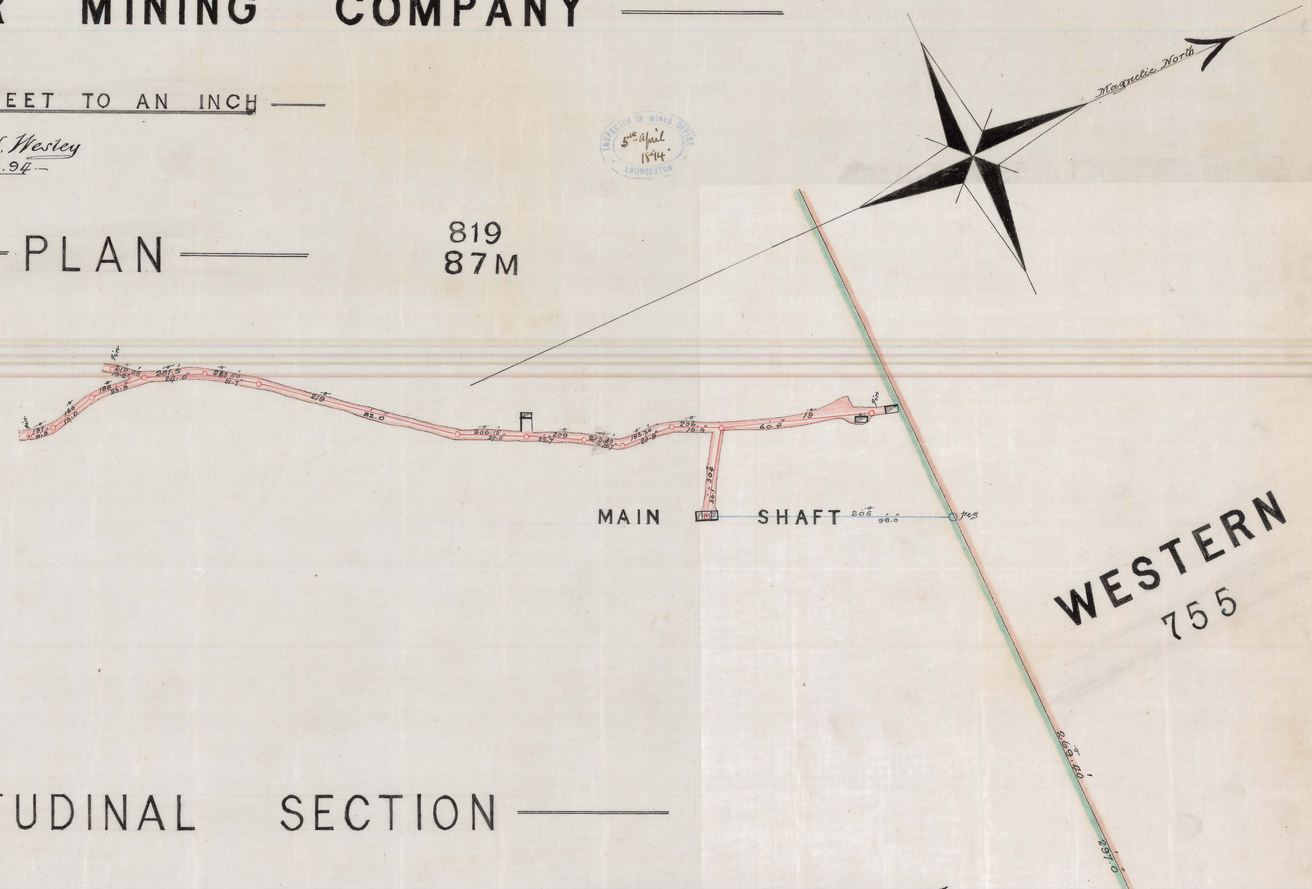

LONGITUDINAL SECTION

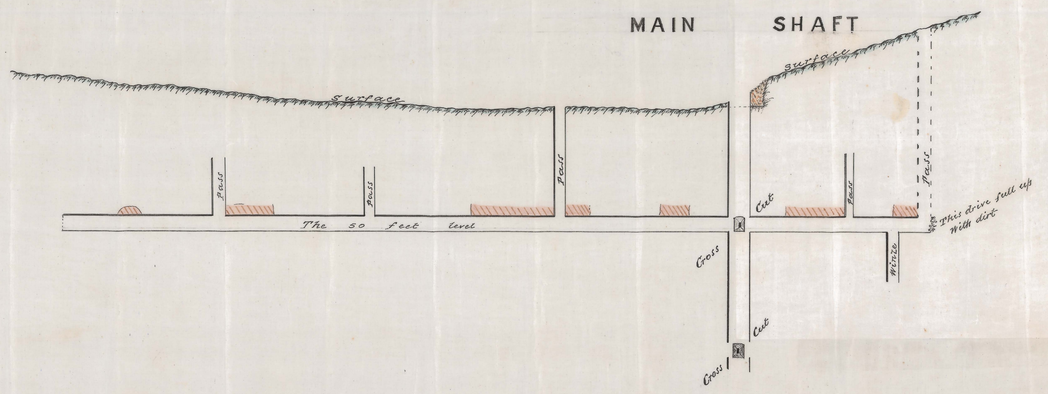

Reference

Ground Wrought to 31st December 1893.

5 cm