
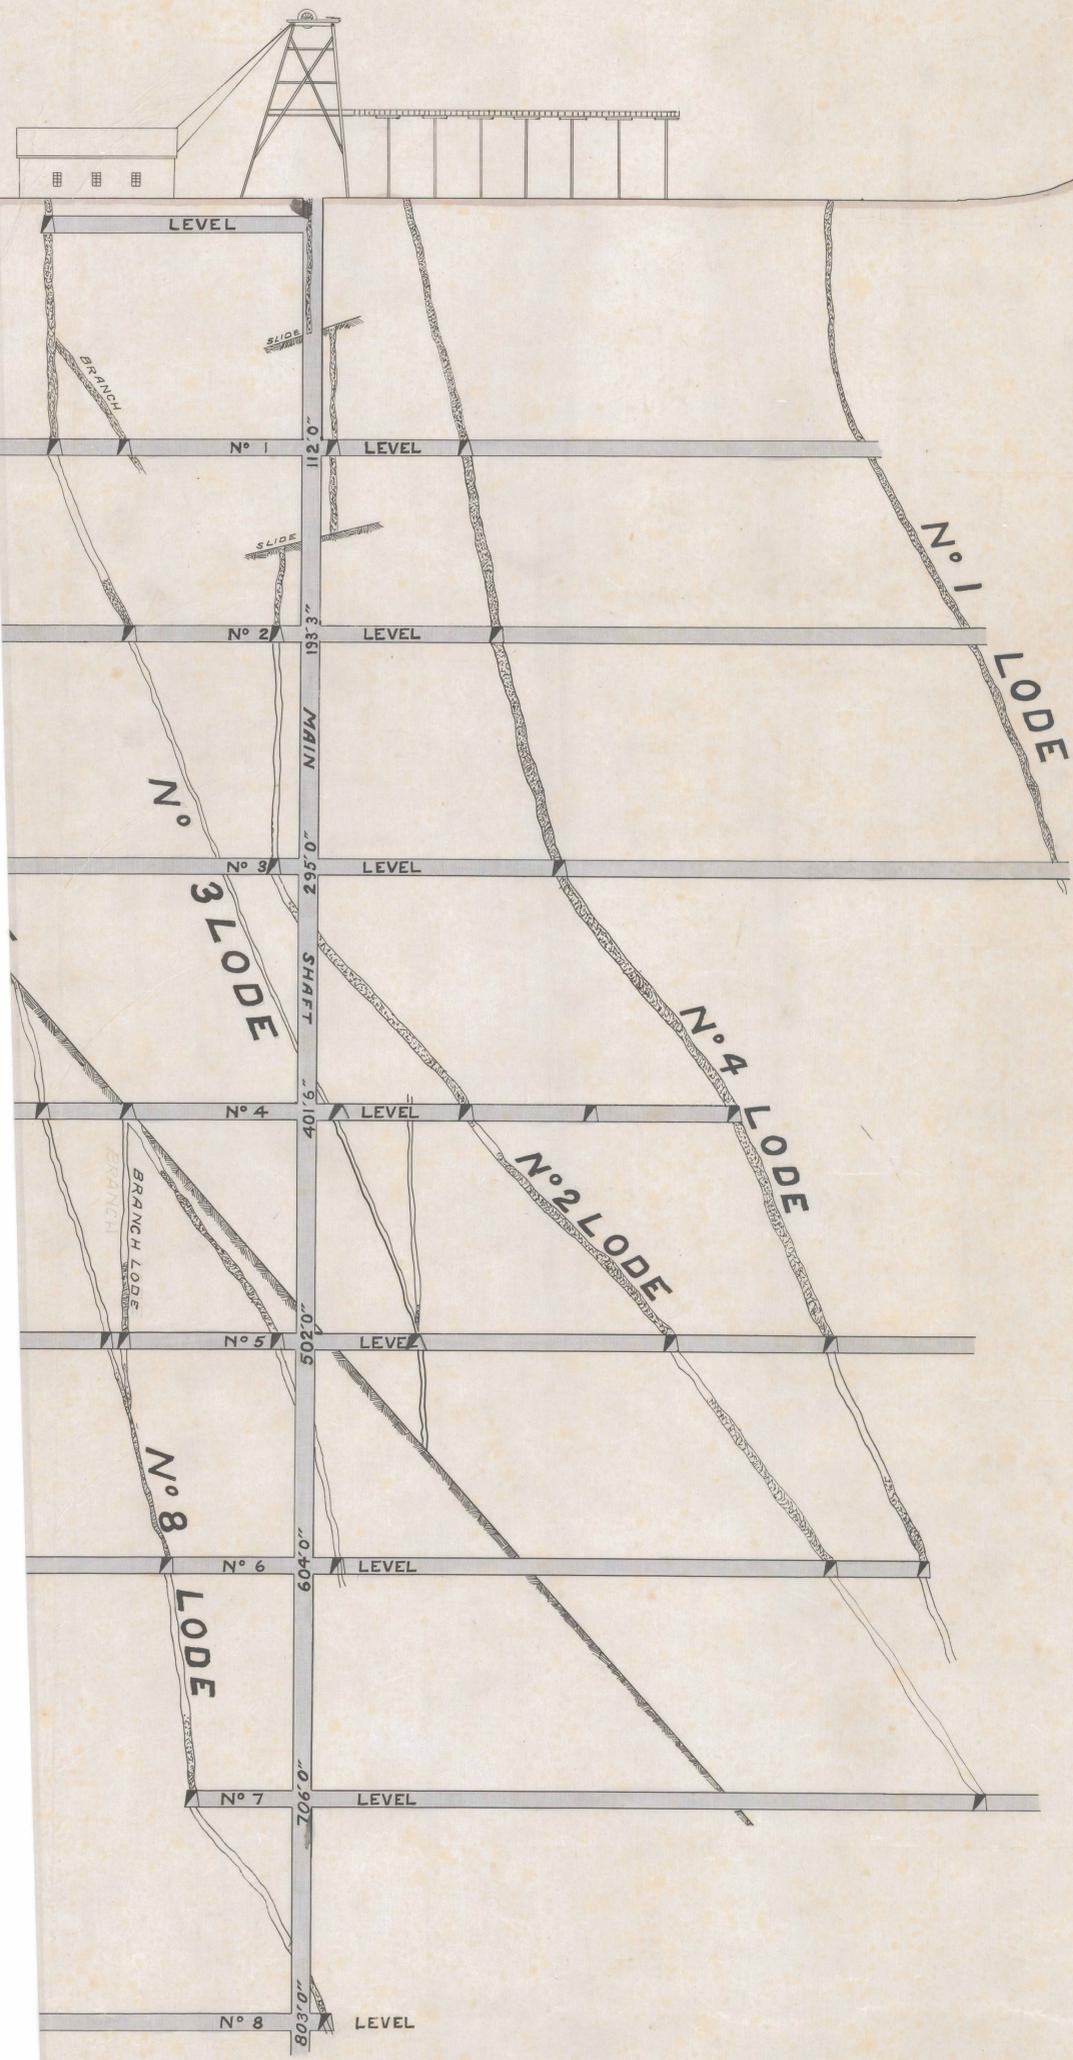


TANA LIMITED

Y THROUGH SHAFT

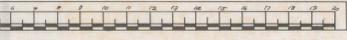

J. Cruz
MANAGER

J. Cruz Dec 31st 1907
J. Cruz Dec 31st 1908
J. Cruz Dec 31st 1909
J. Cruz Dec 31st 1910
J. Cruz Dec 31st 1911