

THE



360-04



# ZEEHAN — MONTANA L<sup>TD</sup>

## N<sup>o</sup> 2 SHAFT

SCALE

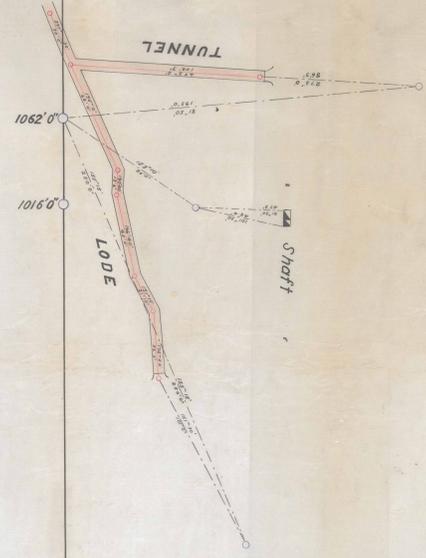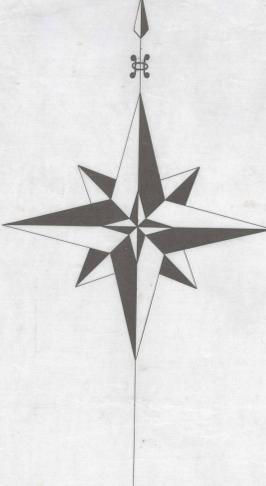

1636 M

Air Shaft



243  
87 M

— REFERENCE —

N<sup>o</sup> 1 LEVEL 111' 0"  
 N<sup>o</sup> 2 LEVEL 218' 0"

TUNNEL

*J. Craig*  
 — MANAGER —  
 31<sup>st</sup> Jan 1905

