ZEEHAN MONTANA. S.M.Co.

Scale 30 ft. One Inch

Section of No 1 Lode

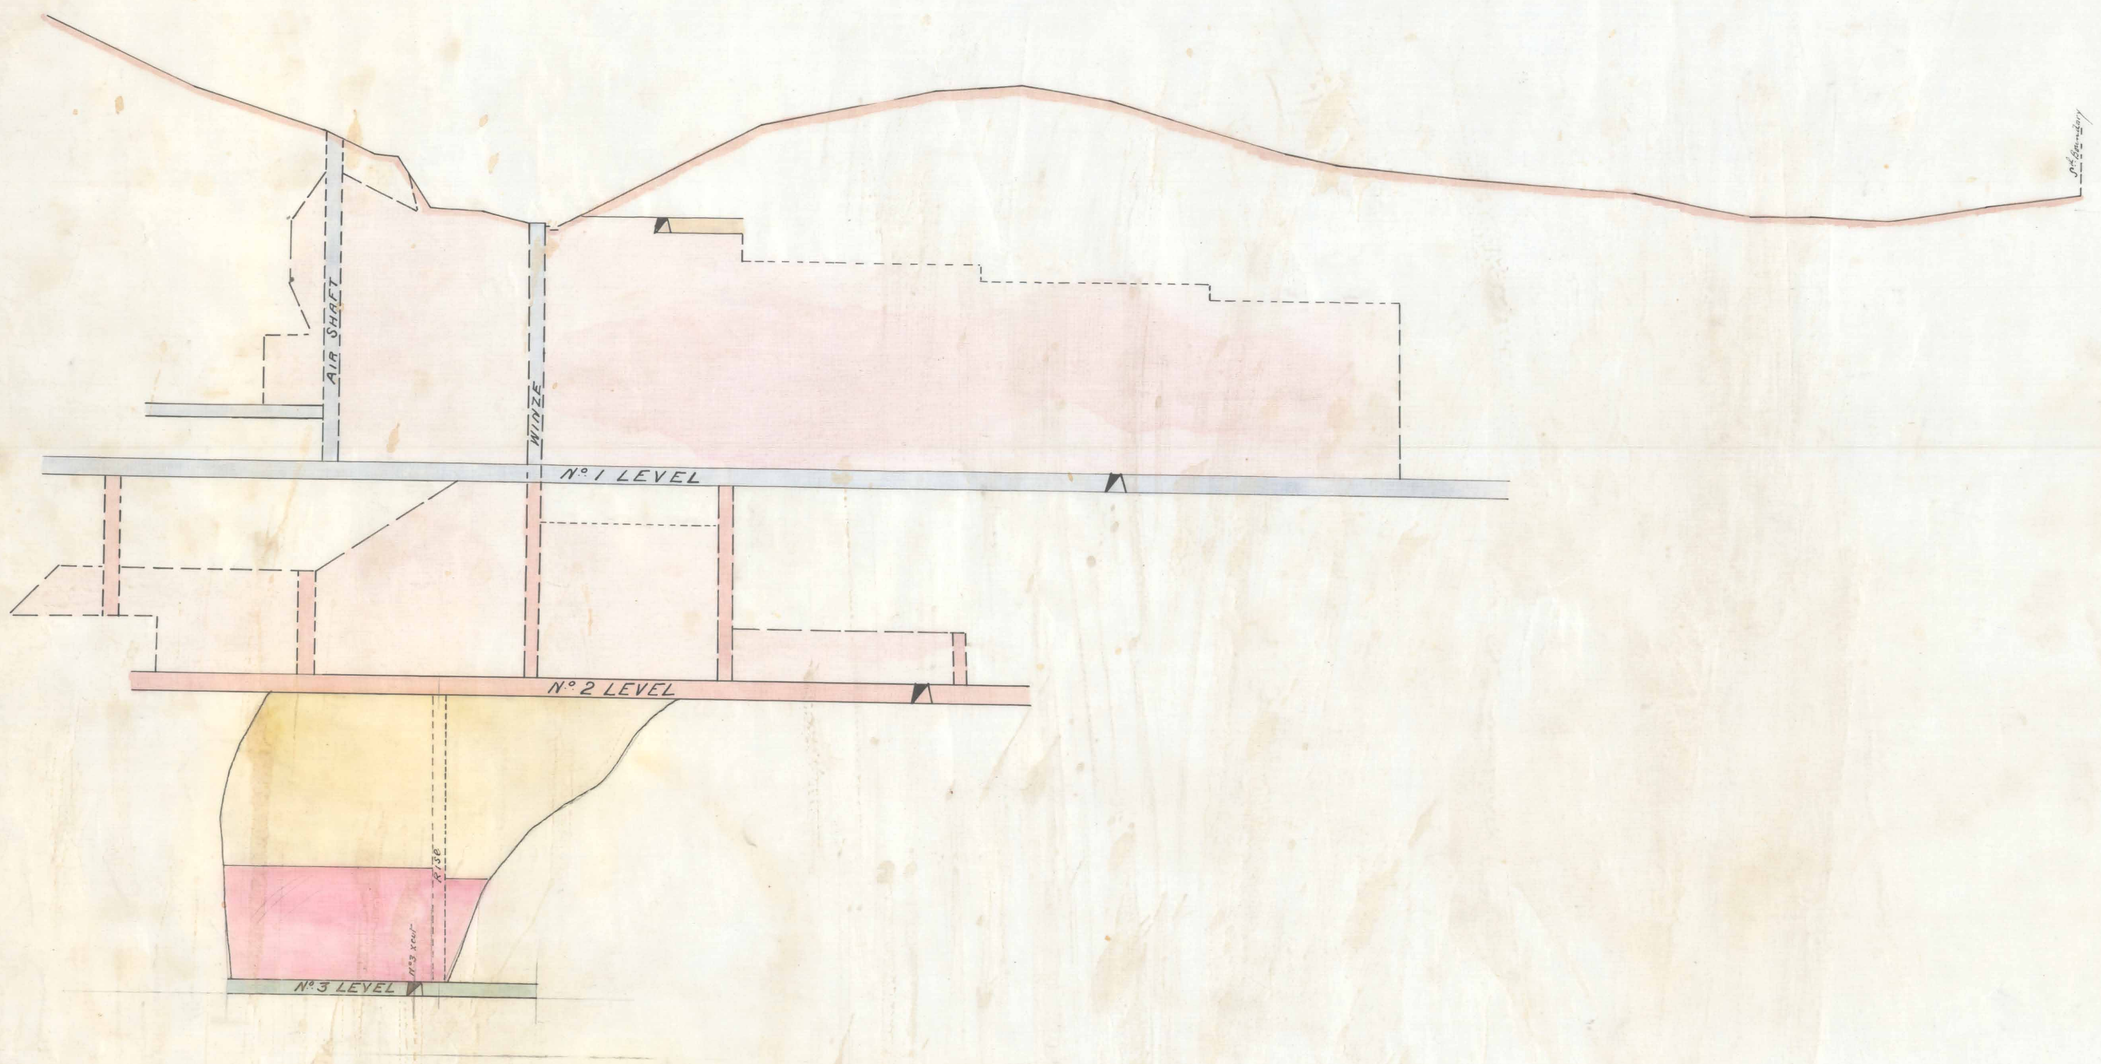

Section of No 4 Lode
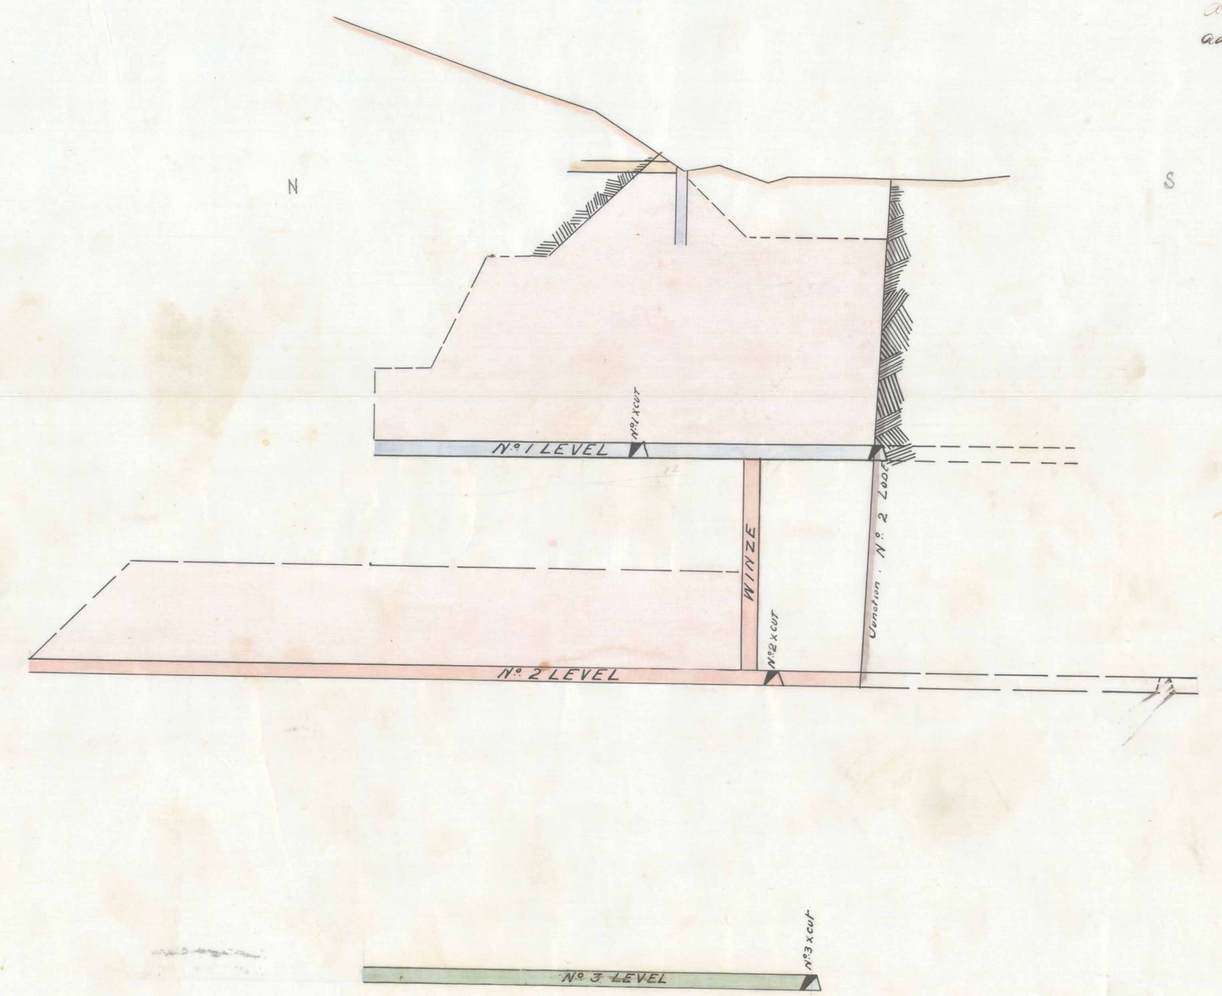
J. Grage
Manager
Jan 12th 1899
added to Jan 21st 1900
added to Jan 18th 1901 (Grage Manager
Jan 19th 1902 "