
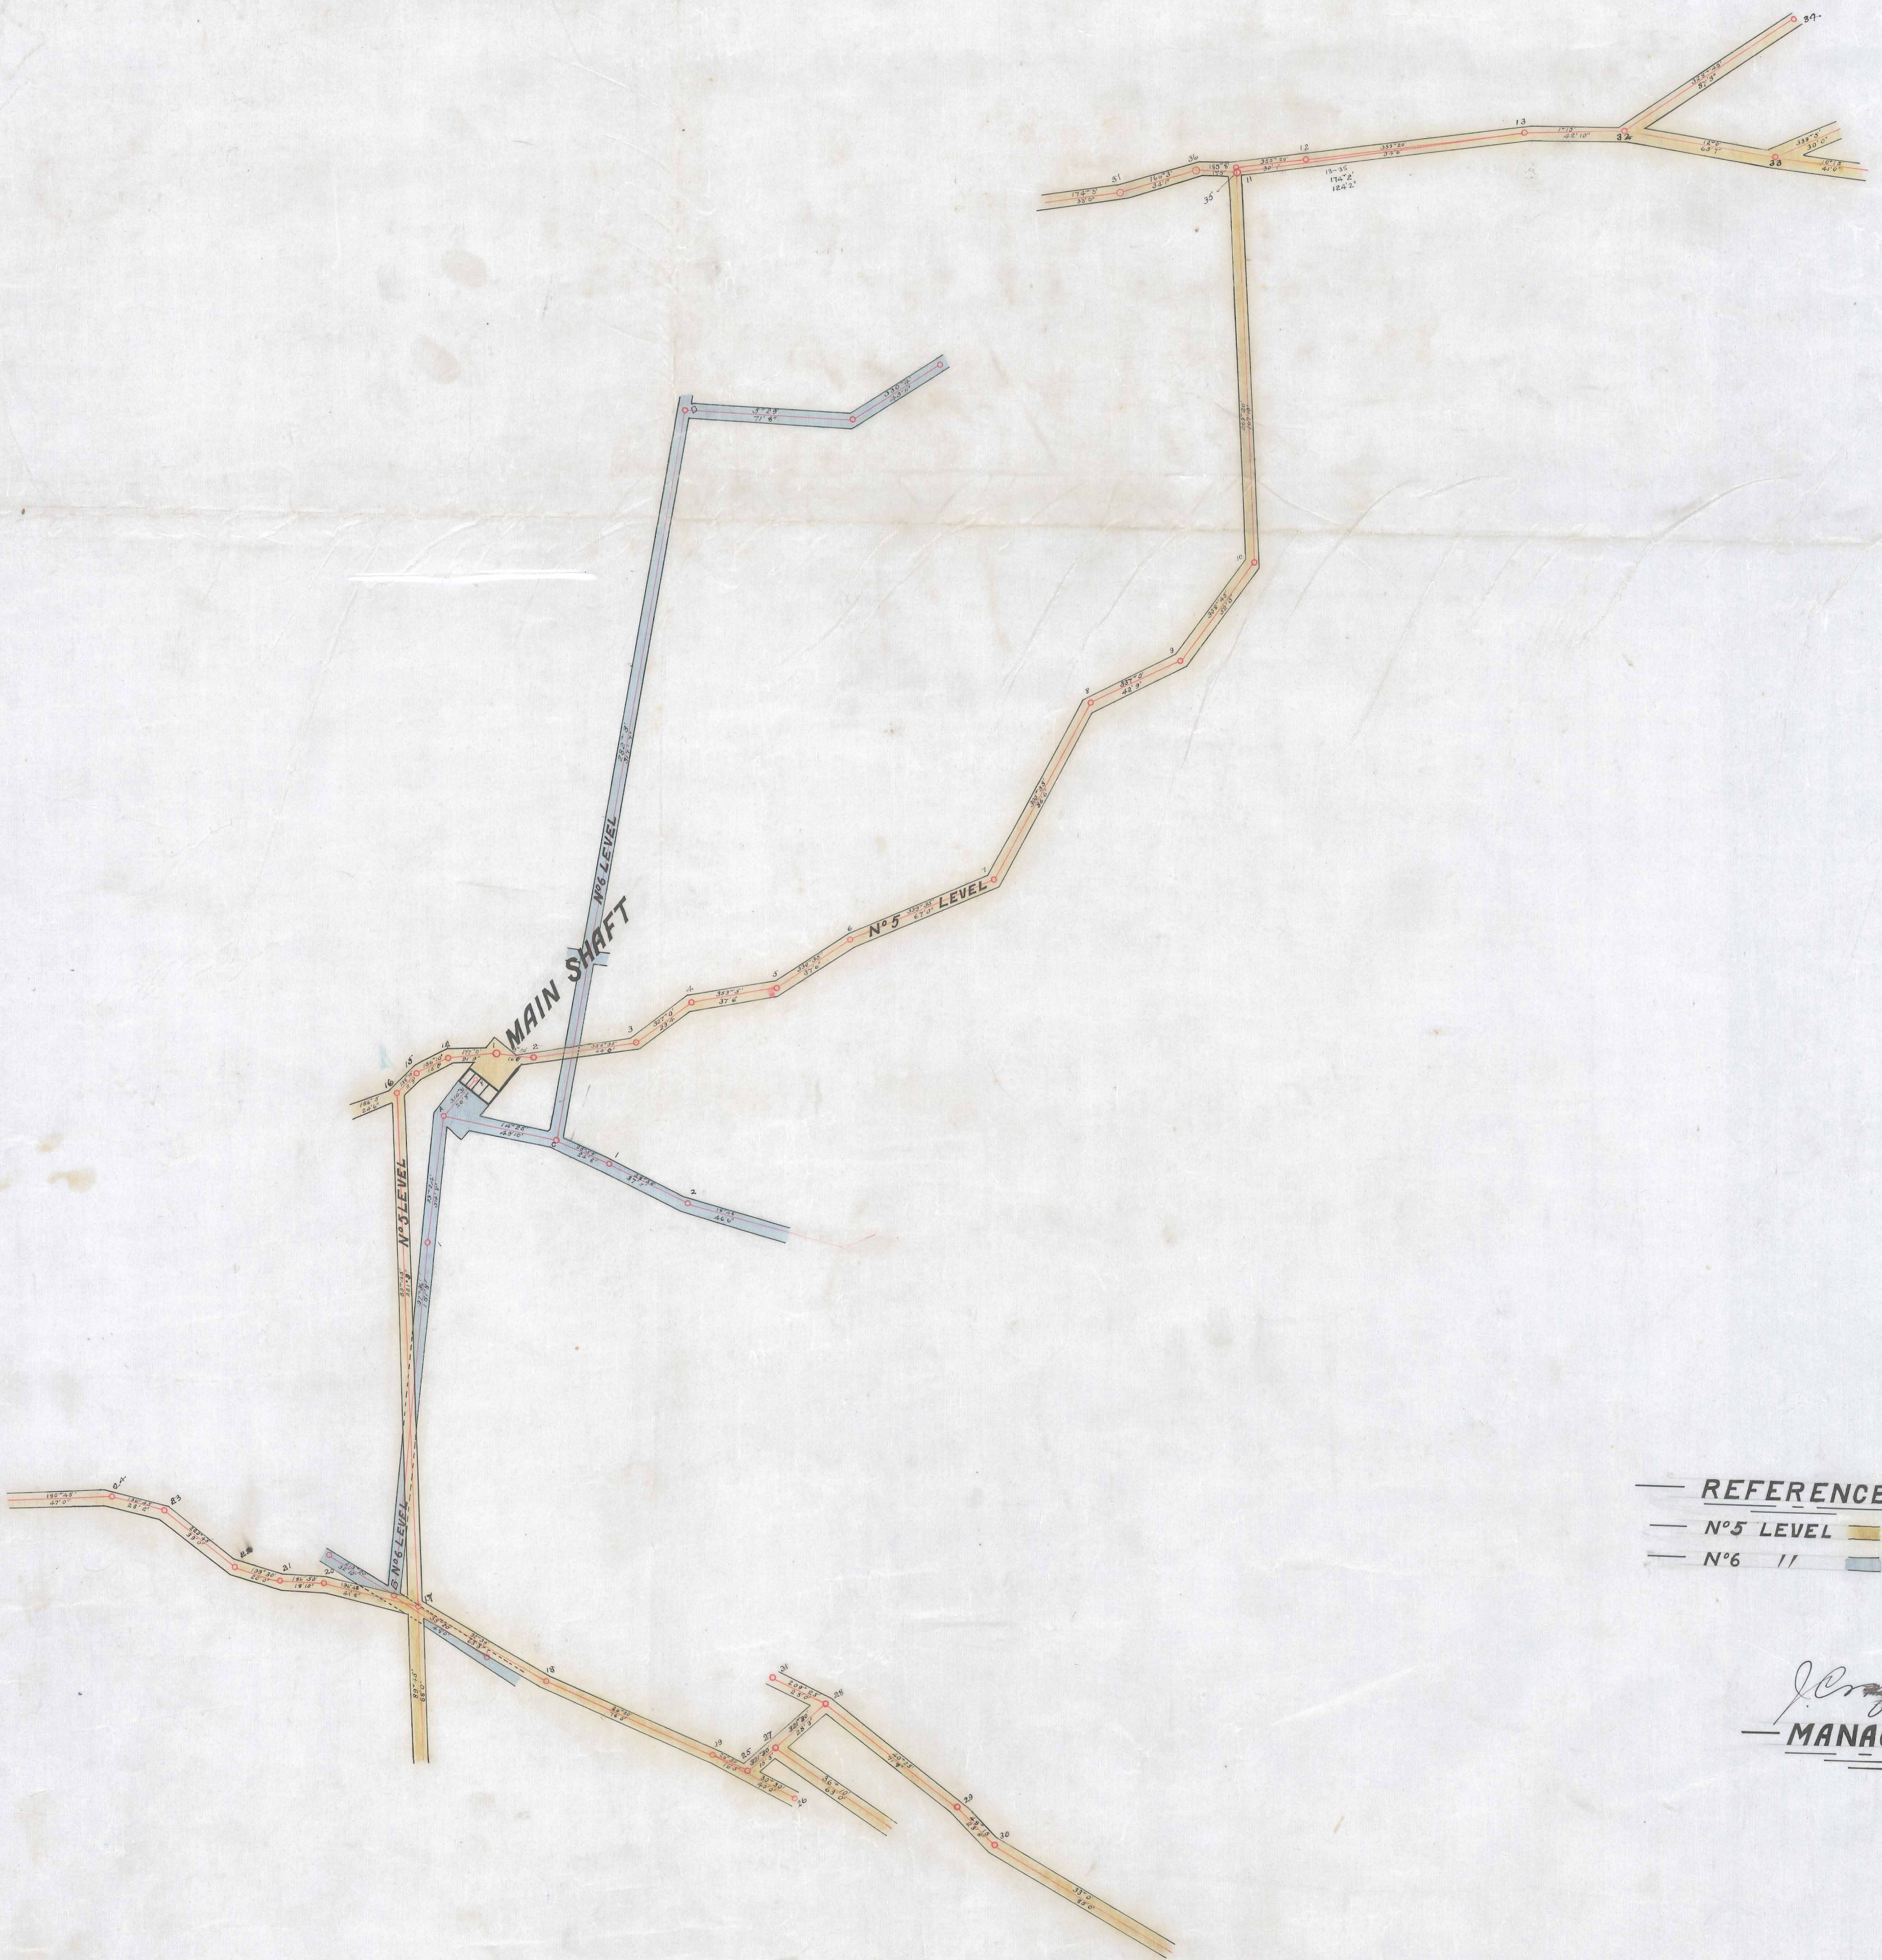
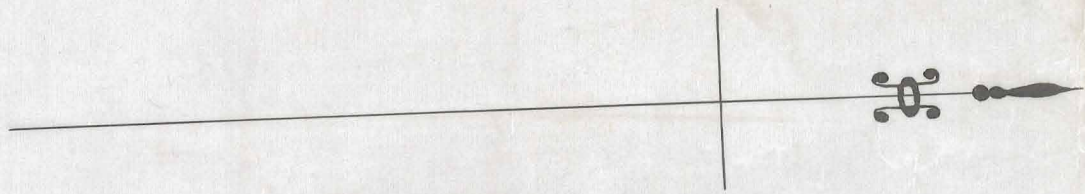


THE
ZEEHAN-MONTANA
LIMITED

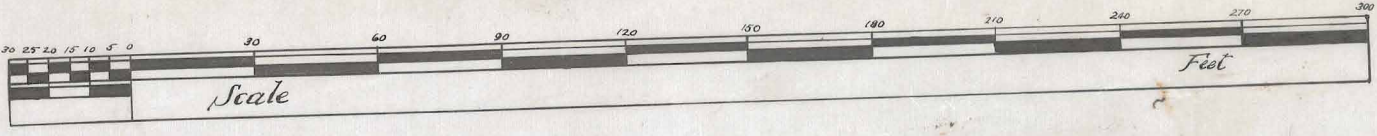

REFERENCE
N° 5 LEVEL
N° 6 //

J. Craig
MANAGER

26 Feb 1904