


5 cm

500-13

ZEEHAN-MONTANA

N° 1 SHAFT

SCALE 30F^x = 1"

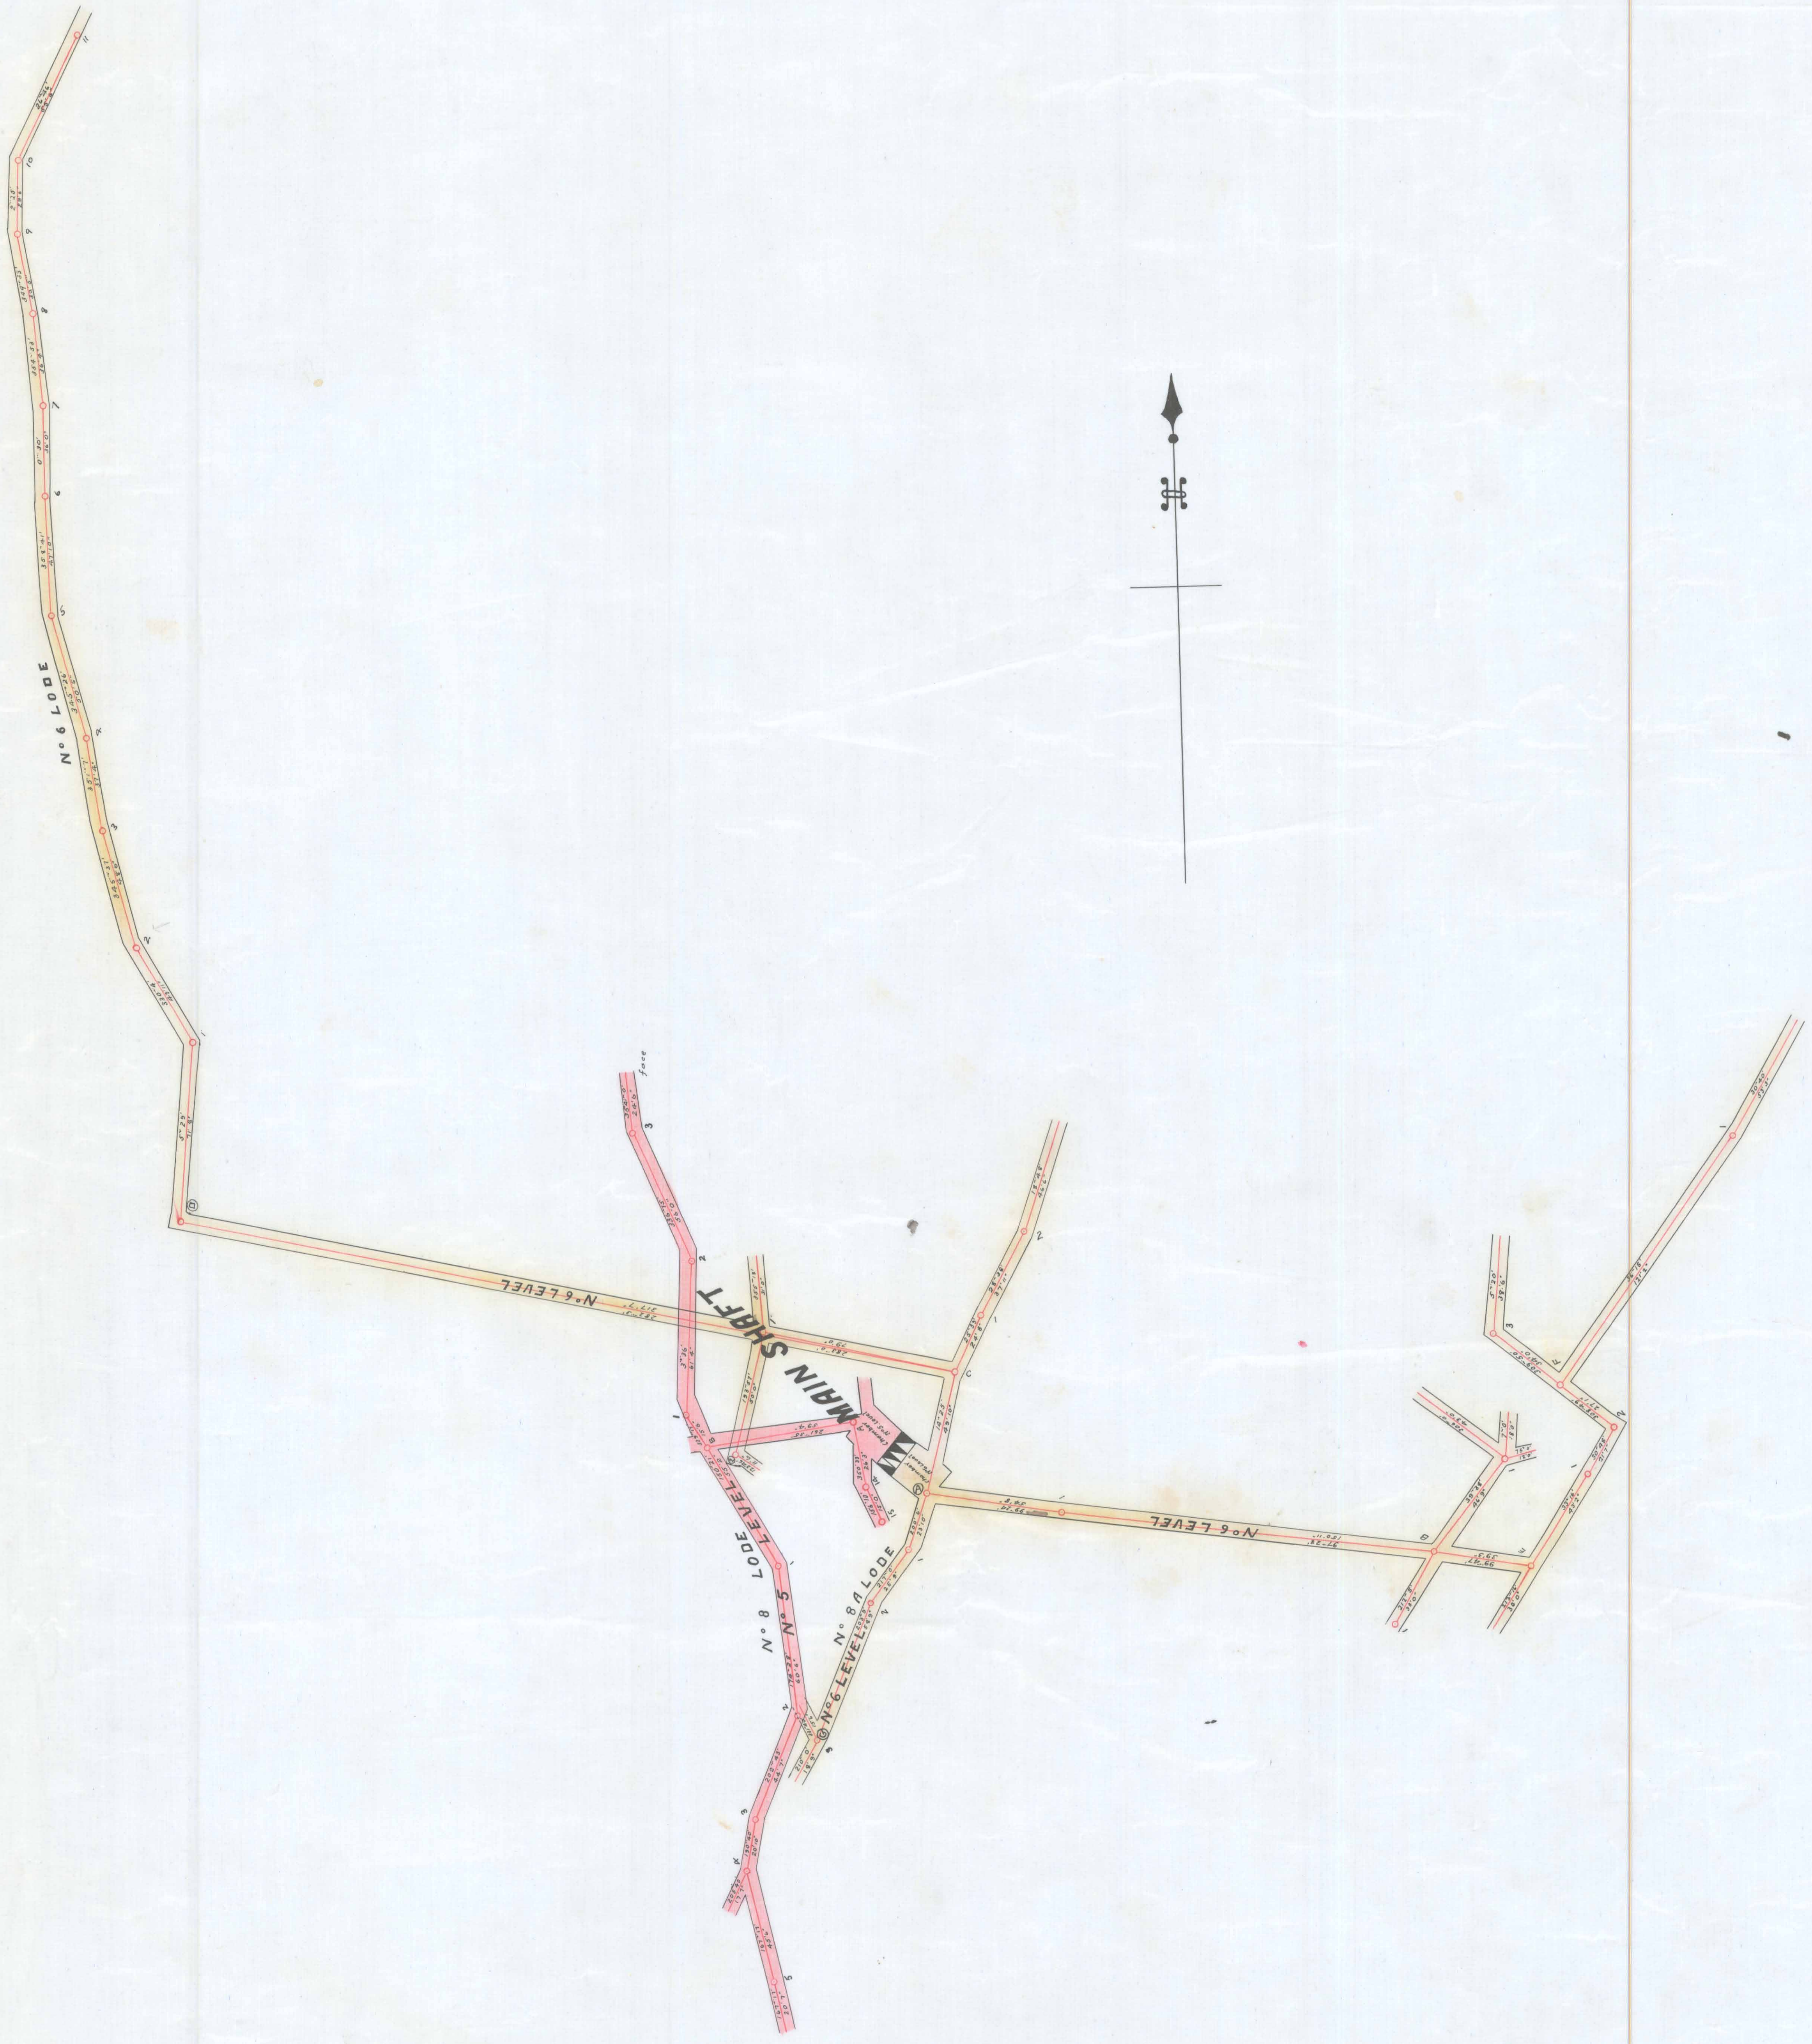

J. Craig 31st Jan 1905
MANAGER