ZEEHAN-MONTANA S. M.

MINING WORKS

Scale 30 feet to an inch

INSPECTOR OF MINES OFFICE
29/1/94
LAUNCESTON

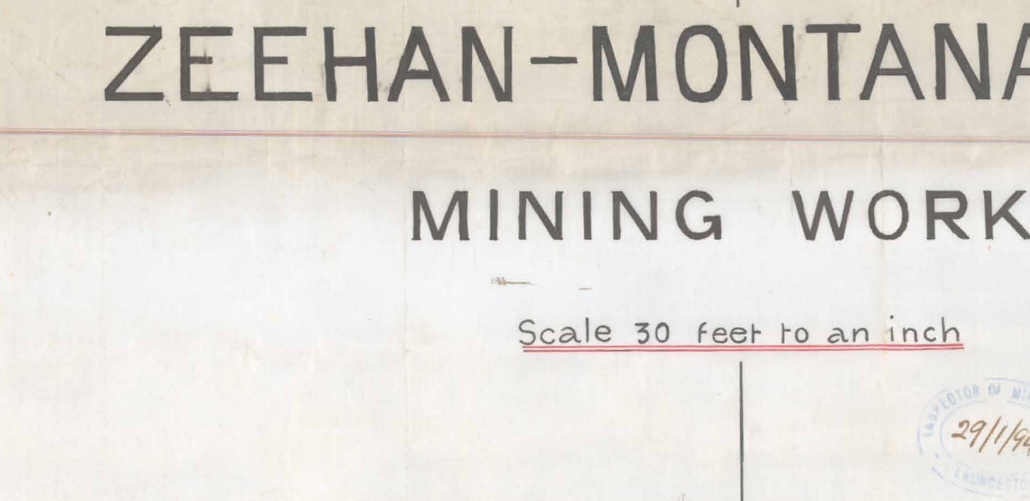

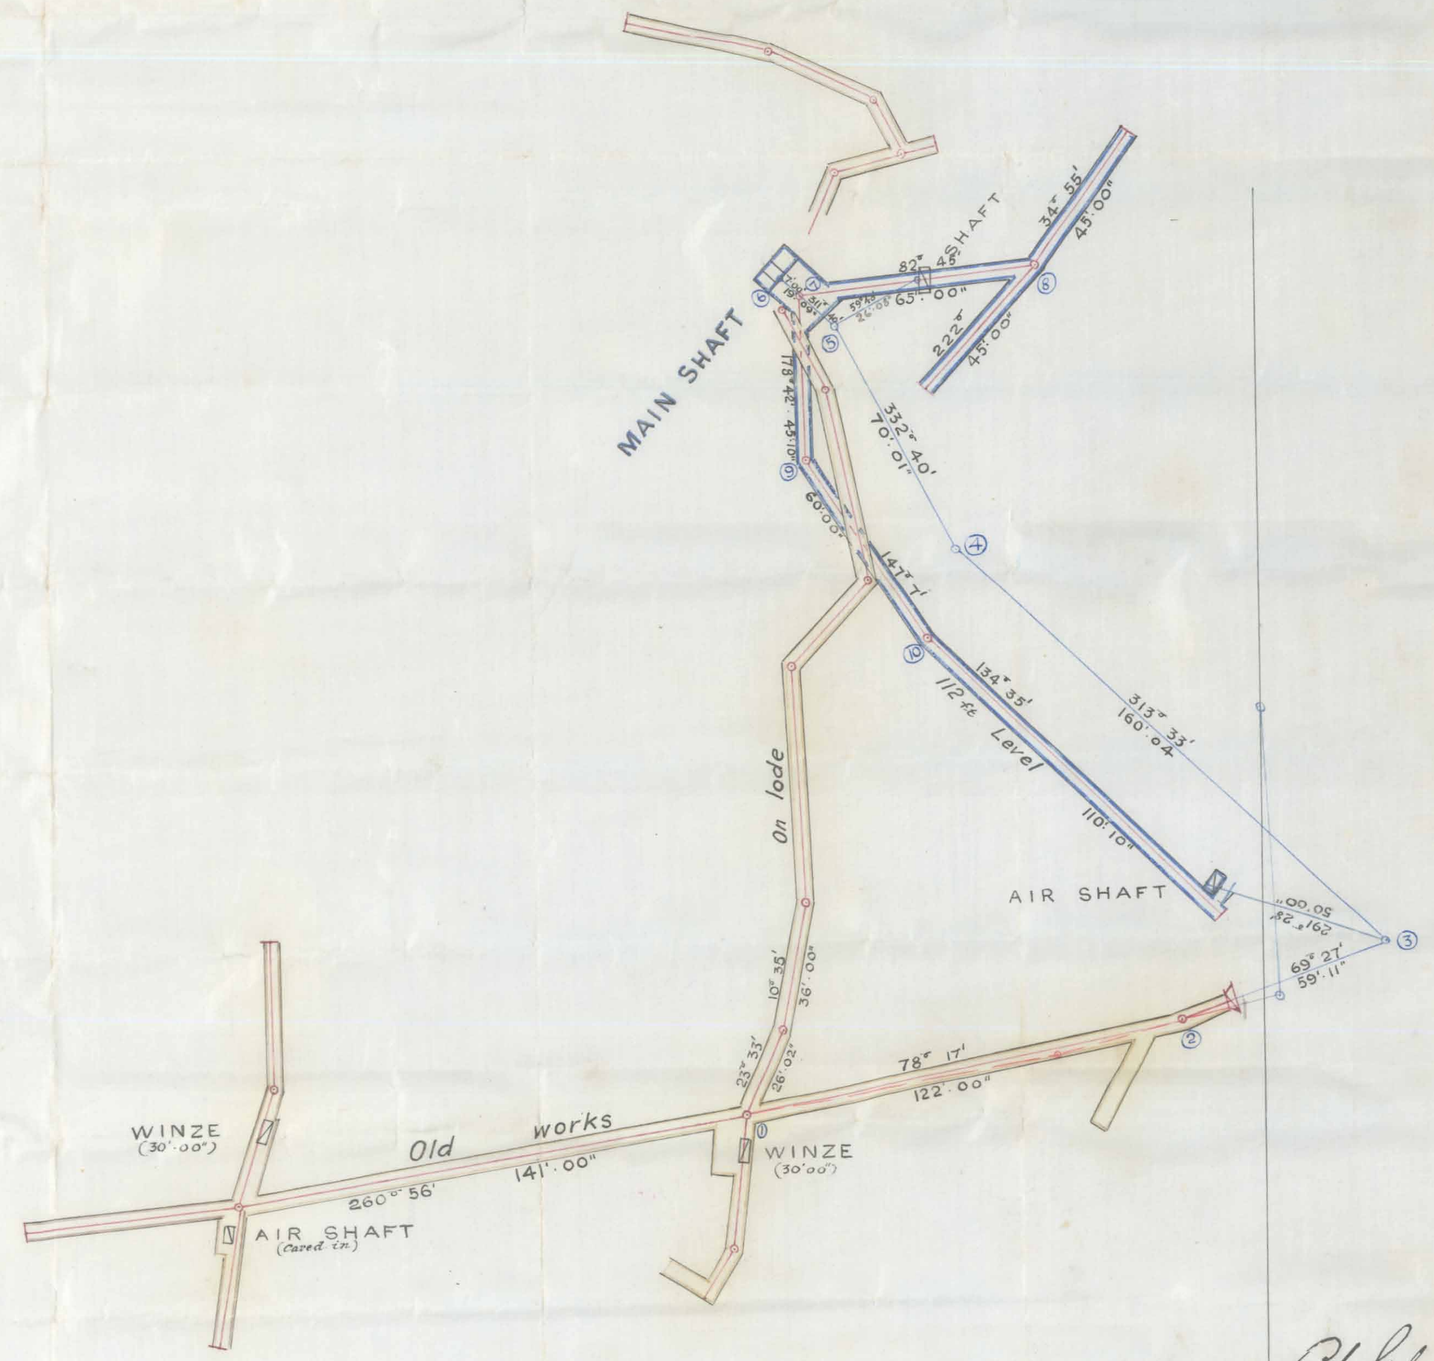

C W Glover
Asst Surveyor
Zeehan Jan '94