


ZEEHAN-MONTANA

LONGITUDINAL SECTION

ON

N° 6 LODE

SILVER QUEEN S.M.
BOUNDARY

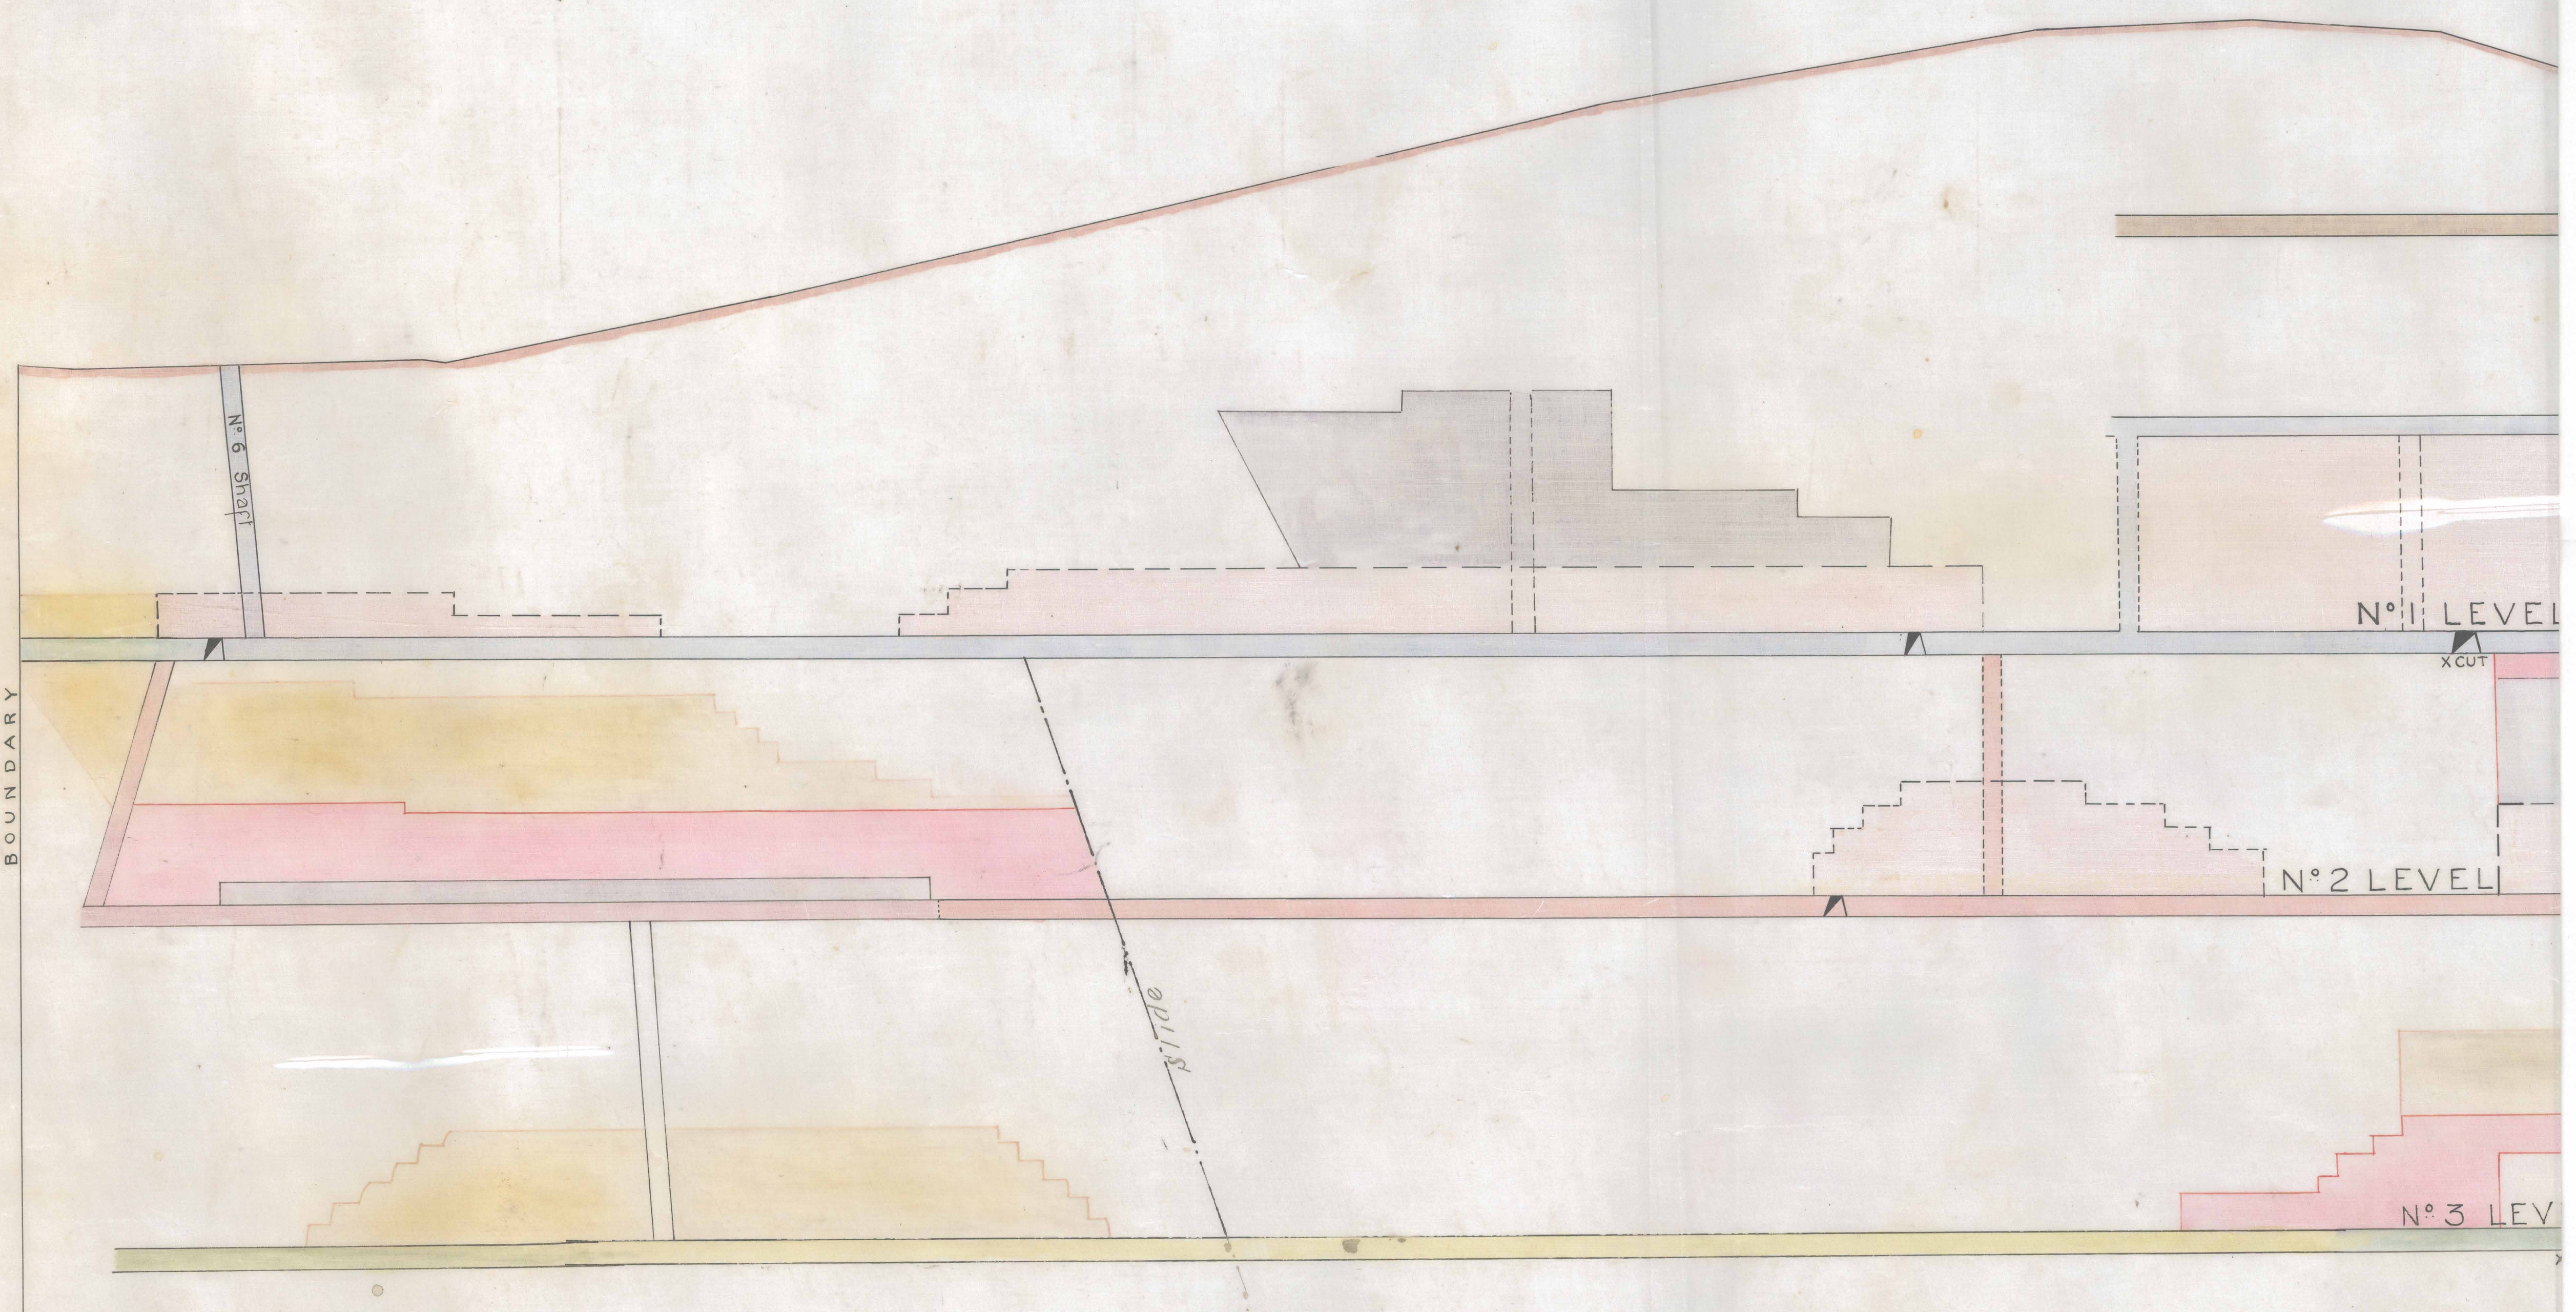

N° 4 LEVEL