


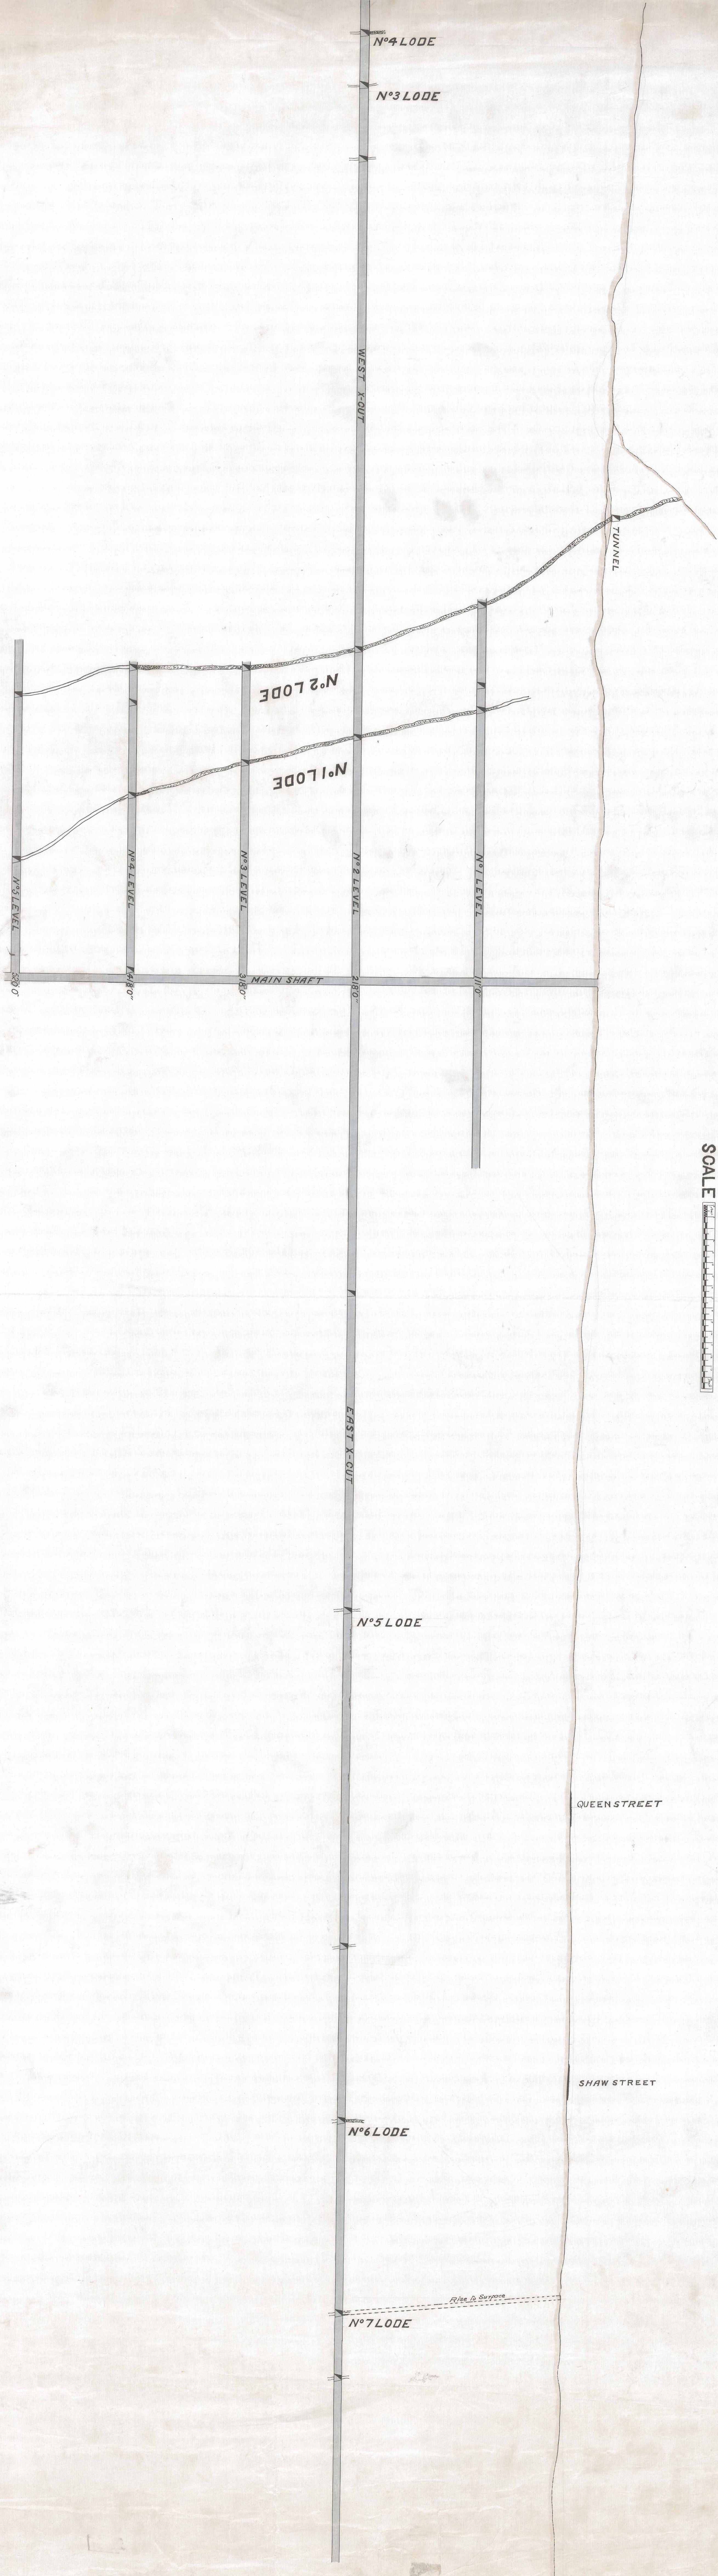

ZEEHAN - MONTANA L^{TD}
N^o 2. SHAFT
PROJECTION ON E & W LINE THROUGH SHAFT
SCALE



[Signature]
MANAGER
1907
1908
1909
1910