

5 cm

892  
87M

40 Ac


756  
87M

40 Ac

PLAN OF  
N<sup>o</sup> 2 LEVEL

SCALE 240 FT = 1 INCH

Magnetic North

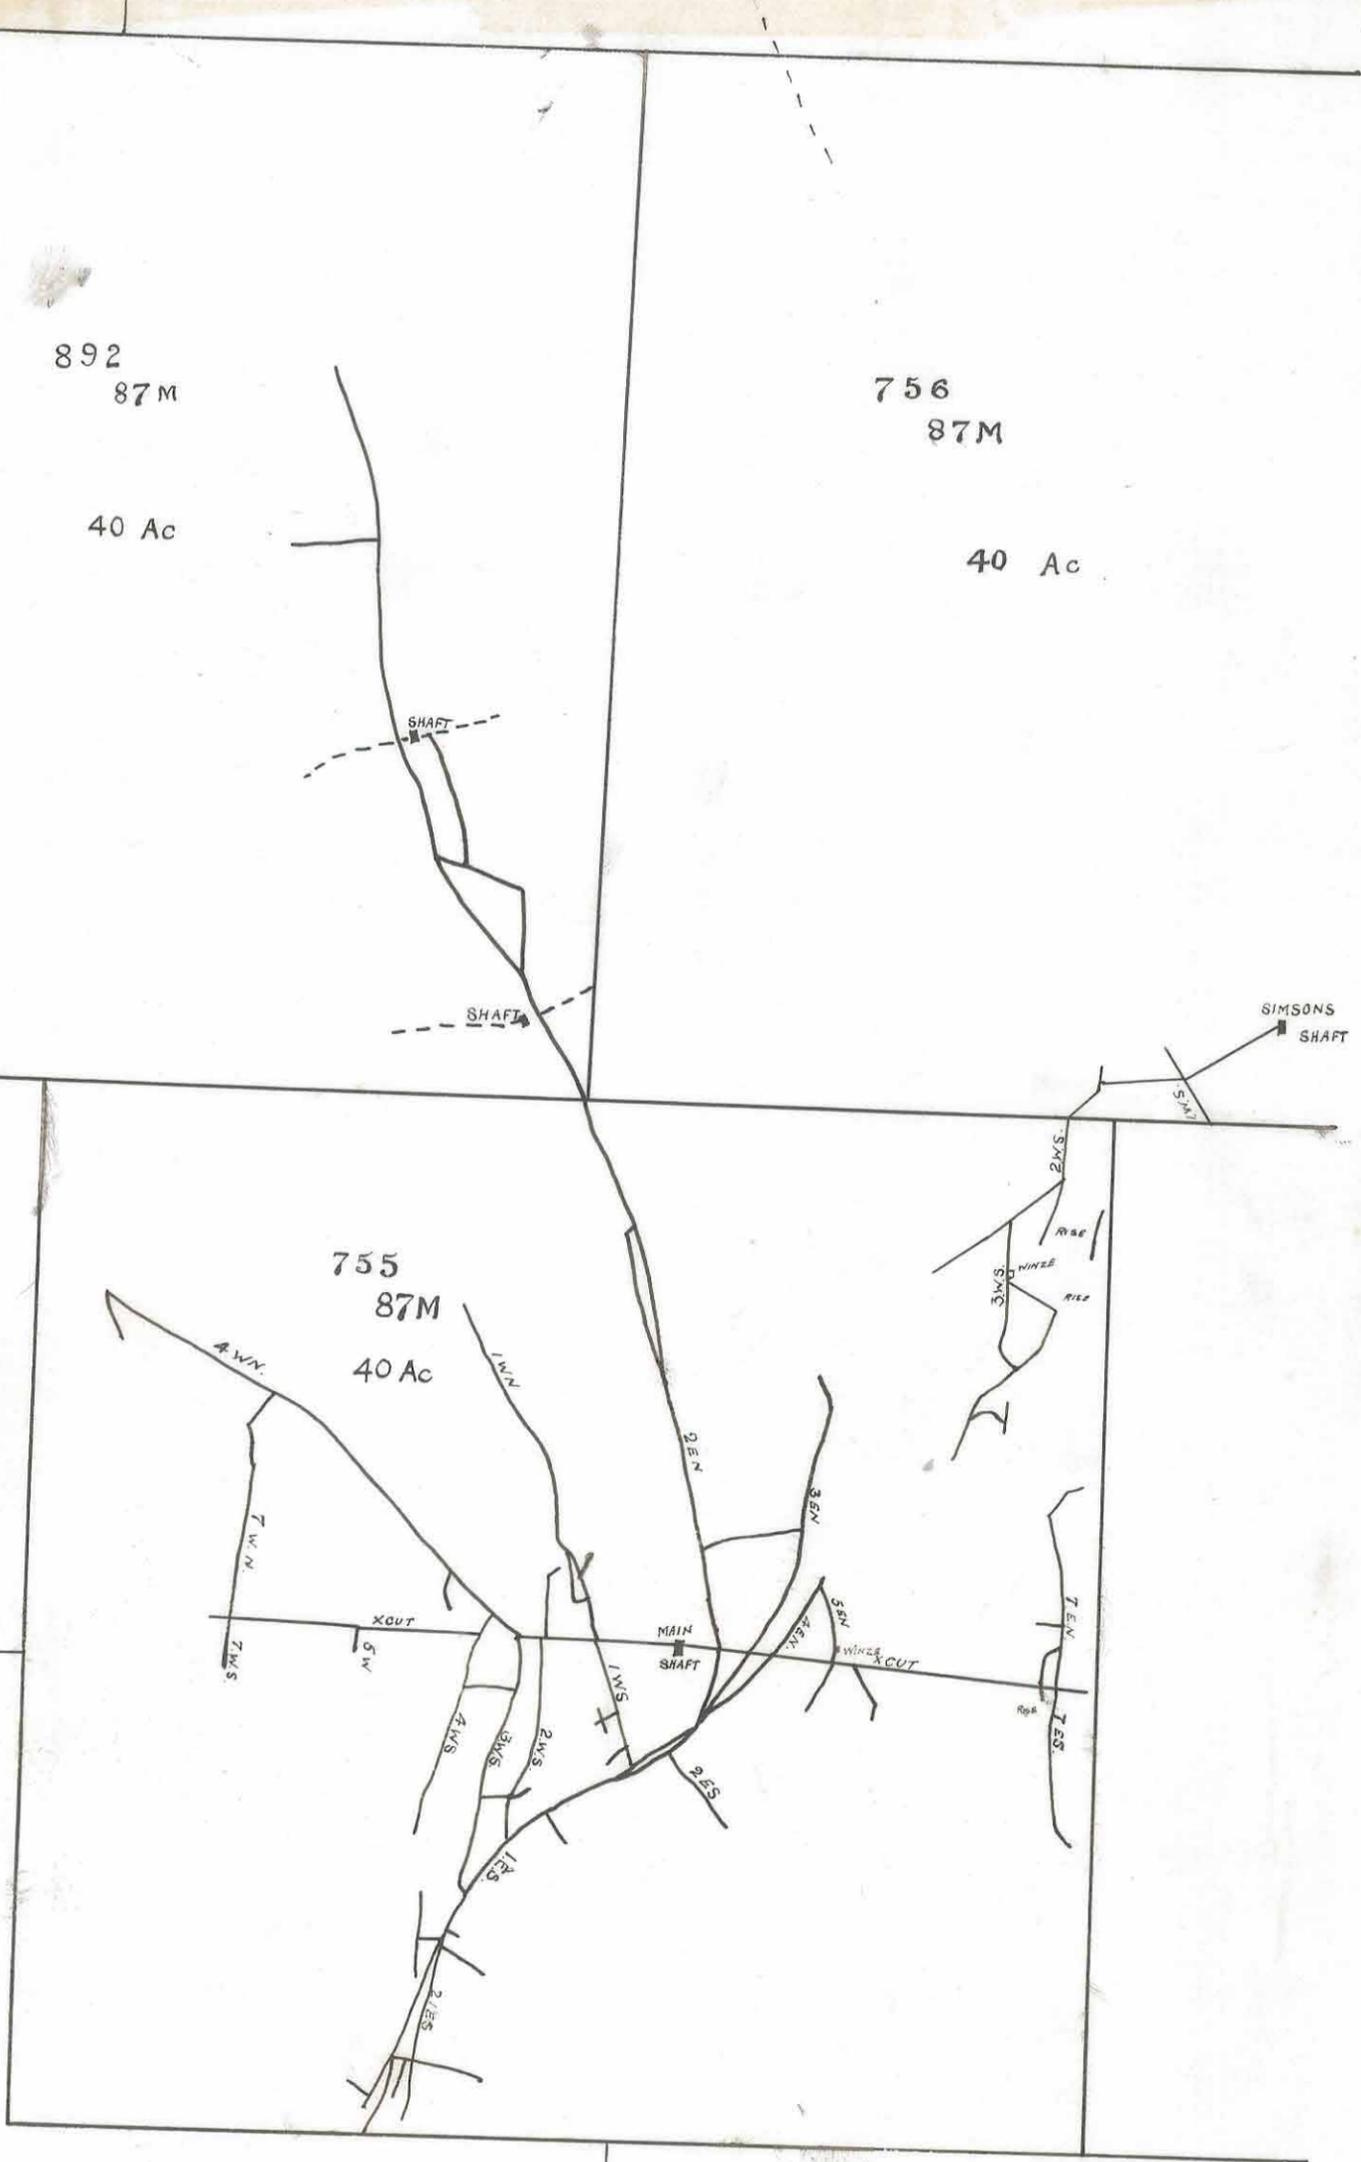

366  
- 18