



5 cm

755
87 M
40 Ac

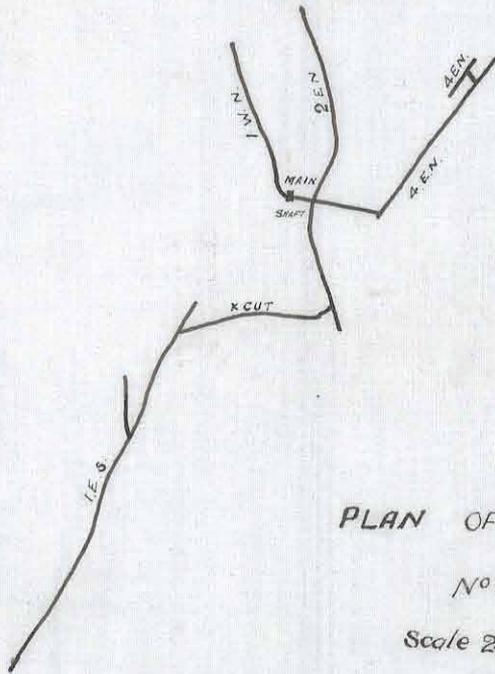

PLAN OF
N^o 6 LEVEL
Scale 240 ft = 1 inch

755
87 M
40 Ac

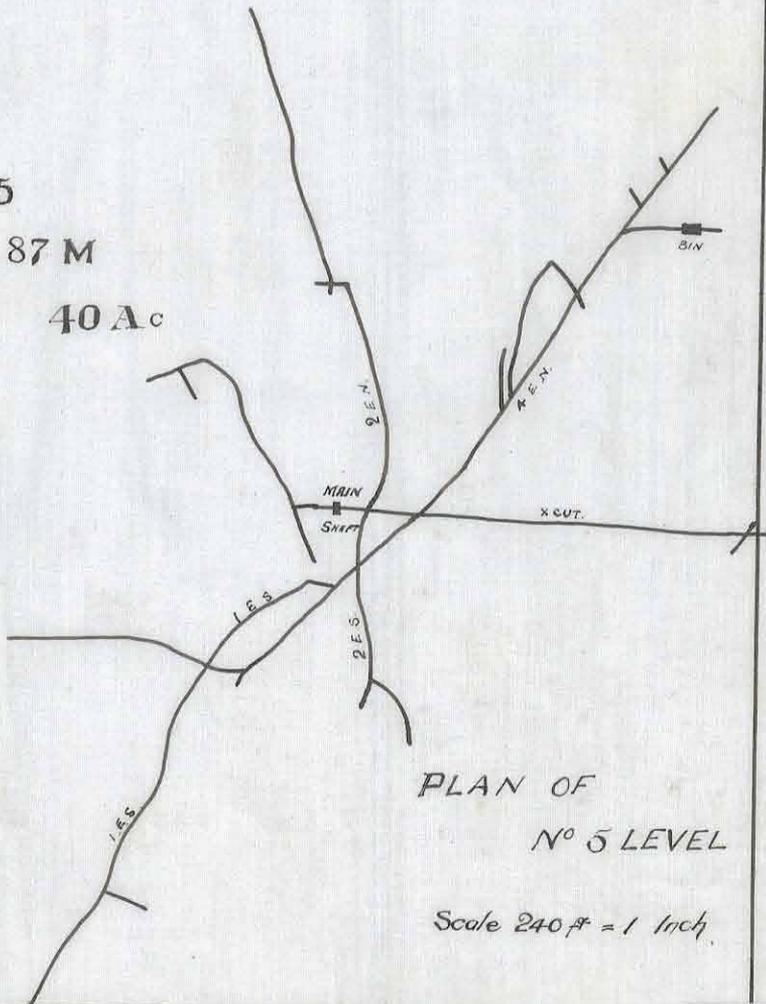

PLAN OF
N^o 5 LEVEL
Scale 240 ft = 1 inch

366-22