


5 cm

755

87 M

40 Ac

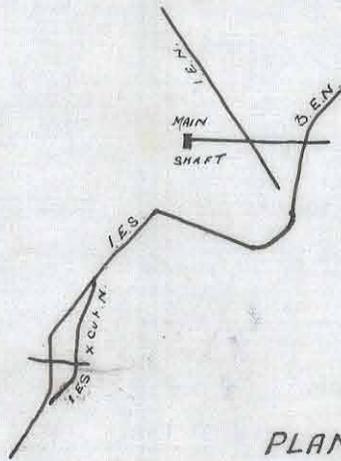

PLAN OF


NO 8 LEVEL

Scale 240' ft to 1" Inch

755

87M

40 Ac

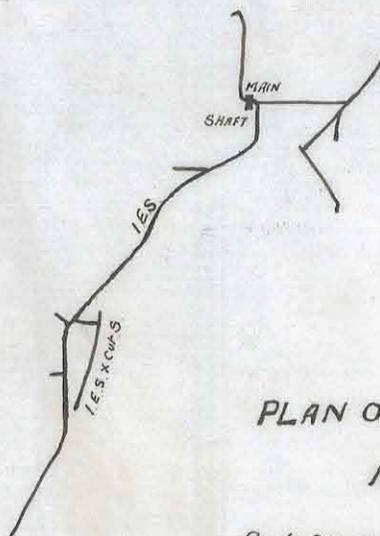

PLAN OF

NO 7 LEVEL

Scale 240' ft to 1" Inch

366

- 23