
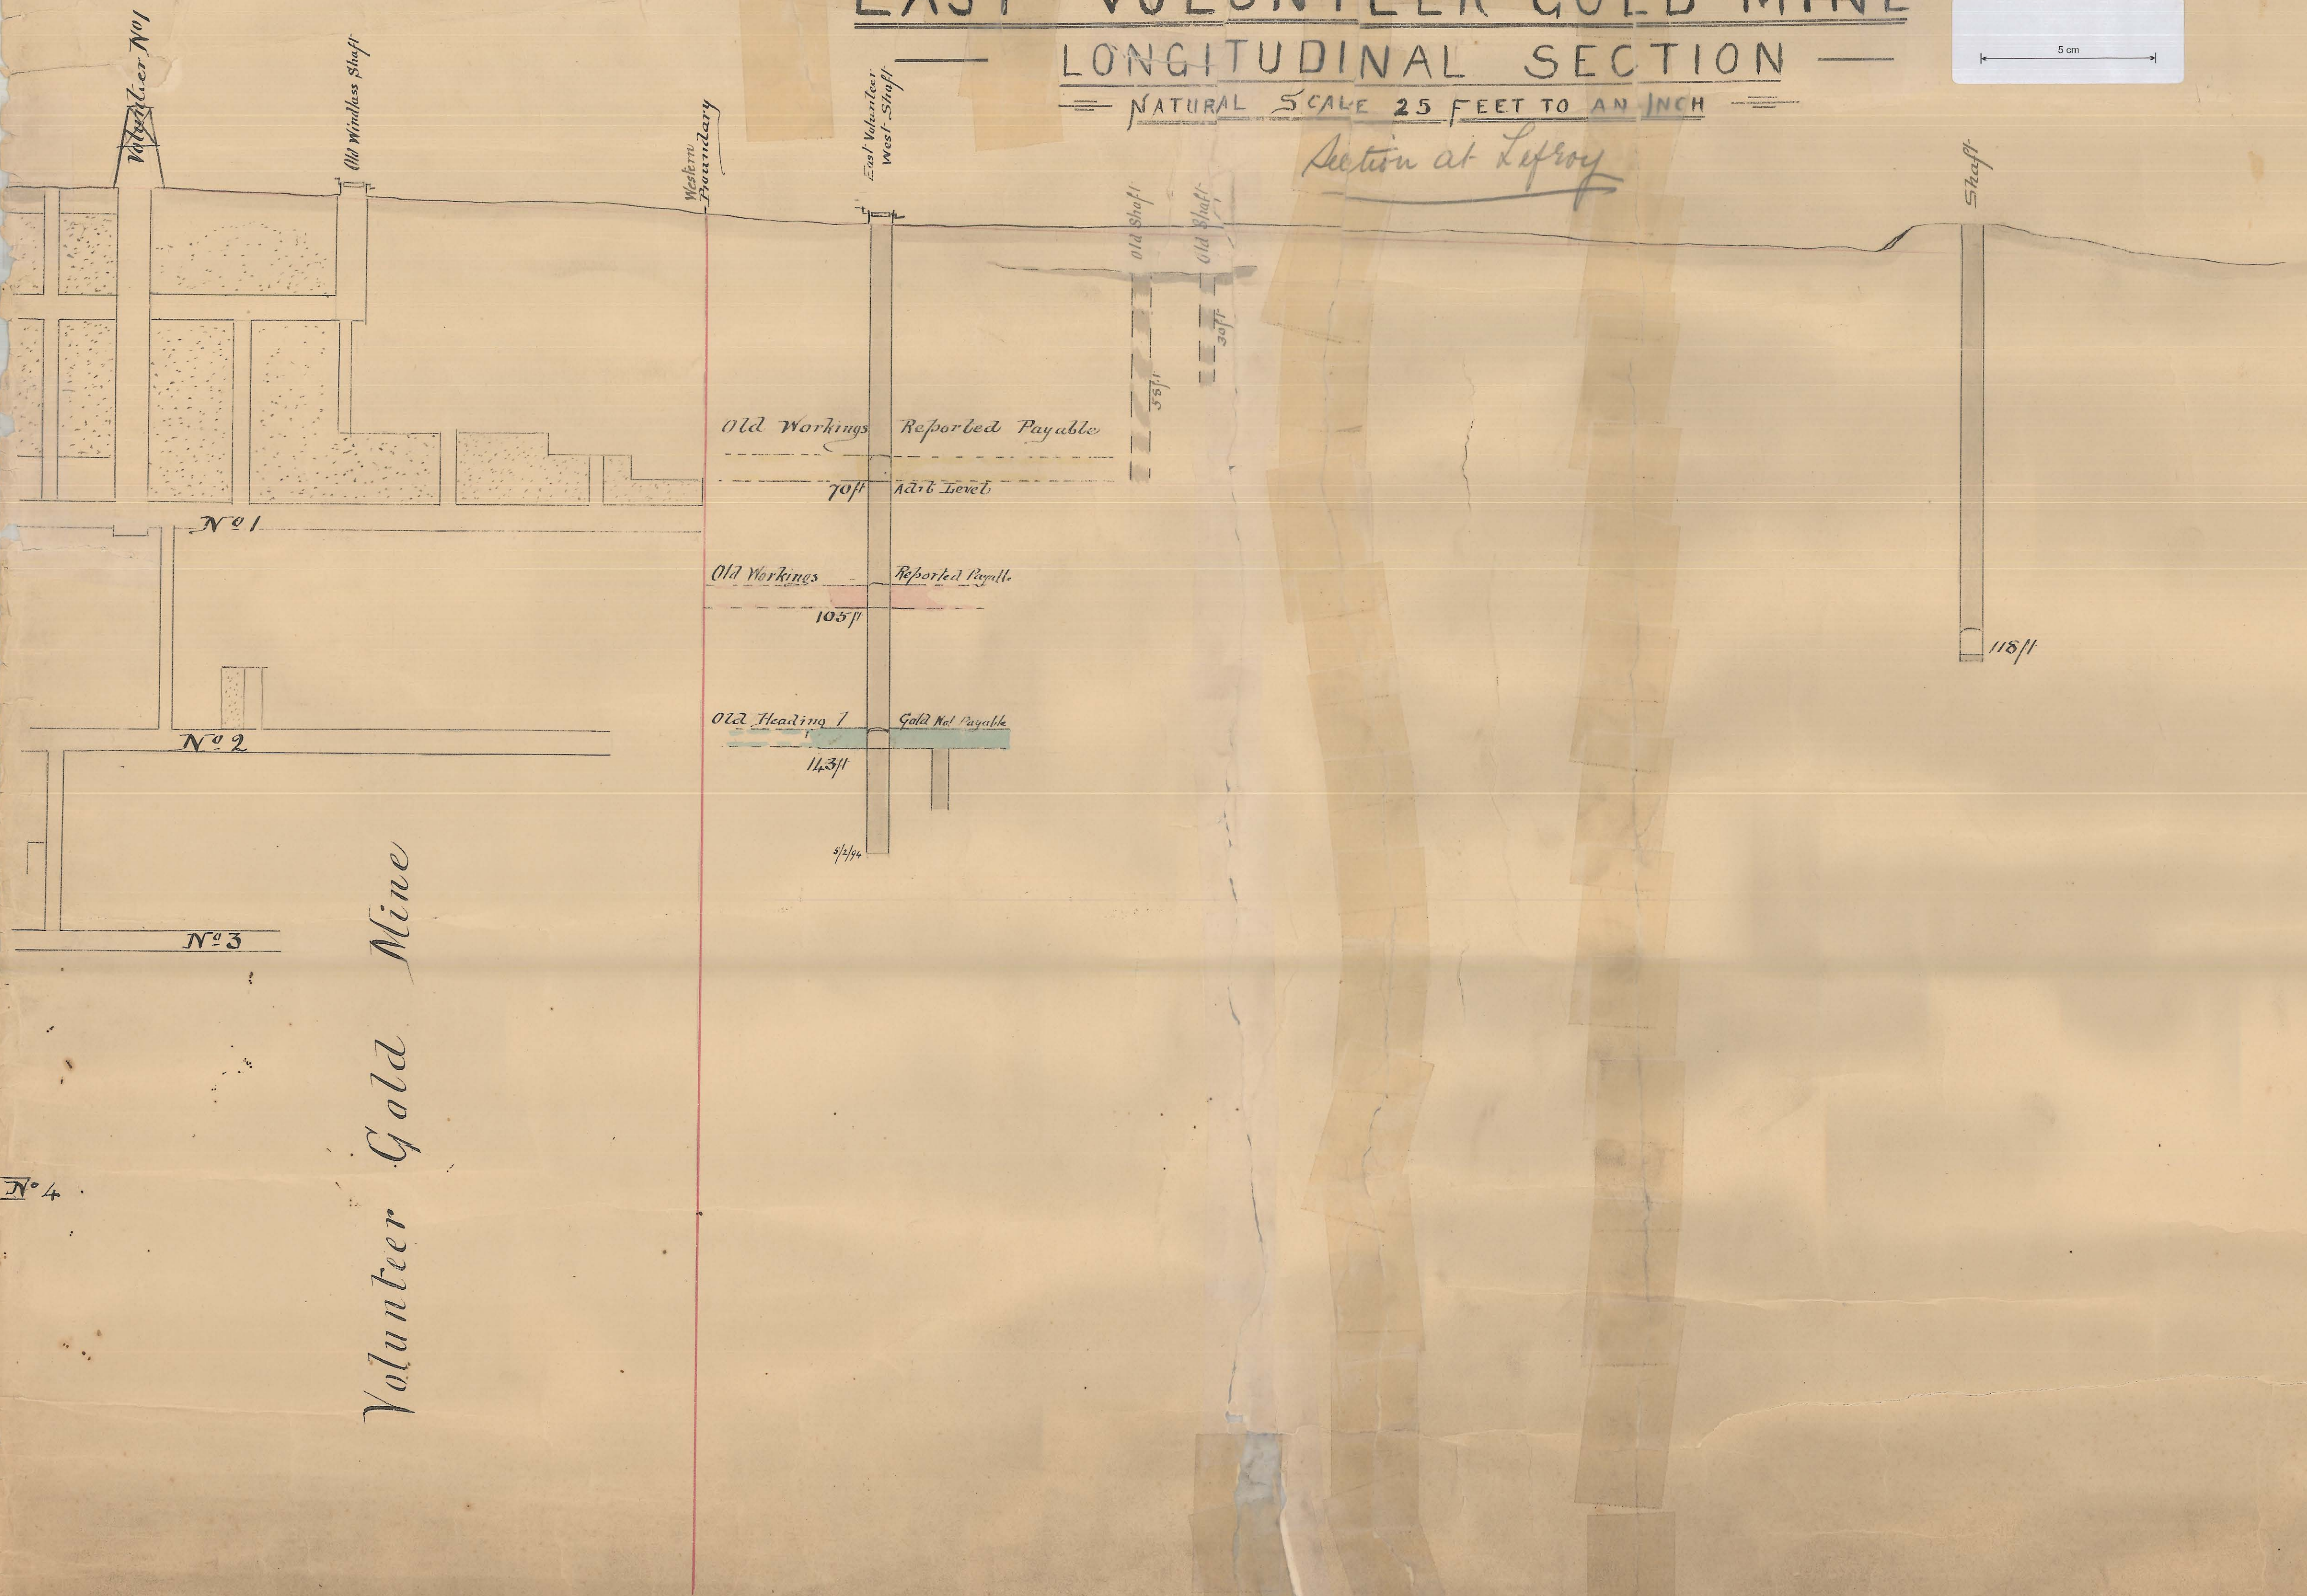


EAST VOLUNTEER GOLD MINE

LONGITUDINAL SECTION

NATURAL SCALE 25 FEET TO AN INCH

Section at Lefroy

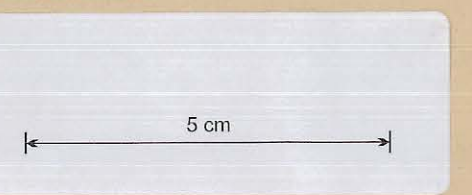

Volunteer Gold Mine