MINE WORKINGS

STATE ARGENT FLAT MINE (ZEEHAN)

Scale 2 Chns to One Inch

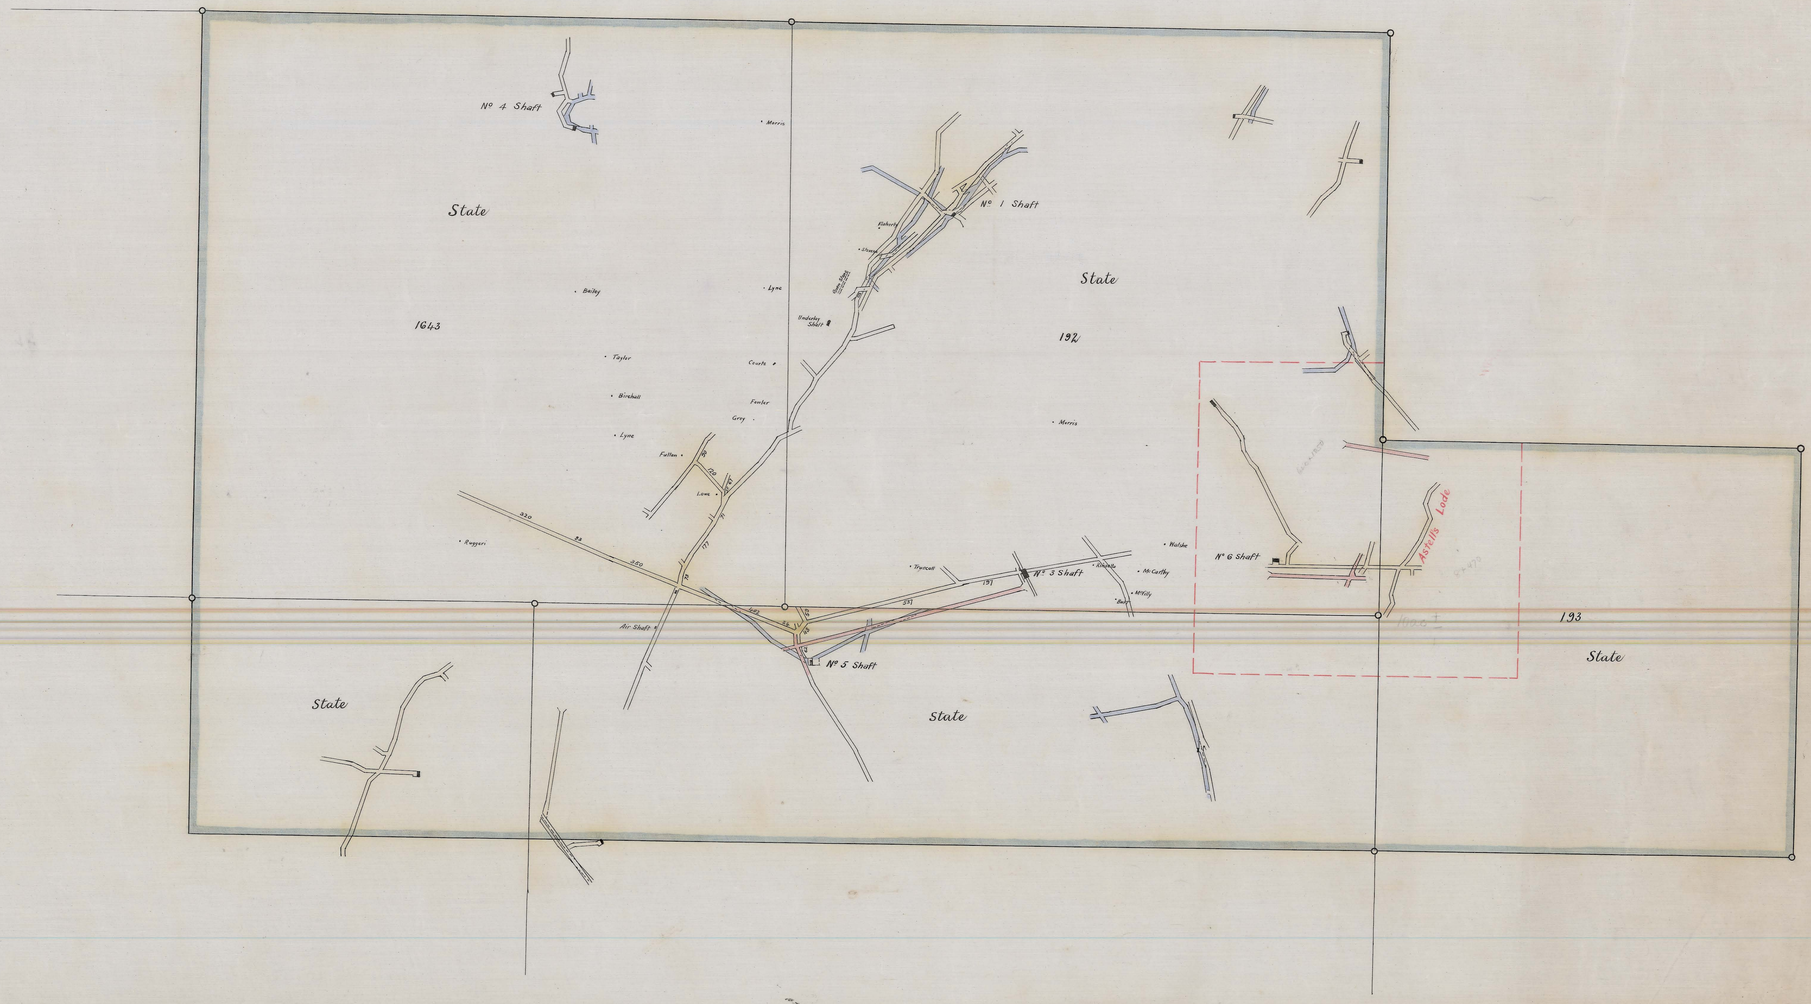

370 - 03