
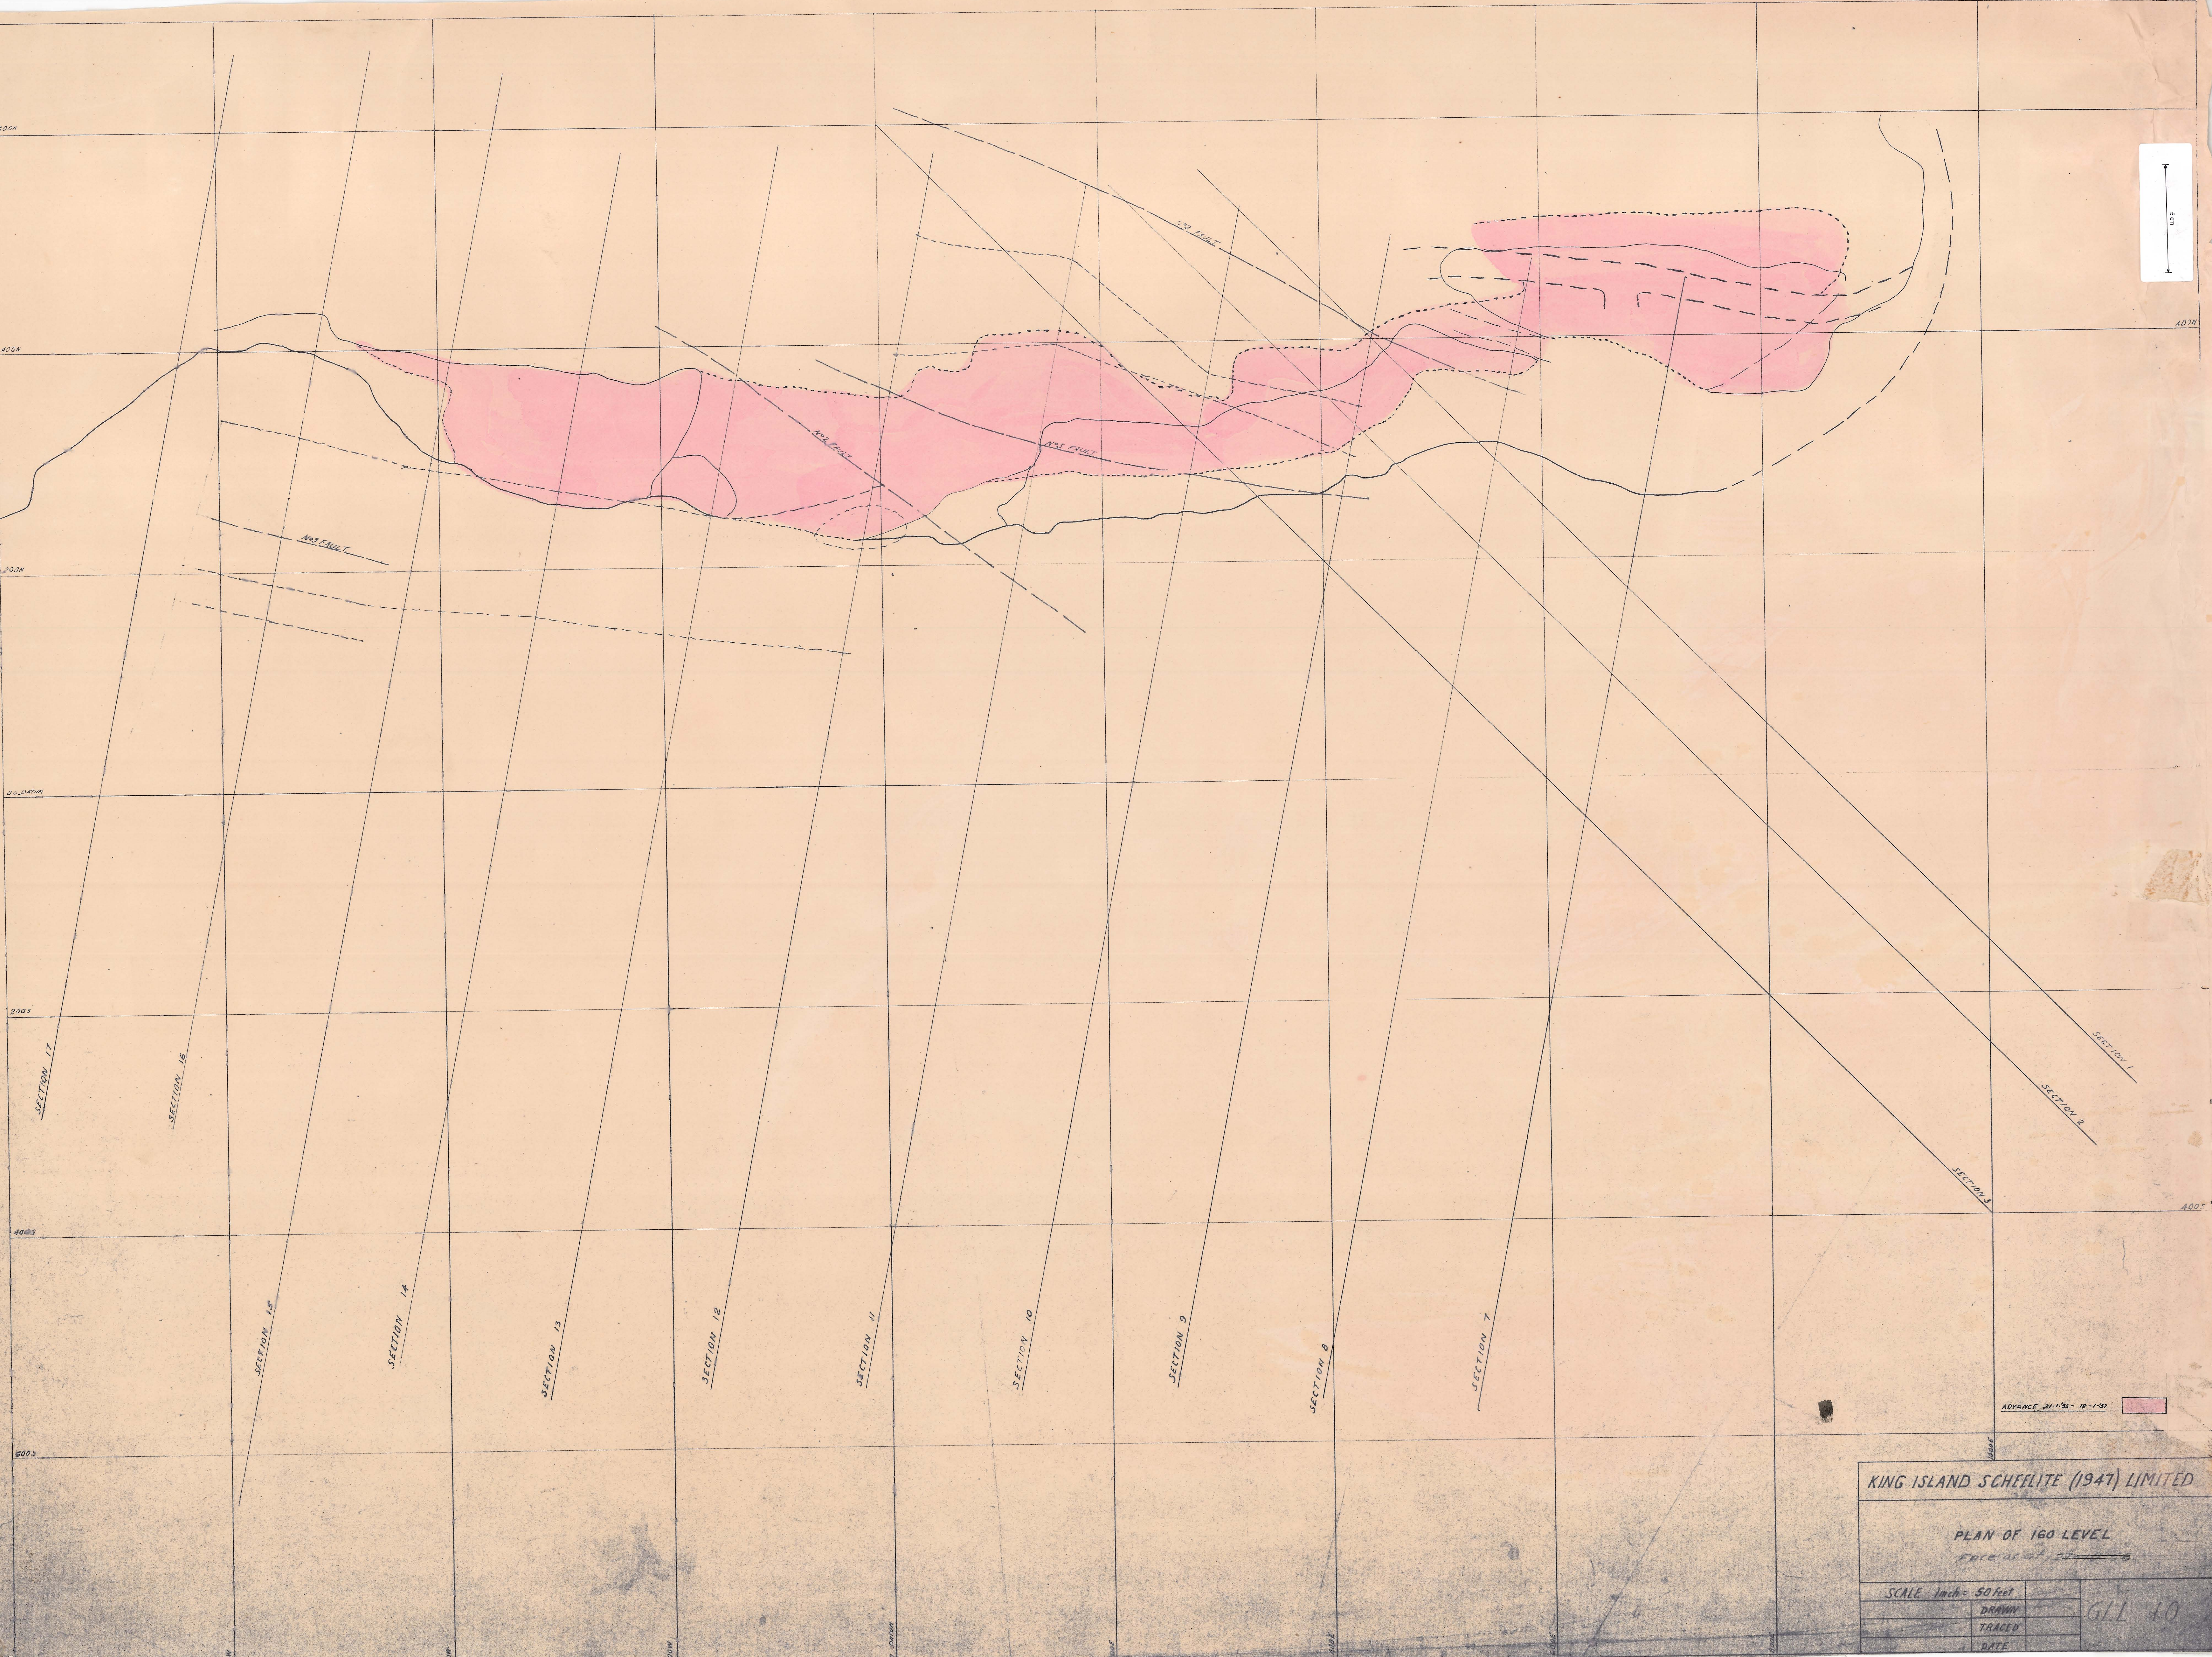


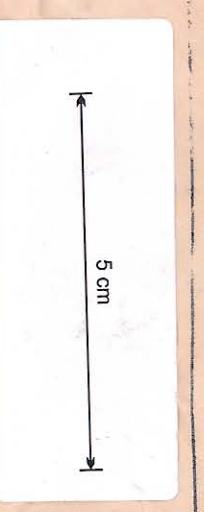

KING ISLAND SCHEELITE (1947) LIMITED

PLAN OF 160 LEVEL

Scale 1 inch = 50 feet

DRAWN	
TRACED	
DATE	

GIL 10

374
-02