


374
-10

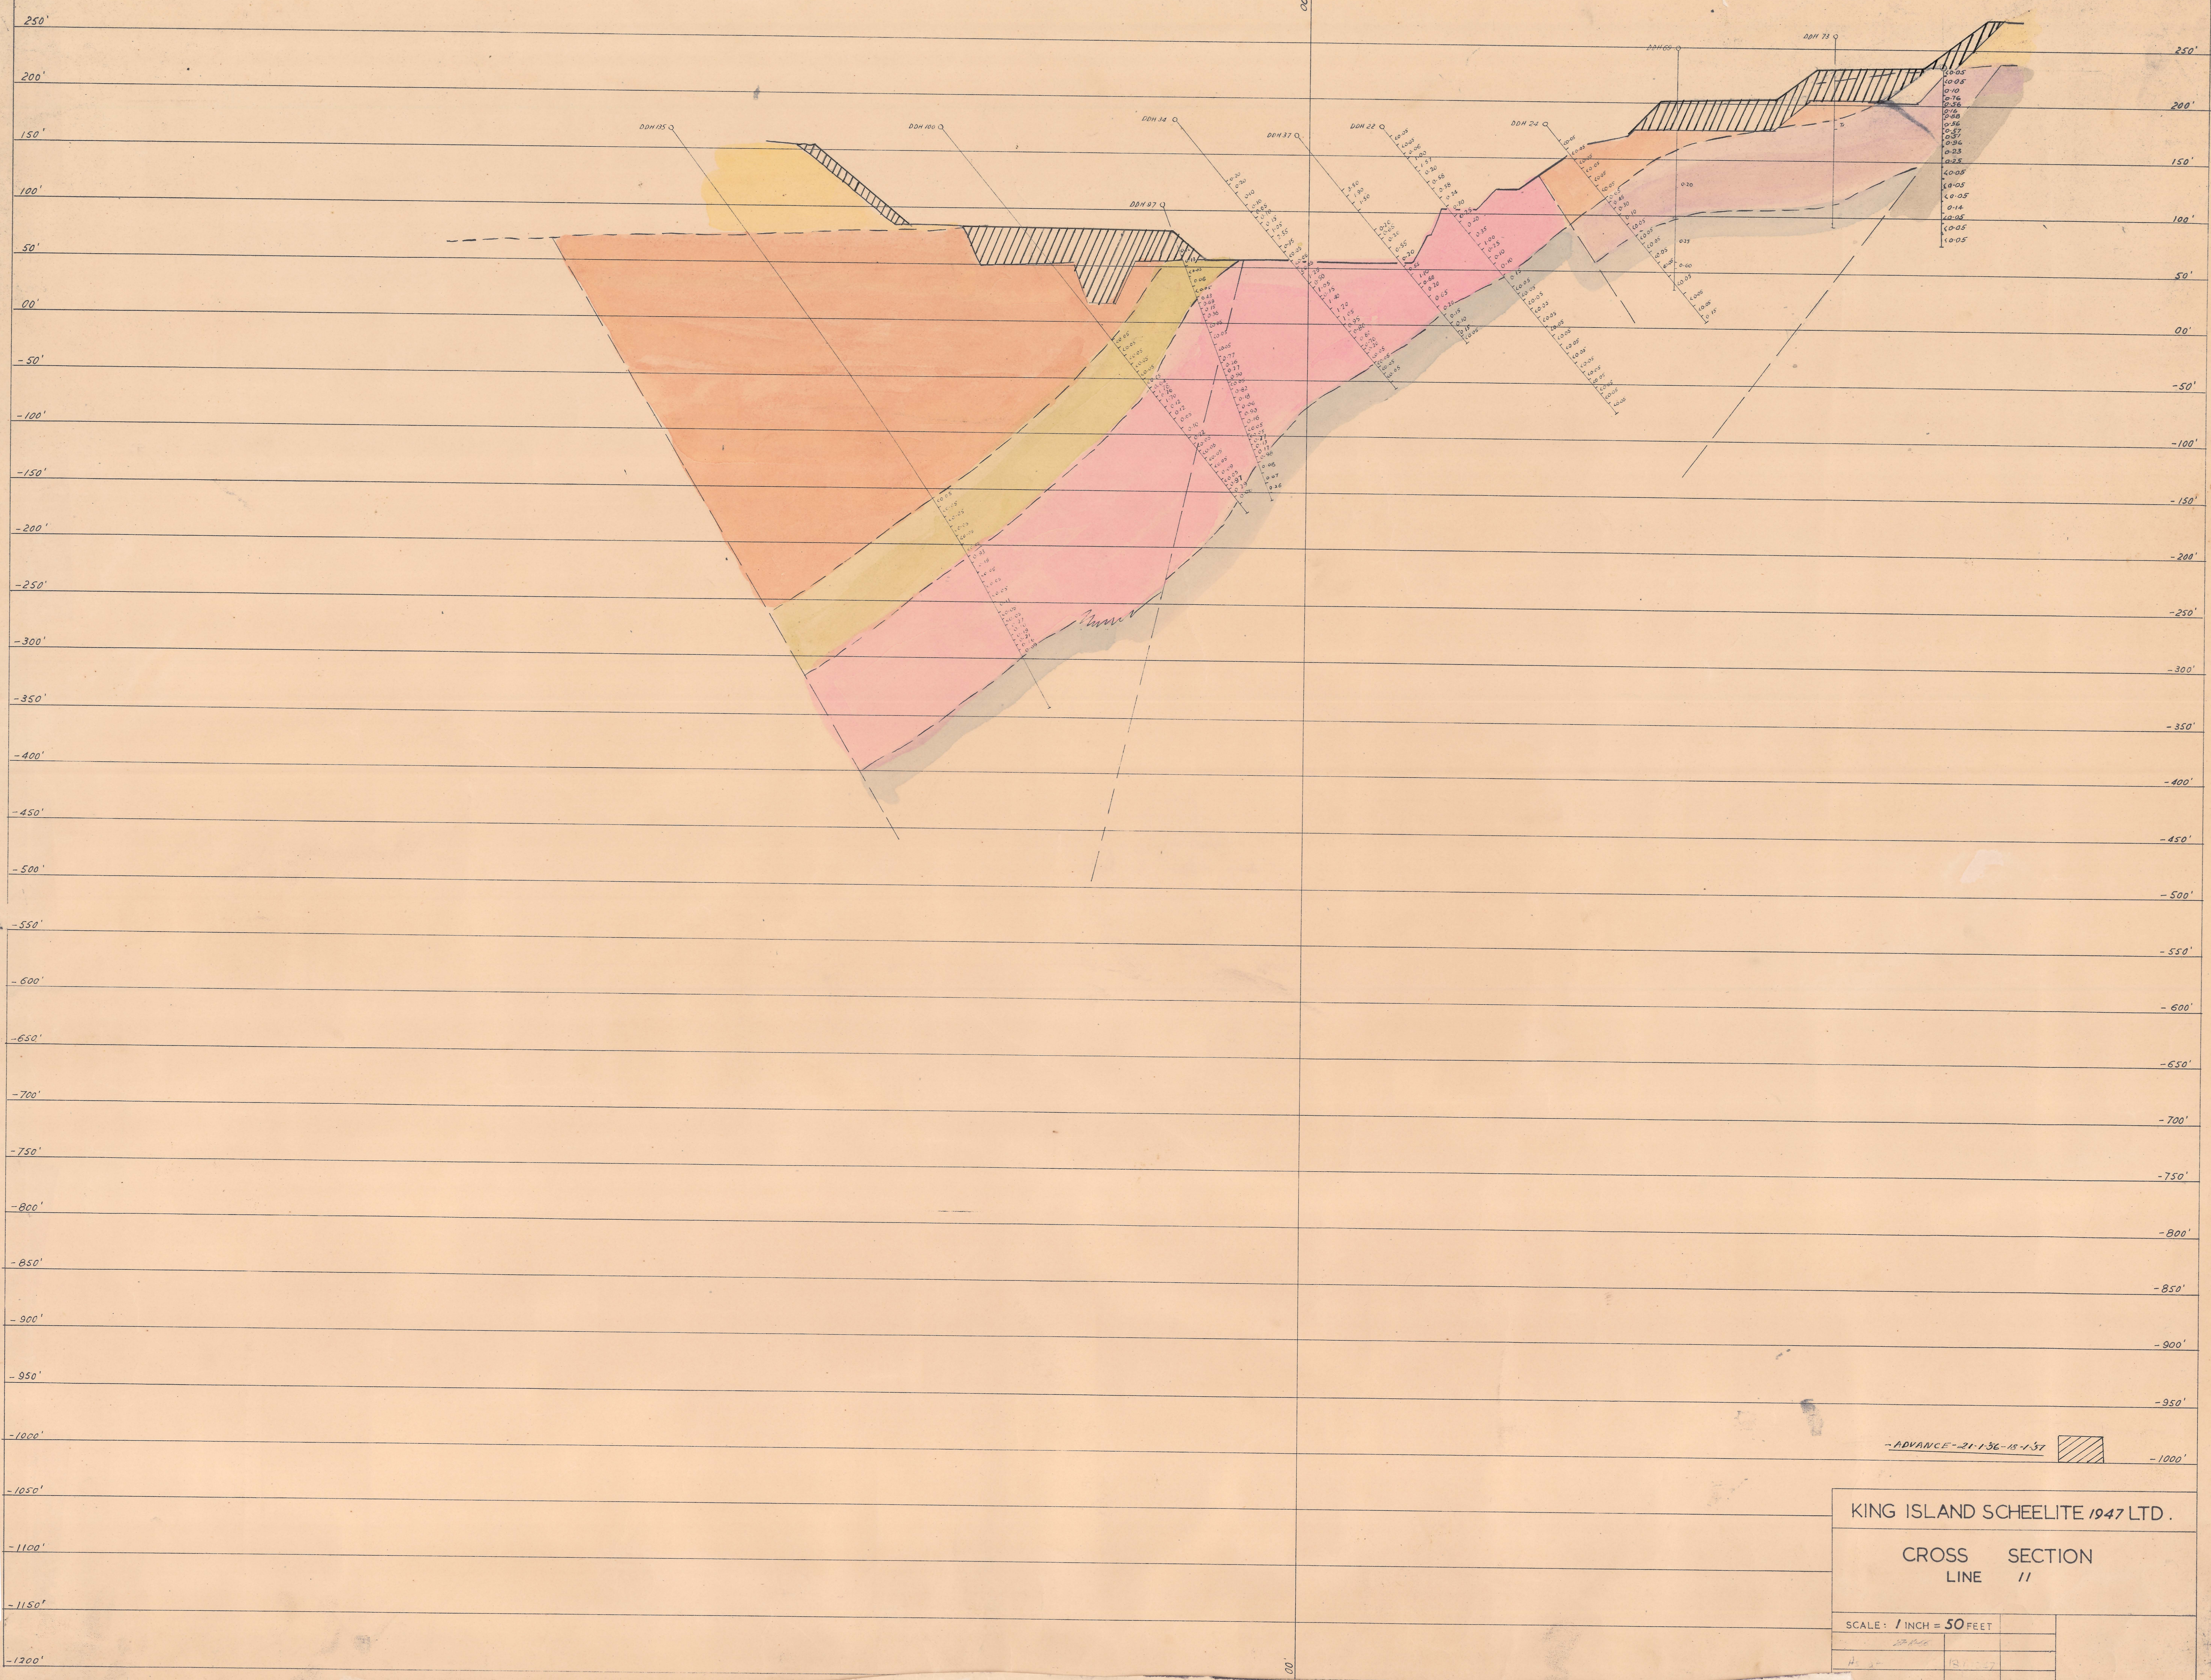

KING ISLAND SCHEELITE 1947 LTD.

CROSS SECTION
LINE II

SCALE: 1 INCH = 50 FEET

