


NORT.

37413

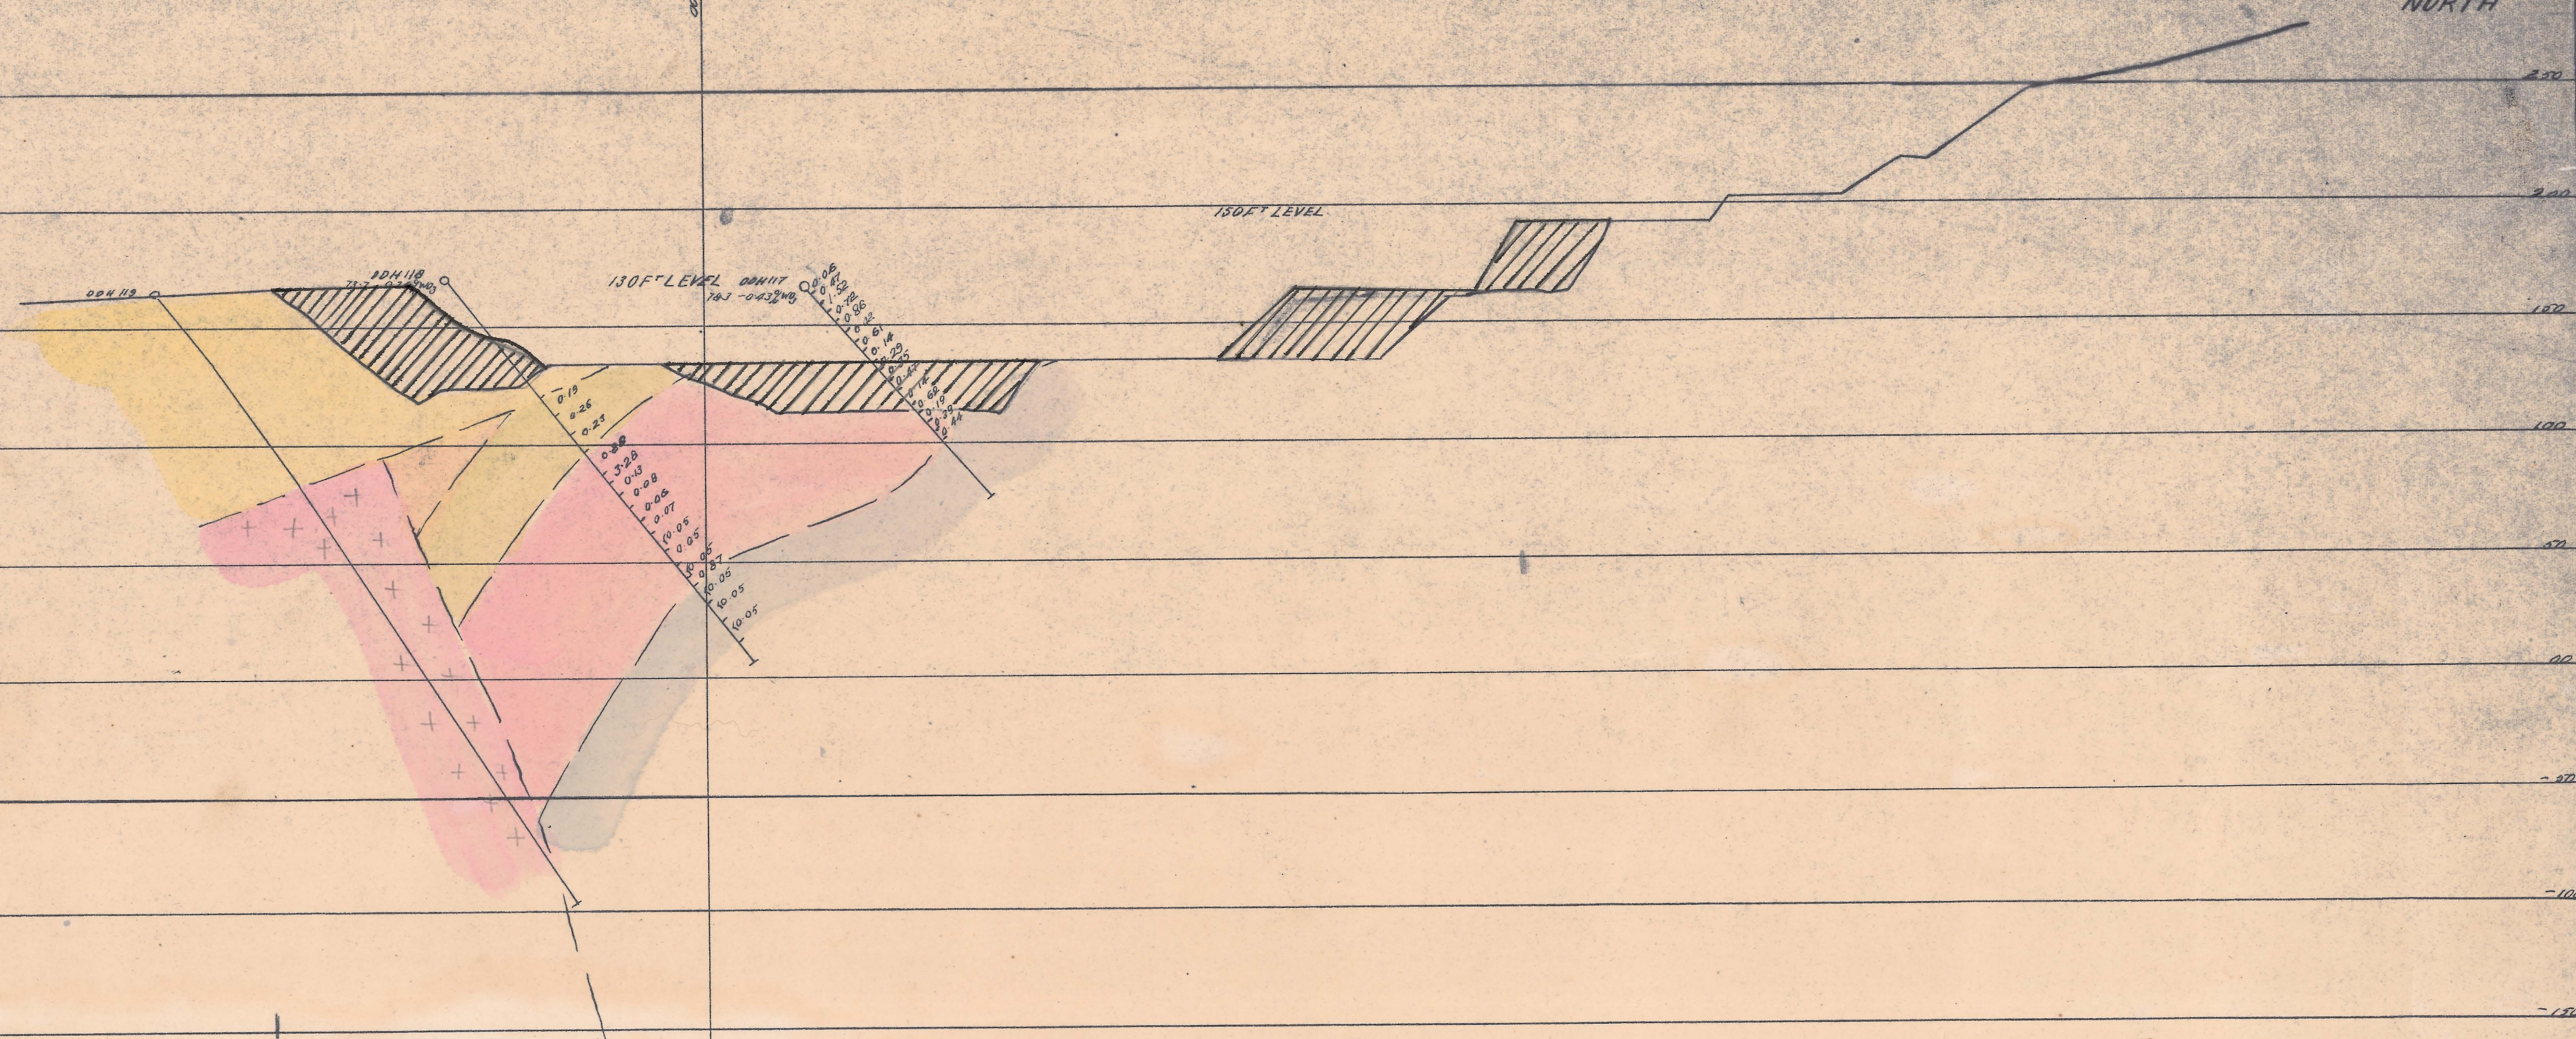

ADVANCE 21-1-'56 - 18-1-'57

KING ISLAND SCHEELITE 1947 LTD.

CROSS SECTION
LINE 17

SCALE: 1 INCH = 50 FEET

5 cm